


Common 382' = 9.6'
 Grave 1 348' = 8.7'
 Sand 0.15 x 8.3 = 1.2'
 10-14-10

10+130.00

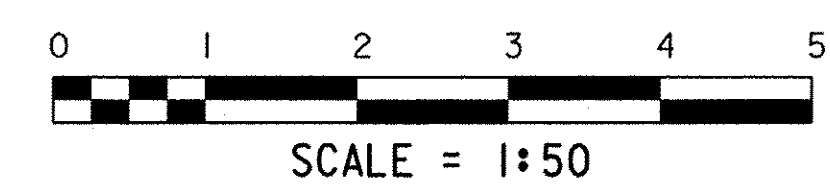

STA. 10+130 TO STA. 10+130

| | | | |
|-----------------|------------------------------|--------------|----------------|
| PROJECT NAME: | BRATTLEBORRO | PLLOT DATE: | 16-FEB-2010 |
| PROJECT NUMBER: | BRF 2000(2)S | DRAWN BY: | C. MOONEY |
| FILE NAME: | 96J228/str/sj228xs.const.dgn | DESIGNED BY: | D. PETERSON |
| | | CHECKED BY: | C. CARLSON |
| | | | SHEET 20 OF 33 |