


Common 4.1' = 10.3'  
 Gravel 2.69' = 4.7'  
 Sand 0.3' x 8.3' = 2.5'  
 RRW 10-14-10  
 for 3/25-11

F.G. = 127.726

10+135.00  
 Sand Full Depth

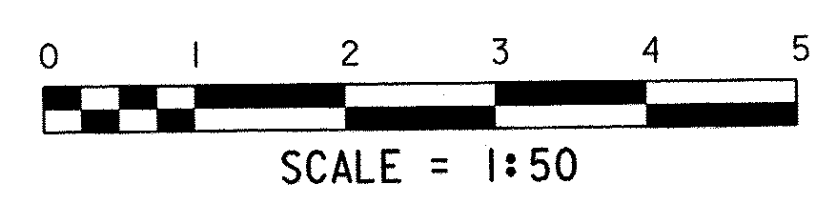

STA. 10+135 TO STA. 10+135

PROJECT NAME:	BRATTLEBORRO	PLOT DATE:	16-FEB-2010
PROJECT NUMBER:	BRF 2000(2)S	DRAWN BY:	C. MOONEY
FILE NAME:	96J228/str/sj228xs_const.dgn	CHECKED BY:	C. CARLSON
PROJECT LEADER:	C. CARLSON	ML X-SECTION 21-	(MOD.)
DESIGNED BY:	D. PETERSON	SHEET	21 OF 33