



Curvature 395' = 9.9'  
 Gravel 274' = 6.9'  
 Sand 0.3 x  $\frac{8.2}{8.3}$  = 2.5'  
 Rev 10-11-10

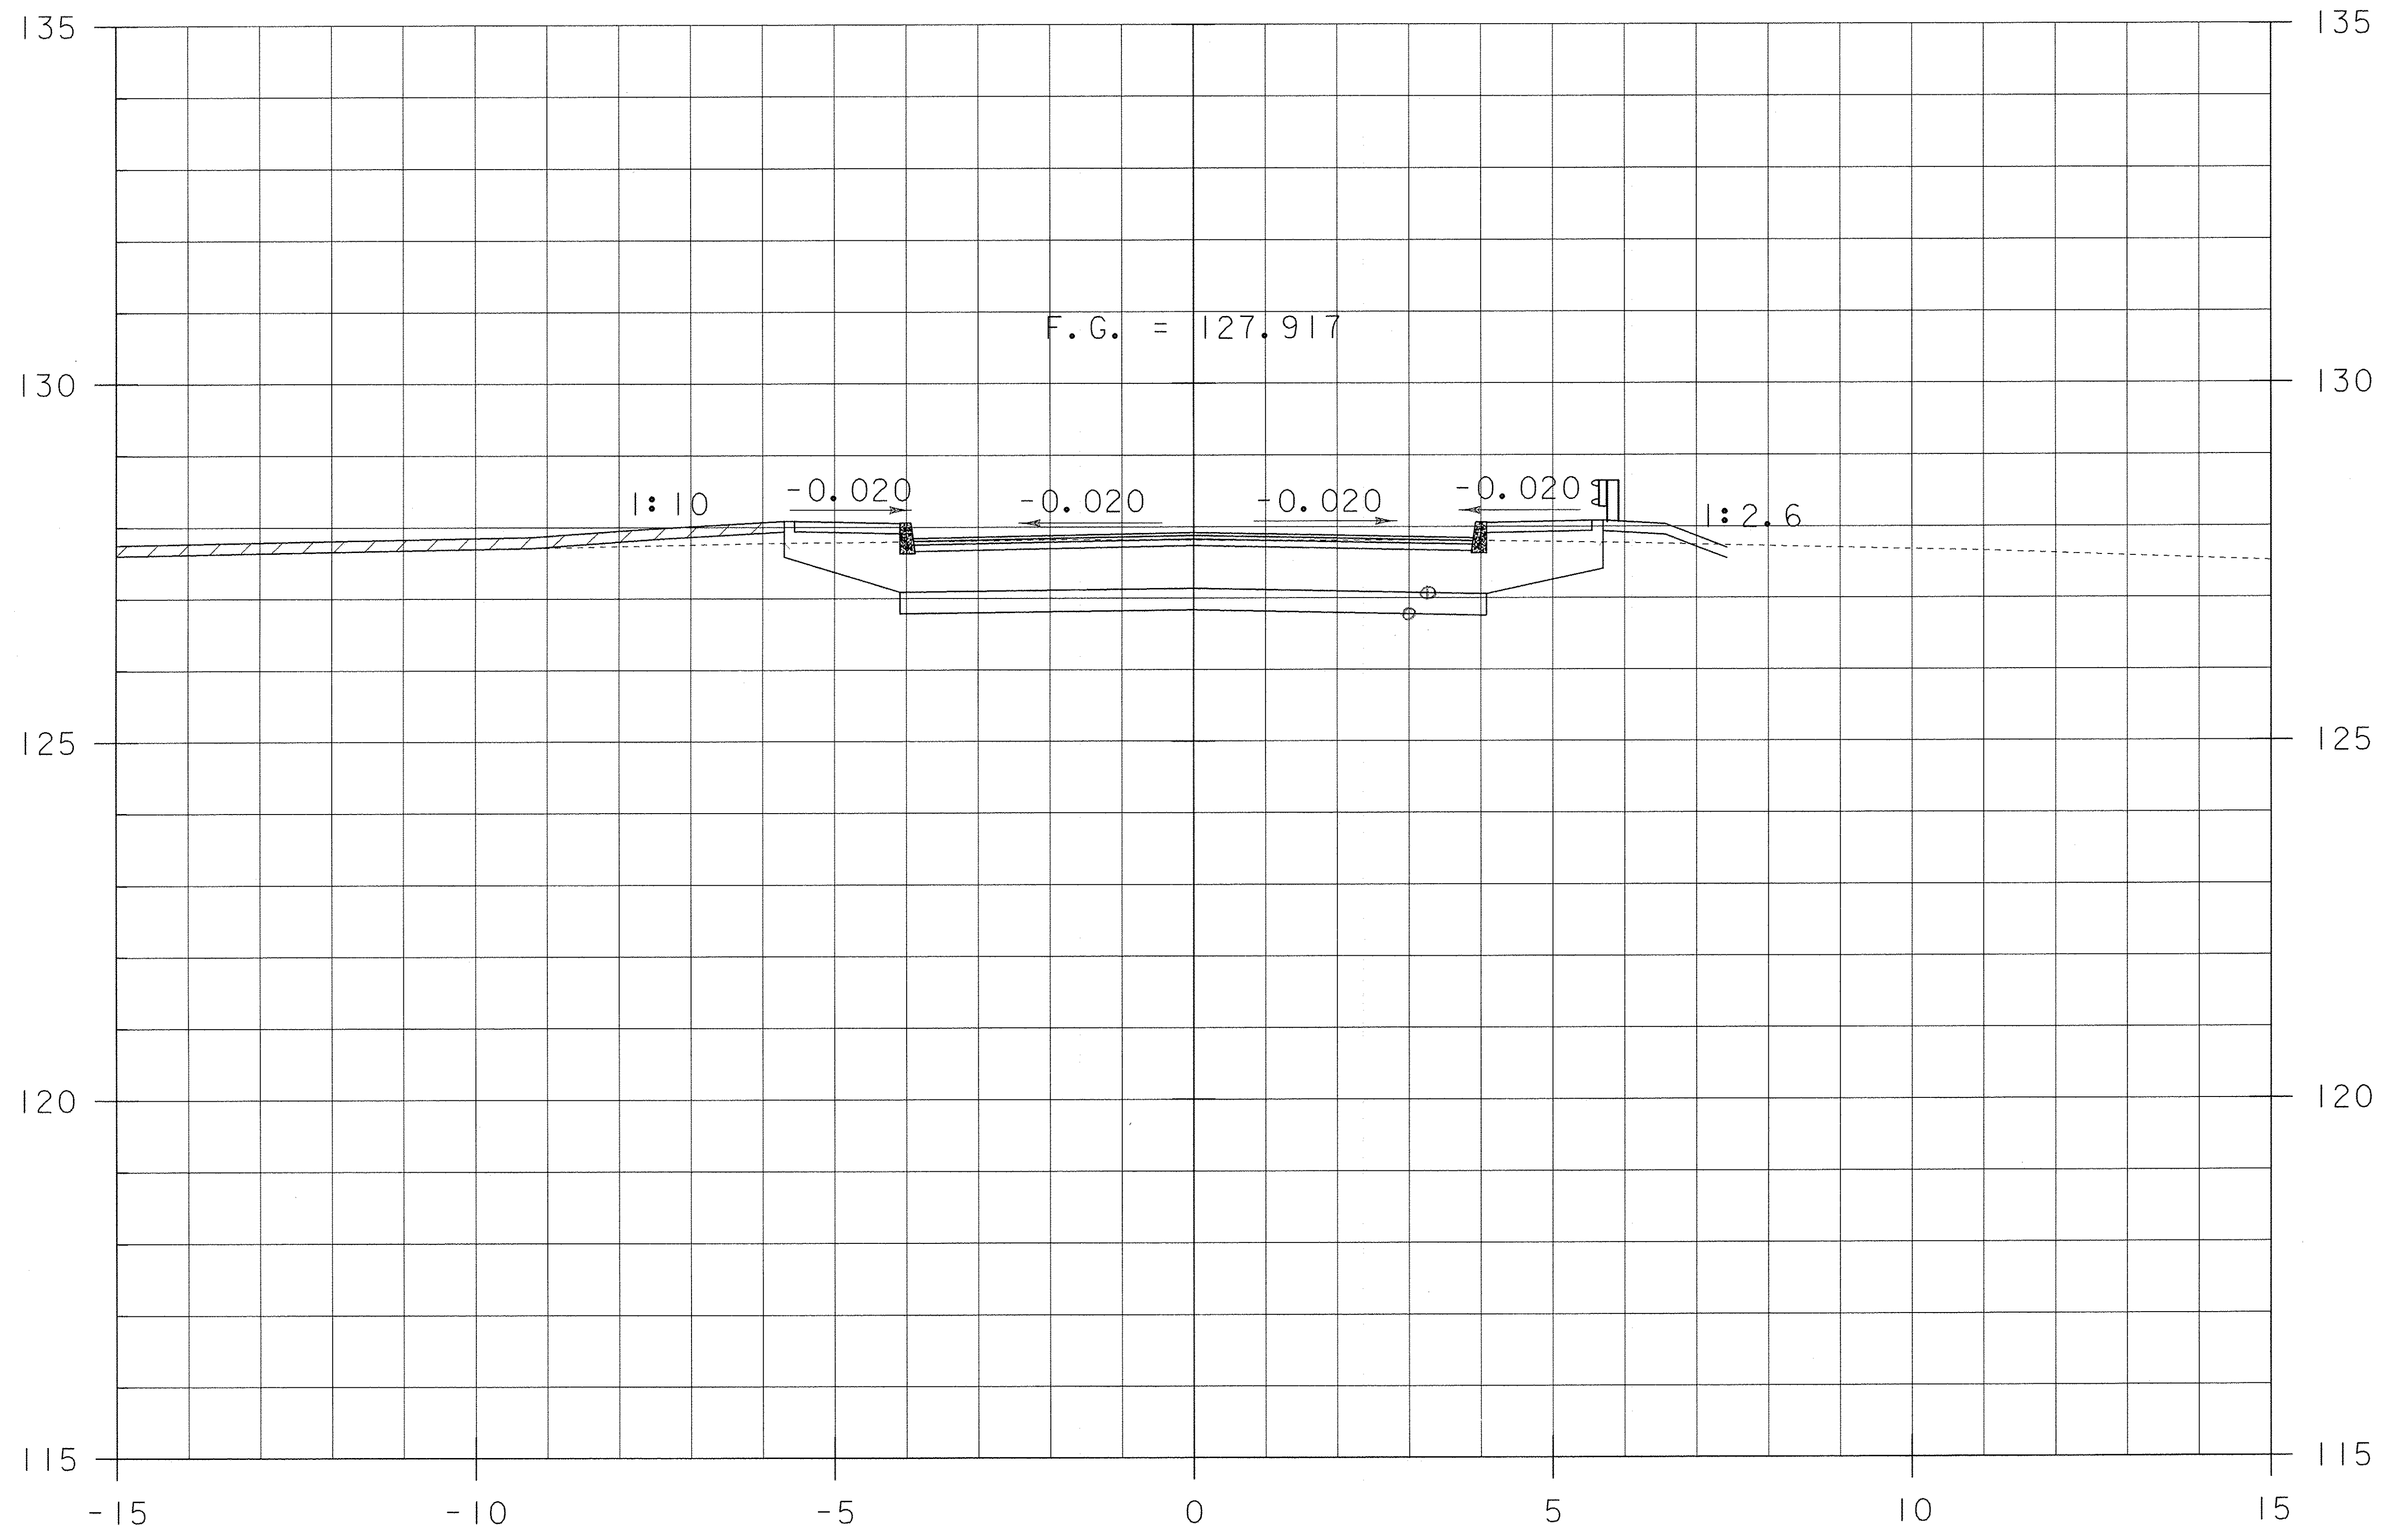

10+140.00

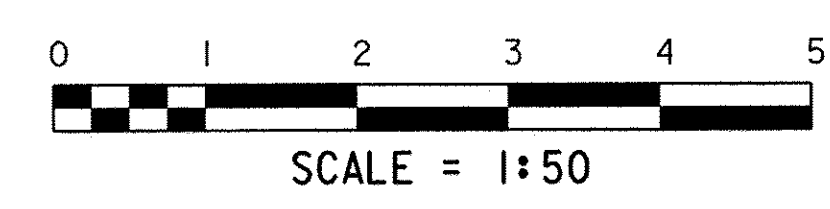

STA. 10+140 TO STA. 10+140

PROJECT NAME:	BRATTLEBORRO
PROJECT NUMBER:	BRF 2000(2)S
FILE NAME: 96J228/str/sj228xs_const.dgn	PLOT DATE: 16-FEB-2010
PROJECT LEADER: C. CARLSON	DRAWN BY: C. MOONEY
DESIGNED BY: D. PETERSON	CHECKED BY: C. CARLSON
ML X-SECTION 22 - (MOD.)	SHEET 22 OF 33