


Curban 336' = 8.4'
 Gravel 208' = 7.2'
 Sand 0.3' ^{8.2} _{8.3} = 2.5'
 1/23 10-14-10

F.G. = 128.153

1/2\"/>

10+145.00
 End Full Depth Sand-Best Tapering Up

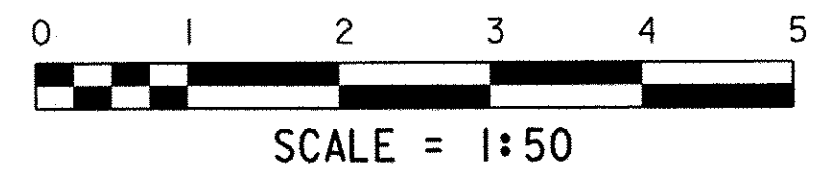

STA. 10+145.000 RT
 CONSTRUCT DRIVE

STA. 10+145 TO STA. 10+145

PROJECT NAME:	BRATTLEBORO	FILE NAME:	96J228/str/sj228xs_const.dgn	PLOT DATE:	16-FEB-2010
PROJECT NUMBER:	BRF 2000(2)S	PROJECT LEADER:	C. CARLSON	DRAWN BY:	C. MOONEY
		DESIGNED BY:	D. PETERSON	CHECKED BY:	C. CARLSON
		ML X-SECTION 23 - (MOD.)		SHEET	23 OF 33