


Common (FACE) 94 = 2.4
 (AREAS) 63 = 1.6

Gravel (FACE) 212 = 5.3
 (AREAS) 124 = 3.1
 REL. 10-14-10

FOR SW QUANTITIES SEE PAGE #

10+160.00

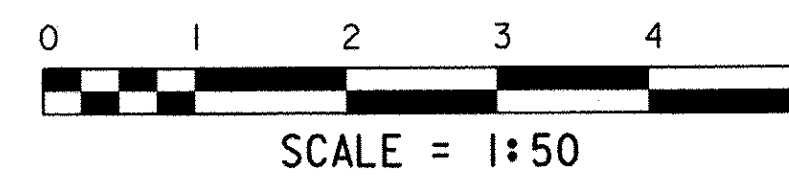

STA. 10+160 TO STA. 10+160

PROJECT NAME:	BRATTLEBORO
PROJECT NUMBER:	BRF 2000(2)S
FILE NAME:	96J228/str/sj228xs_const.dgn
PROJECT LEADER:	C. CARLSON
DESIGNED BY:	D. PETERSON
ML X-SECTION 26 - (MOD.)	
PLOT DATE:	16-FEB-2010
DRAWN BY:	C. MOONEY
CHECKED BY:	C. CARLSON
SHEET	26 OF 33