

Common 158 = 4.0  
 Gravel 85 = 2.1  
 Rev 10-14-10  
 for 3-22-11

10+168 (Butt) Common Exc. = 0.38 x 24 = 9.1  
 Gravel = 0.20 x 24 = 4.8


F.G. = MATCH EXISTING

MATCH LINE

Gravel  
(24' x 24')

STA. 10+168.024  
 END APPROACH  
 MATCH EXISTING

10+165.00

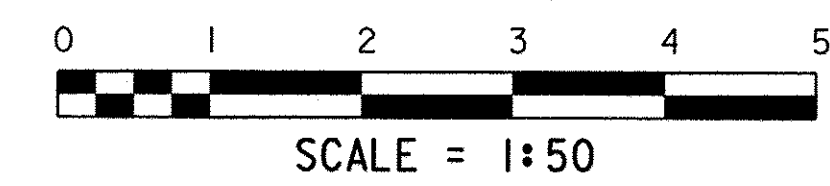

STA. 10+165 TO STA. 10+165

PROJECT NAME:	BRATTLEBORRO
PROJECT NUMBER:	BRF 2000(2)S
FILE NAME: 96J228/str/sj228xs_const.dgn	PLOT DATE: 16-FEB-2010
PROJECT LEADER: C. CARLSON	DRAWN BY: C. MOONEY
DESIGNED BY: D. PETERSON	CHECKED BY: C. CARLSON
ML X-SECTION 27 - (MOD.)	SHEET 27 OF 33