


20+005.00

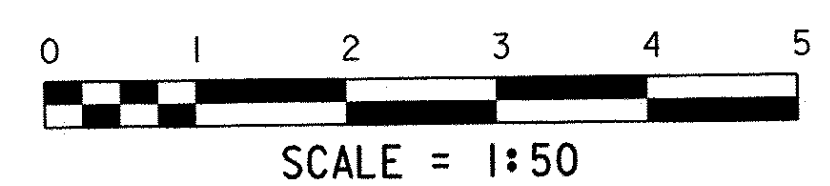

STA. 20+005 TO STA. 20+005

PROJECT NAME:	BRATTLEBORO
PROJECT NUMBER:	BRF 2000(2)S
FILE NAME:	96J228/str/sj228xs_const.dgn
PROJECT LEADER:	C. CARLSON
DESIGNED BY:	D. PETERSON
DRIVE X-SECTION 02 - (MOD.)	
PLOT DATE:	16-FEB-2010
DRAWN BY:	C. MOONEY
CHECKED BY:	C. CARLSON
SHEET	29 OF 33