


20+015.00

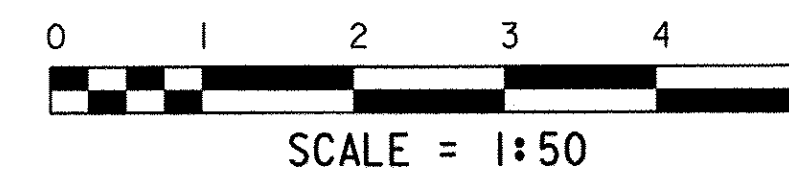

STA. 20+015 TO STA. 20+015

PROJECT NAME:	BRATTLEBORO	PLOT DATE:	16-FEB-2010
PROJECT NUMBER:	BRF 2000(2)S	DRAWN BY:	C. MOONEY
FILE NAME:	96J228/str/sj228xs_const.dgn	CHECKED BY:	C. CARLSON
PROJECT LEADER:	C. CARLSON	SHEET	31 OF 33
DESIGNED BY:	D. PETERSON		
DRIVE X-SECTION	04 - (MOD.)		