


STA. 20+024.00, 2.5m RT.  
 END DRIVE CONSTRUCTION  
 MATCH EXISTING GRADE

20+020.00

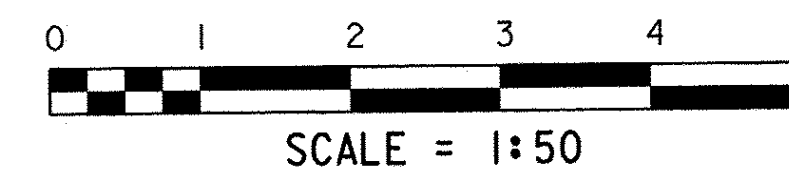

STA. 20+020 TO STA. 20+020

PROJECT NAME: BRATTLEBORRO	PLOT DATE: 16-FEB-2010
PROJECT NUMBER: BRF 2000(2)S	DRAWN BY: C. MOONEY
FILE NAME: 96J228/str/sj228xs_const.dgn	CHECKED BY: C. CARLSON
PROJECT LEADER: C. CARLSON	SHEET 32 OF 33
DESIGNED BY: D. PETERSON	
DRIVE X-SECTION 05 - (MOD.)	