
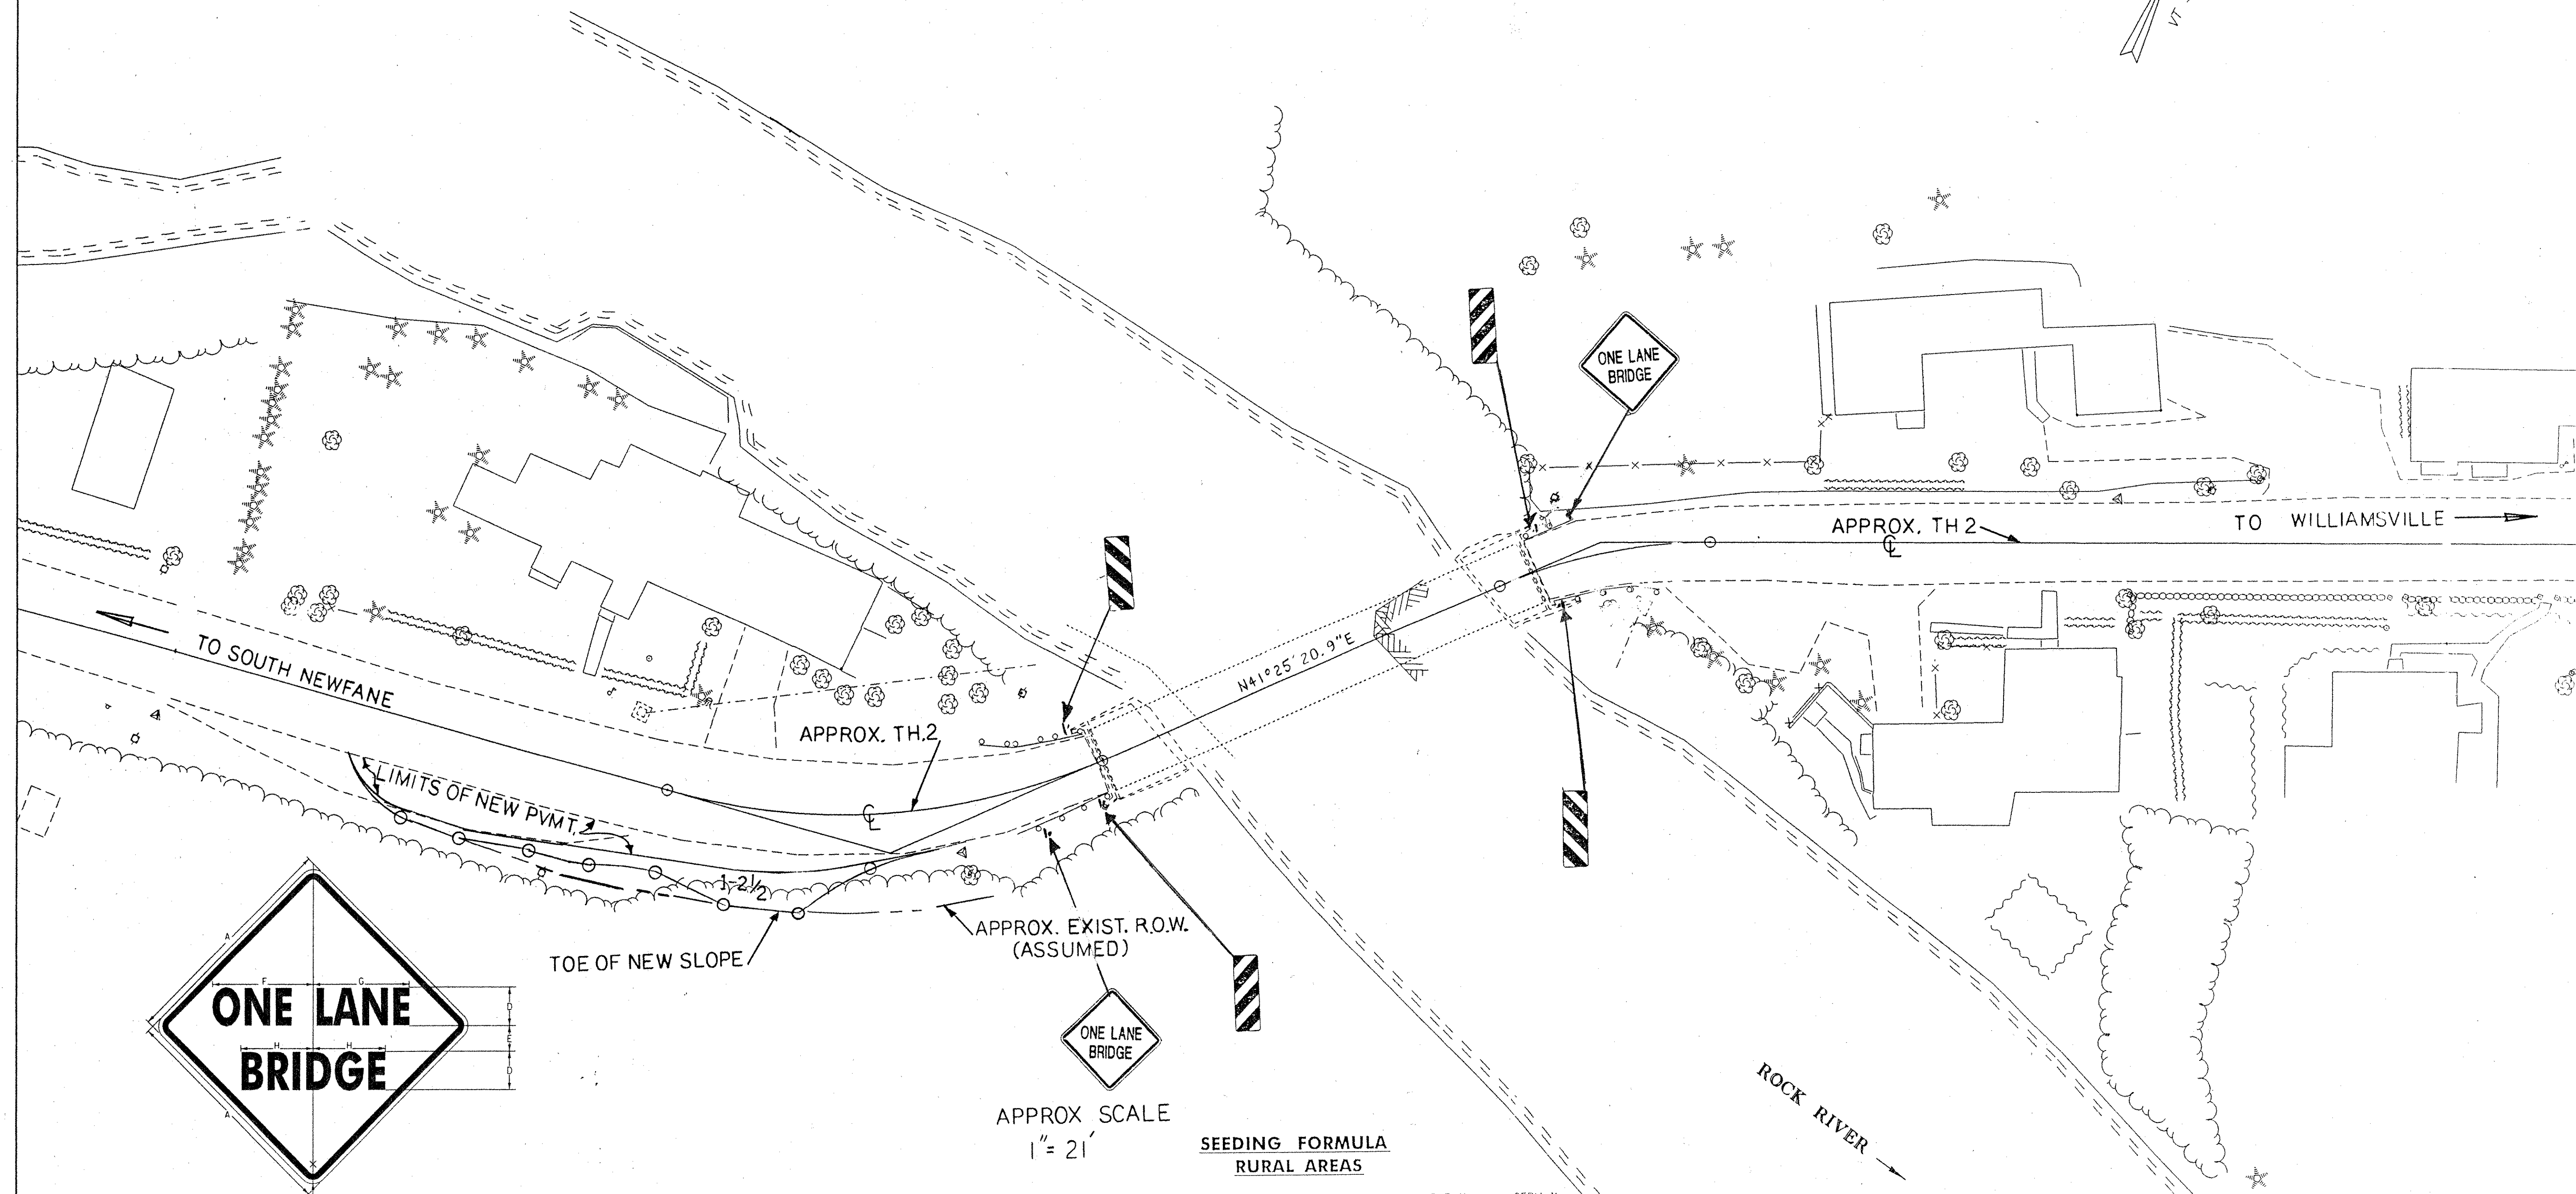


**REMOVE AND RESET GUARDRAIL**

EAST APPROACH LT. 28'  
 EAST APPROACH RT. 15'  
 WEST APPROACH LT. 26'  
 WEST APPROACH RT. 26'

**SIGNS, FLANGED SIGN POST**

EAST RT. ONE LANE BRIDGE SIGN  
 EAST RT. OBJECT MARKER SIGN  
 EAST LT. OBJECT MARKER SIGN  
 WEST LT. ONE LANE BRIDGE SIGN  
 WEST RT. OBJECT MARKER SIGN  
 WEST LT. OBJECT MARKER SIGN

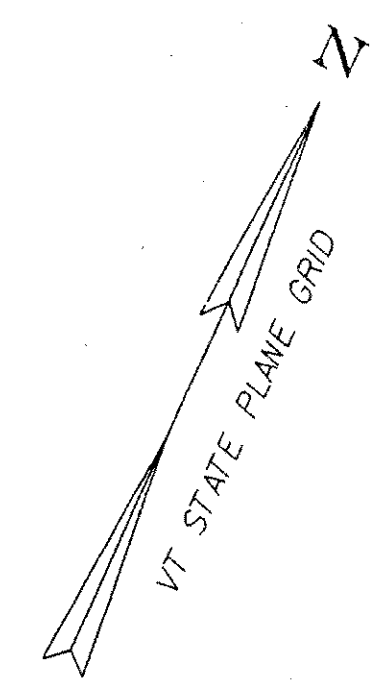

SIGN	DIMENSIONS (INCHES)									
	A	B	C	D	E	F	G	H	I	J
MIN.	30	1/2	3/4	5C	3/4	13 5/16	12 1/16	9 1/8	1 7/8	
STD.	36	5/8	7/8	6C	4	16	15 1/4	11 1/2	2 1/4	
SPECIAL	48	3/4	1 1/4	8C	5	21 1/4	20 1/4	15 3/8	3	

**COLORS**  
 LEGEND-BLACK (NON - REFL)  
 BACKGROUND - YELLOW (REFL)

<b>DATUM</b>	
VERTICAL	NAVD88
HORIZONTAL	NAD83 (92)

% WT.	LBS./A.	NAME	PUR %	GERM %
37.5	22.5	CREeping RED FESCUE	98	85
37.5	22.5	TALL FESCUE	95	90
5.0	3.0	RED TOP	95	90
15.0	9.0	BIRDSFOOT TREFoil	98	85
5.0	3.0	ANNUAL RYEGRASS	95	85
100.0	60.0			

**GENERAL NOTES**

SEED MIXTURE: SHALL NOT HAVE A WEED CONTENT EXCEEDING 0.40% BY WEIGHT AND SHALL BE FREE OF ALL NOXIOUS SEED.

SEED: TO BE APPLIED PER SEEDING FORMULAS OR AS DIRECTED BY THE ENGINEER.

FERTILIZER: FORMULA 10-20-10, TO BE USED WITH SEED, APPLIED AT THE RATE OF 500 LBS./ACRE. (HYDRO SEEDERS MAY USE 19-19-19 FORMULA).

AGRICULTURAL LIMESTONE: TO BE APPLIED AT THE RATE OF 2 TONS/ACRE, OR AS DIRECTED BY THE ENGINEER.

HAY MULCH: TO BE PLACED ON EARTH SLOPES AT THE RATE OF 2 TONS/ACRE, OR AS DIRECTED BY THE ENGINEER.

TOPSOIL: TO BE USED WITH SEED AS INDICATED ON THE PLANS, OR AS DIRECTED BY THE ENGINEER.

<b>PROJECT:</b> NEWFANE	<b>PROJECT NO.:</b> BHF 0106 (4)S
DESIGN FILE NAME: c:\USERS\STR3\96J230\sj230bdr.dgn	PLOT DATE: 30-JUN-1998
IPARM FILE NAME: sj230i02.i	SURVEY DATE: APRIL 1998
SURVEYED BY: R.D. GILMAN	DRAWN BY:
SQUAD LEADER:	SHEET: 4 OF 8