


ELEVATION @ INSIDE FACE OF MAIN BEAM (LOOKING NORTH)
SCALE 3/8" = 1'-0"

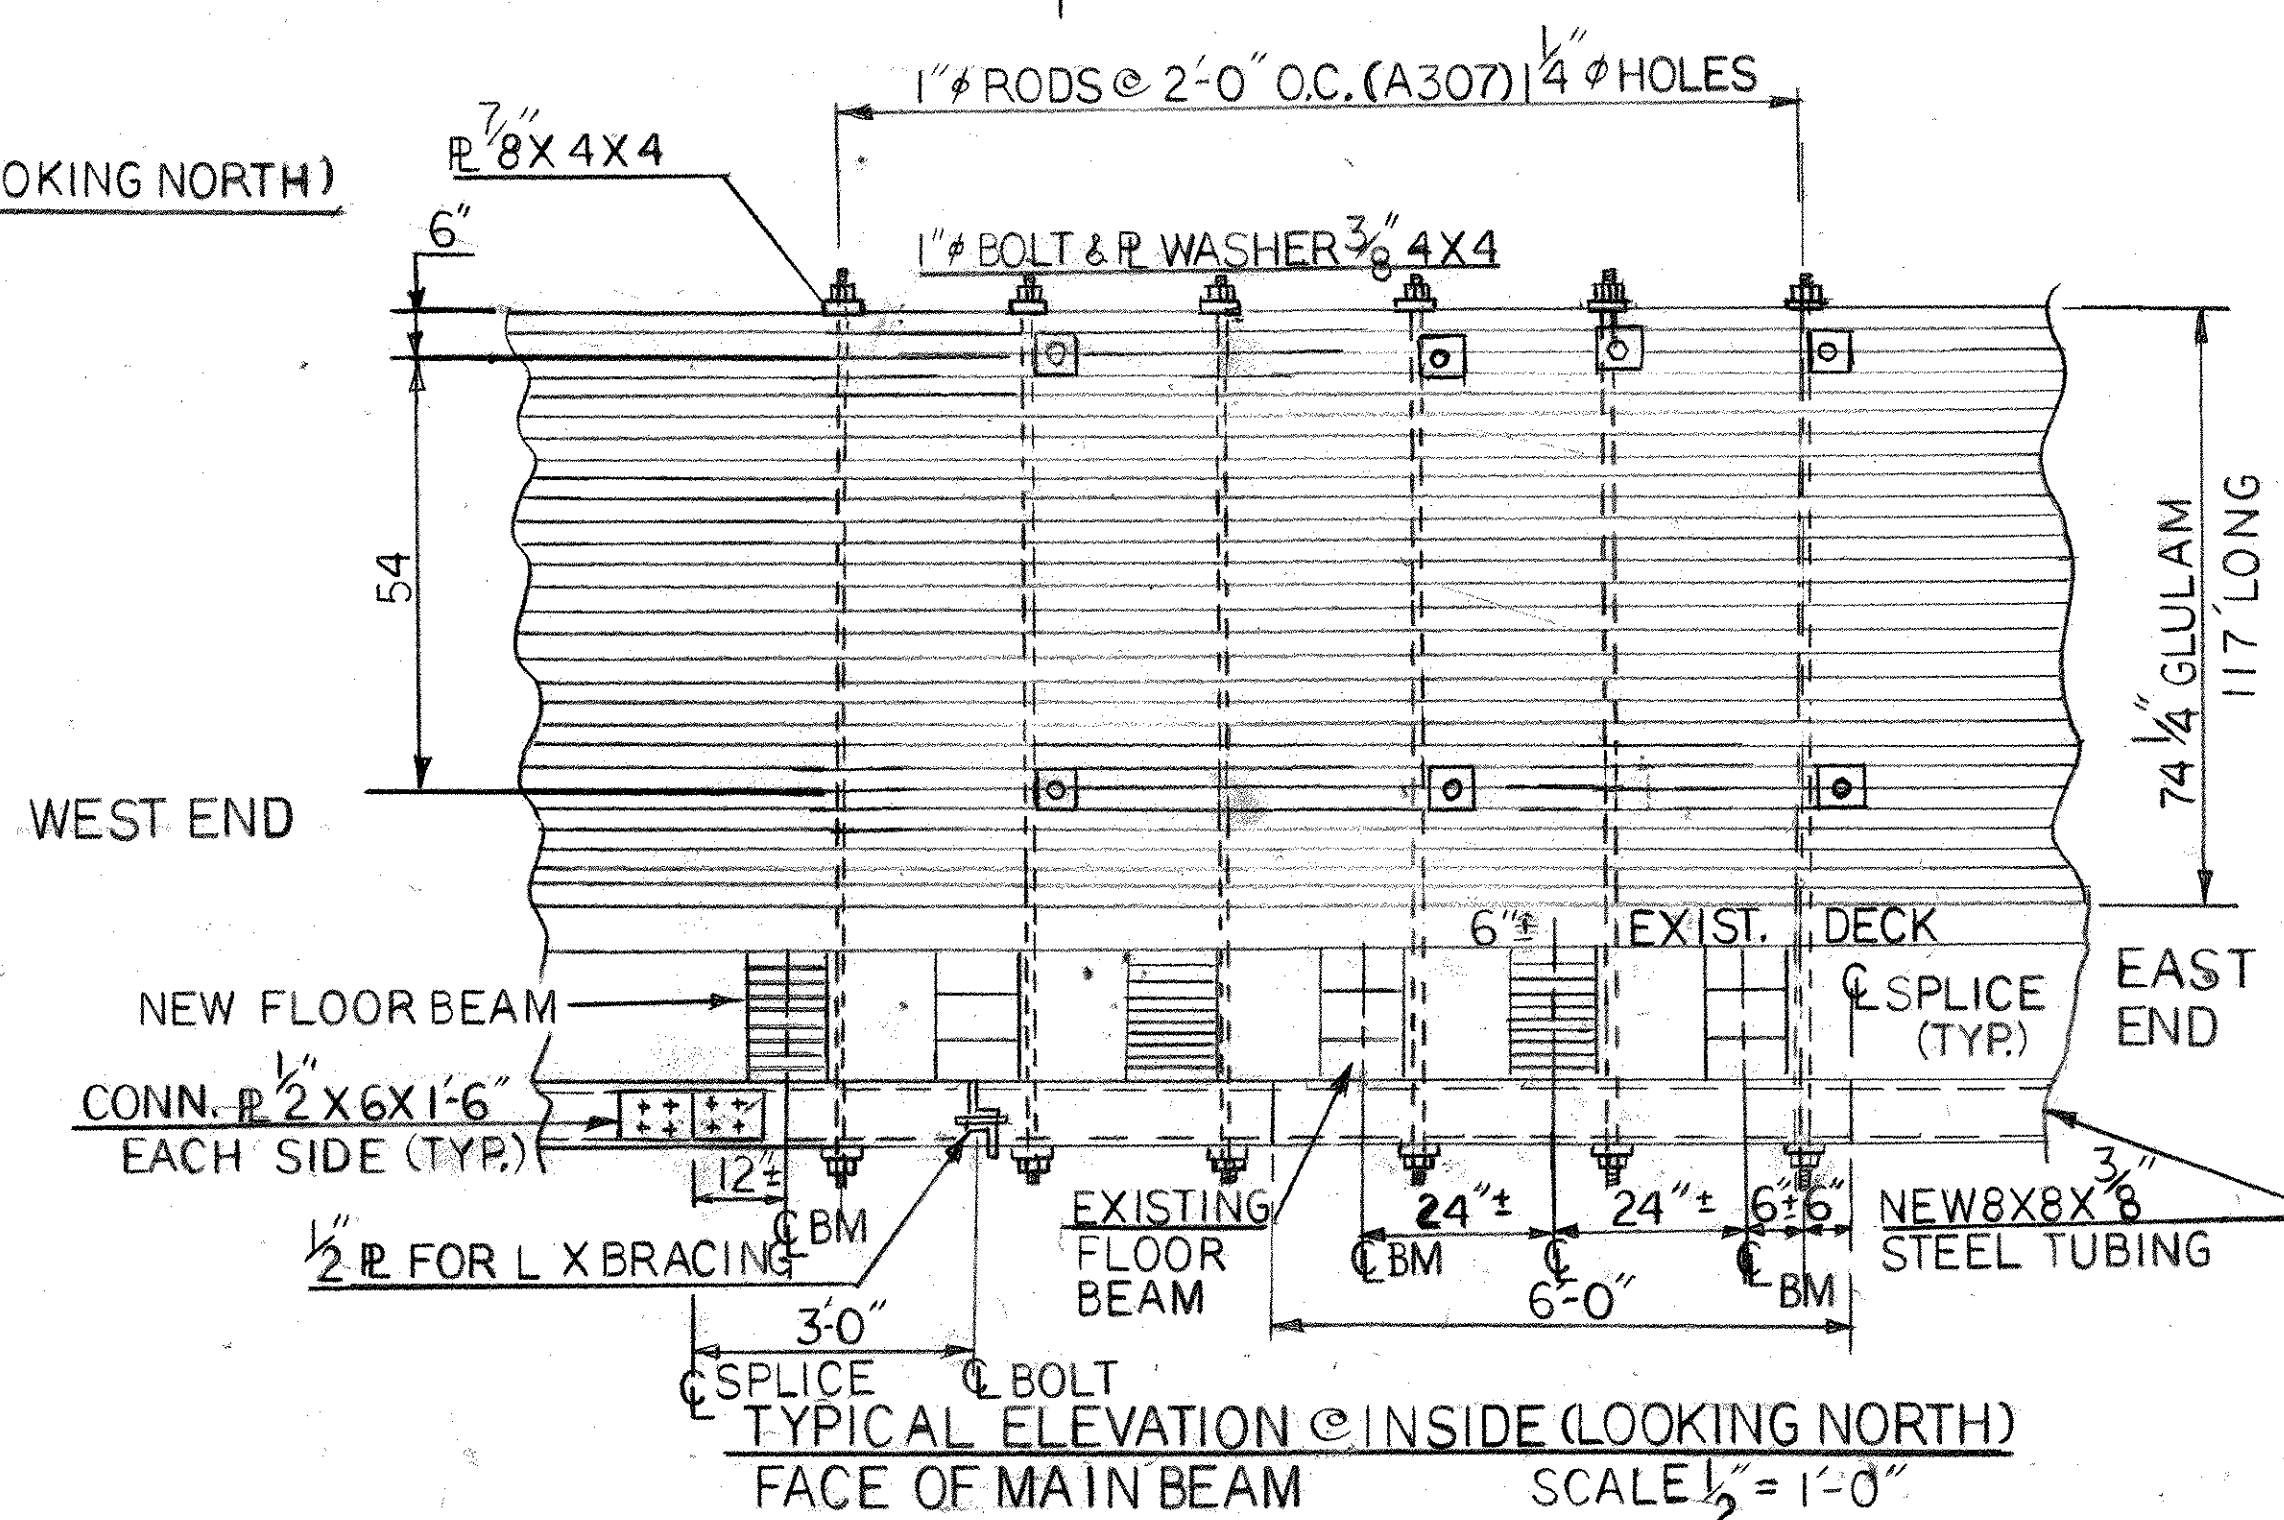

TYPICAL ELEVATION @ INSIDE (LOOKING NORTH)
FACE OF MAIN BEAM SCALE 1/2" = 1'-0"

STATE OF VERMONT AGENCY OF TRANSPORTATION	
Town Of NEWFANE	Bridge No. 17
Highway No. TH 2, CL. 2	Log Sta. Surv. Sta.
BEAM ELEVATION	
Designed By J. WEAVER	Drawn By S. FUGERE
Checked By J. WEAVER Date 7-16-98	Bridge Design Supervisor J. WEAVER Date 7-20-98
PROJECT NEWFANE	PROJECT NO. BHF 0106 (4) S
I.G.C. Info.	
Bridge Sheet No.	Sheet 7 of 8