


Note: Steel supportworks shown here is existing structure previously used as launch pier for 240 Mabey.

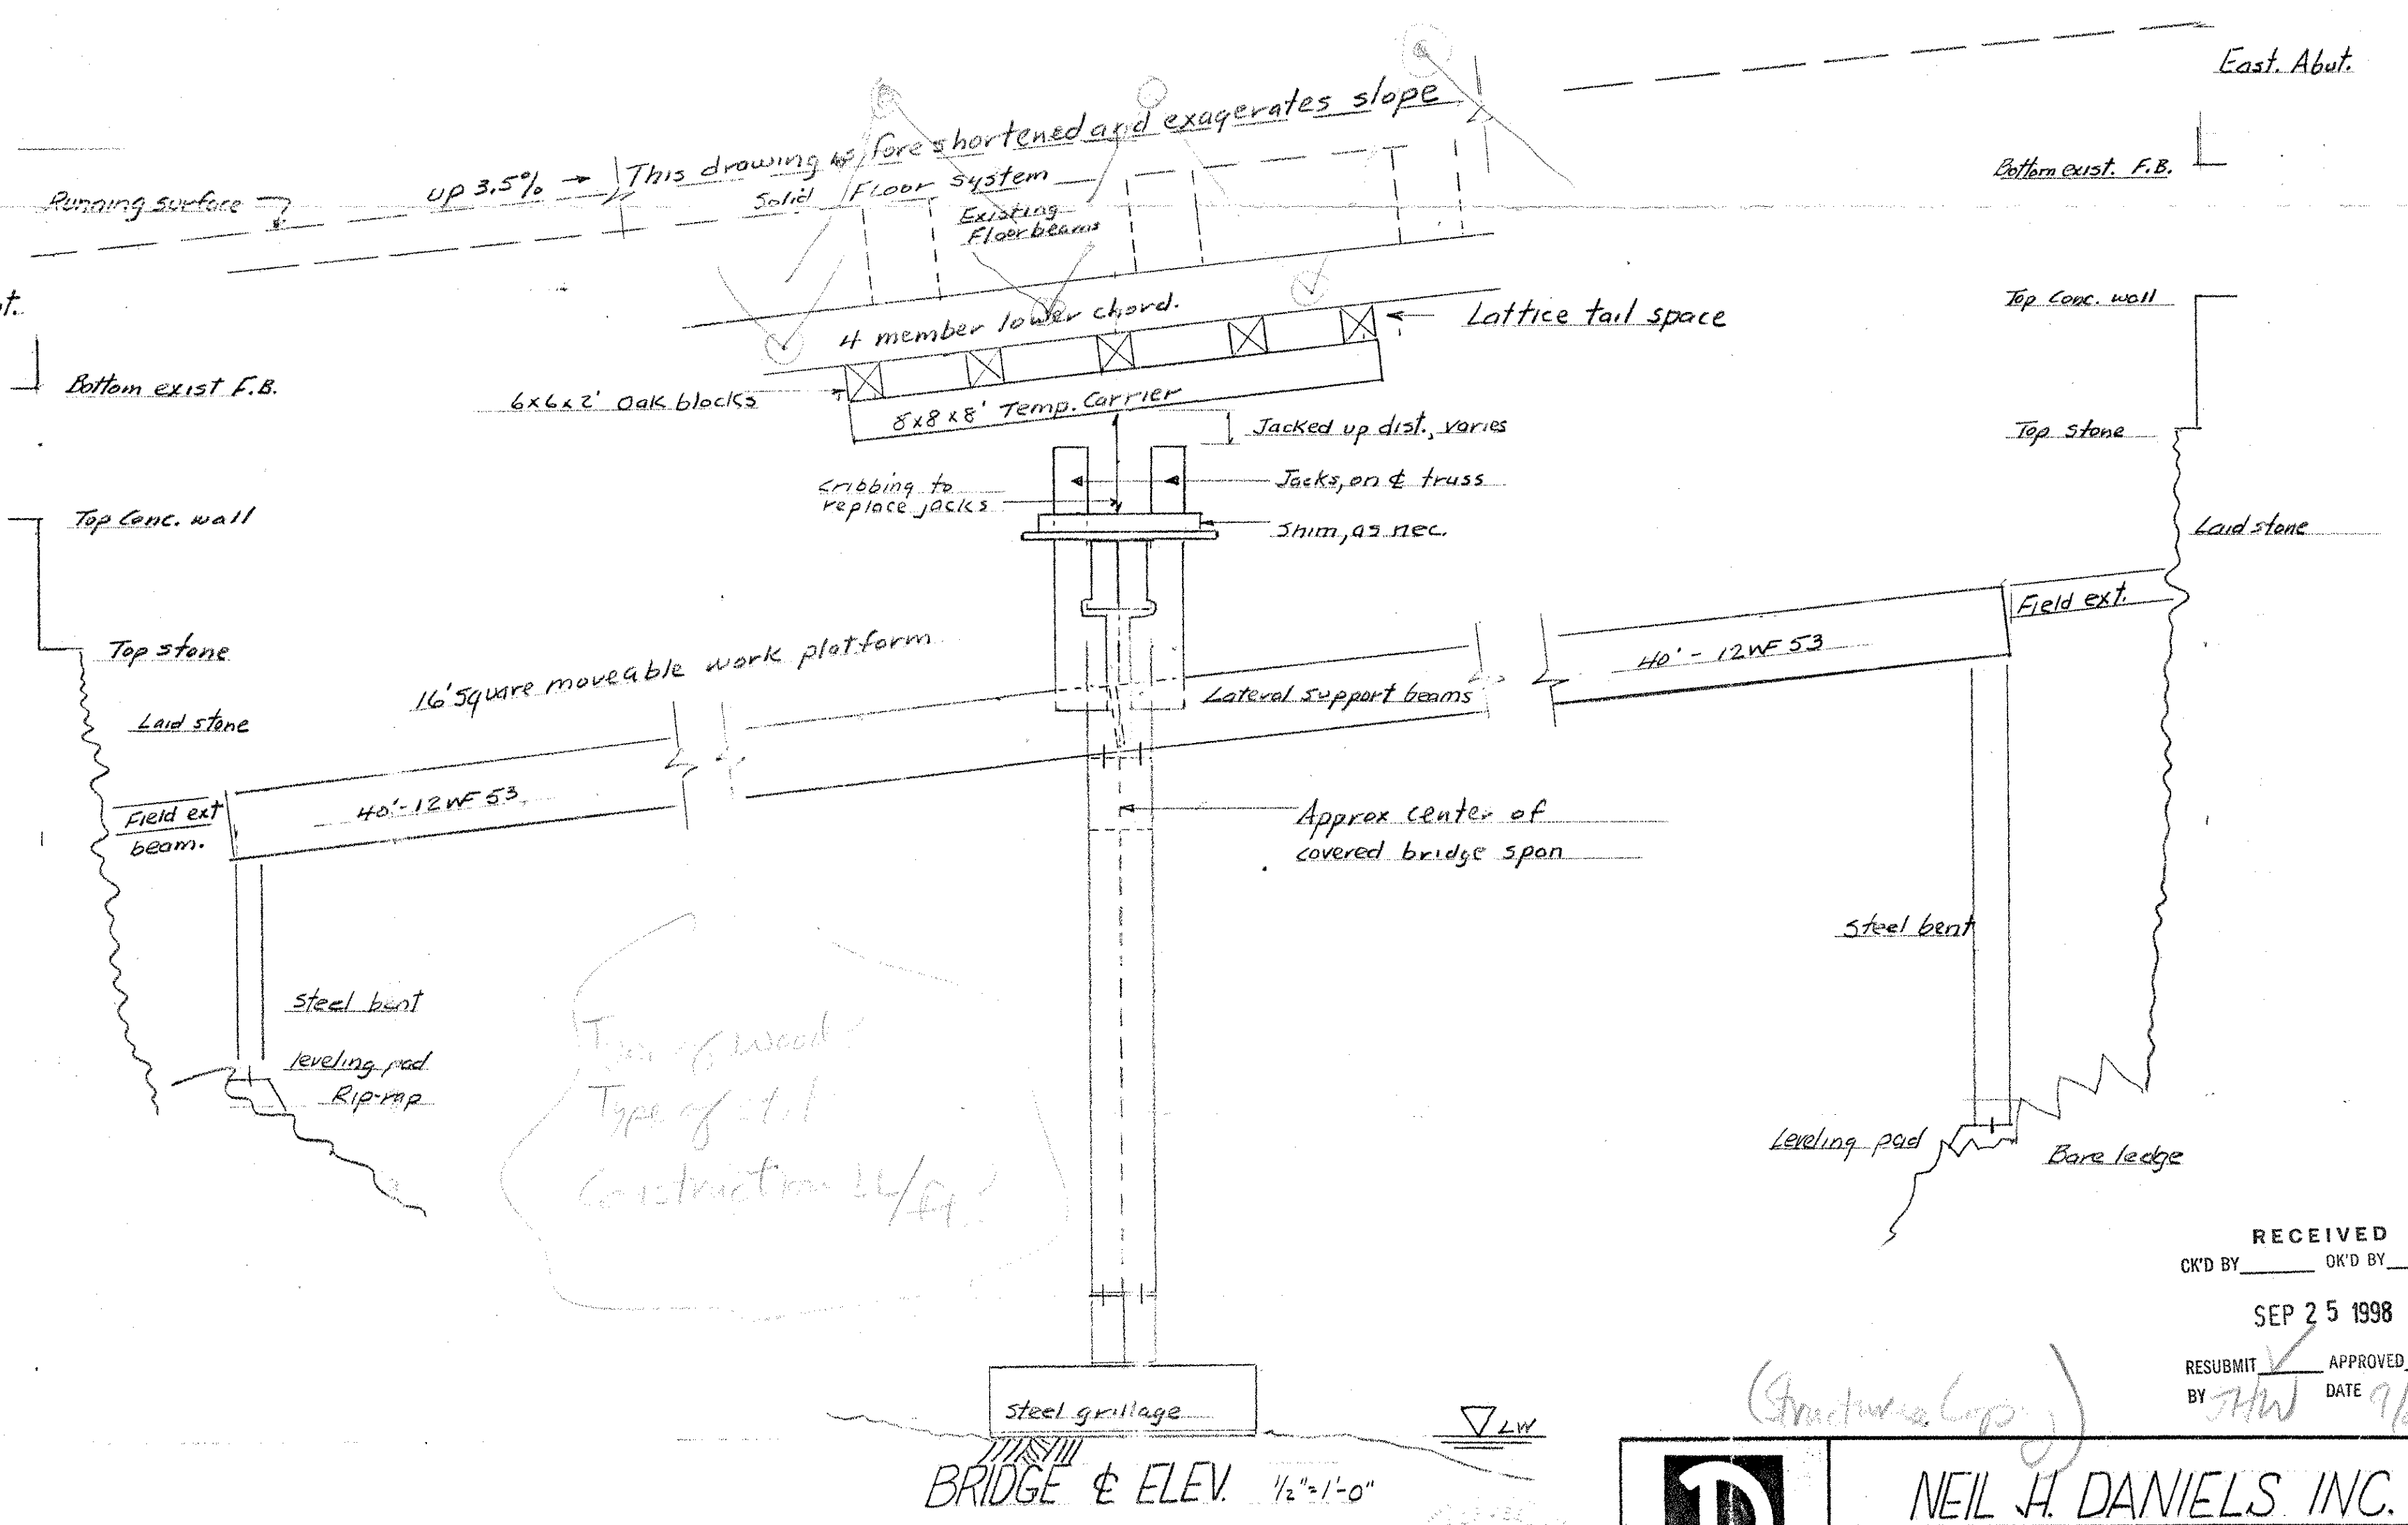

RECEIVED
 OK'D BY _____ OK'D BY _____
 SEP 25 1998
 RESUBMIT APPROVED
 BY *HW* DATE *9/25/98*

 DANIELS CONSTRUCTION ASCUTNEY, VT 05030	SCALE: 1/2" = 1'-0" DATE: 9-24-98	APPROVED BY _____ DRAWN BY <i>NHD</i>
	NEIL H. DANIELS, INC. WILLIAMSVILLE COVERED BR. TEMPORARY SUPPORT DRAWING NUMBER 8738-1	