


INDEX OF SHEETS
SEE SHEET 2

STATE OF VERMONT AGENCY OF TRANSPORTATION



PROPOSED IMPROVEMENT BRIDGE PROJECT

TOWN OF NEWFANE
COUNTY OF WINDHAM

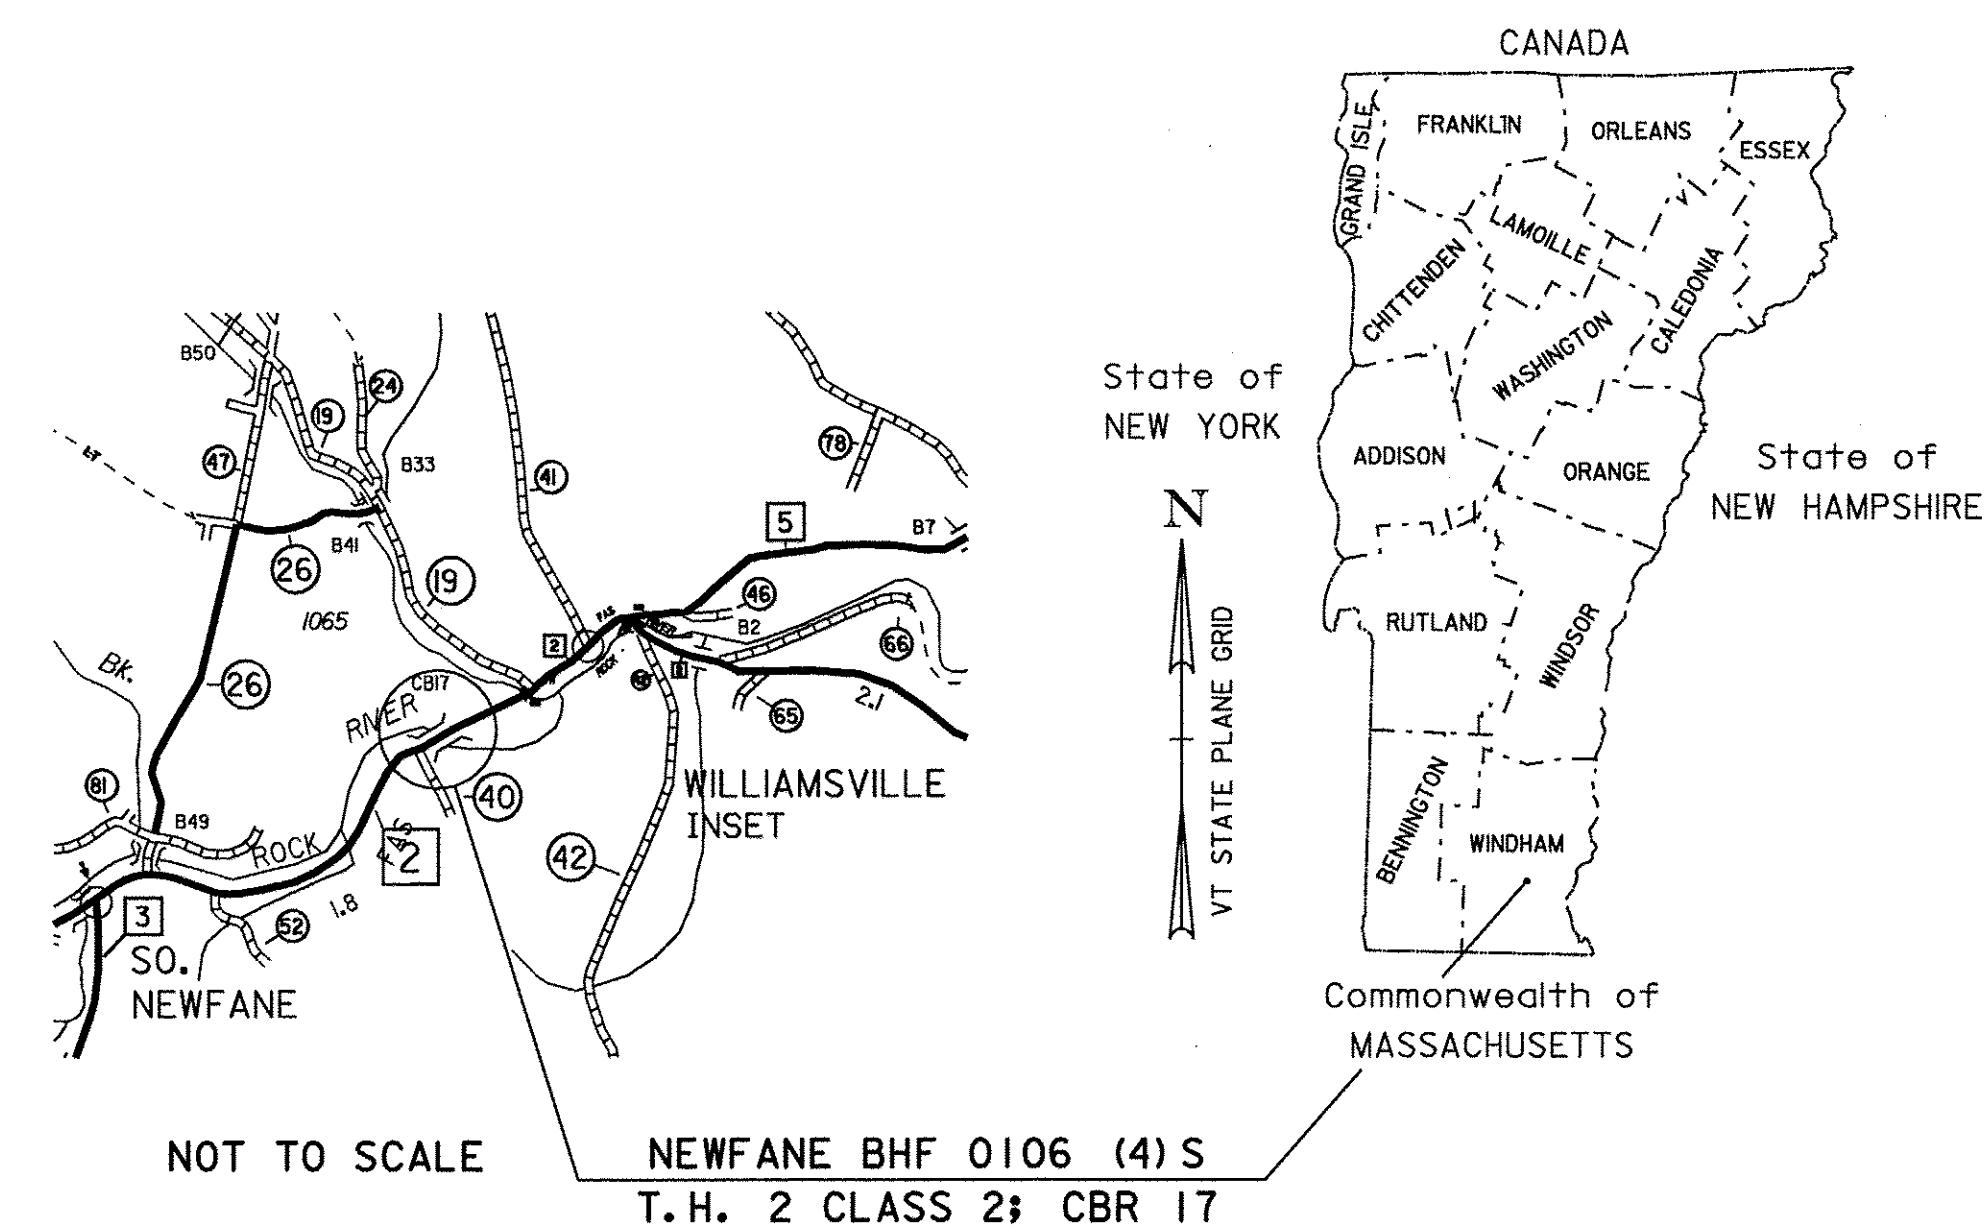



RECORD PLANS	
CONTRACTOR:	ALPINE CONSTRUCTION, LLC - SCHUYLERVILLE, NY
RESIDENT ENGINEER:	FRED ROSS
CONSTRUCTION BEGAN:	NOVEMBER 16, 2009
CONSTRUCTION COMPLETE:	NOVEMBER 22, 2010
RECORD PLANS BY:	FRED ROSS & AMOS KEMPTON
I HEREBY CERTIFY THAT ALL THE CONSTRUCTION REQUIRED BY THIS SET OF DRAWINGS HAS BEEN ACCOMPLISHED AS INDICATED HEREIN.	
BY	<i>Fred Ross</i> RESIDENT ENGINEER
DATE	10-12-11
NOTE: Any further information concerning final quantities, amounts or other details relative to this project may be found at Central Files in the electronic archives.	

ROUTE NO : T.H. 2 CLASS 2 FAS 0106 BRIDGE NO : 17

PROJECT LOCATION: BEGINNING ON TH 2 AT 1.2 MILES EAST OF THE INTERSECTION OF TH 2 AND TH 3 AND PROCEEDING EASTERLY 0.04 MILES ON TH 2.

PROJECT DESCRIPTION: COMPLETE RECONSTRUCTION OF THE WILLIAMSVILLE COVERED BRIDGE SUPERSTRUCTURE WITH MINOR SUBSTRUCTURE AND ASSOCIATED ROADWAY APPROACH WORK.

LENGTH OF STRUCTURE : 120.16 FEET
LENGTH OF ROADWAY : 67.02 FEET
LENGTH OF PROJECT : 187.18 FEET

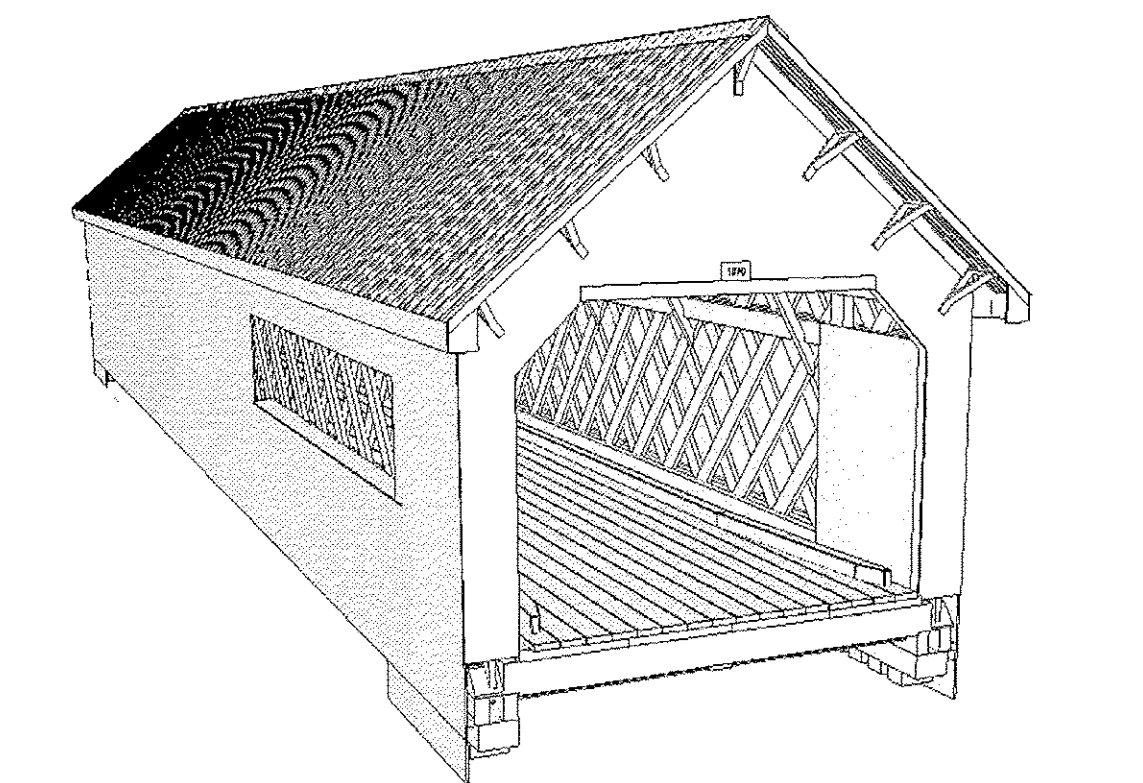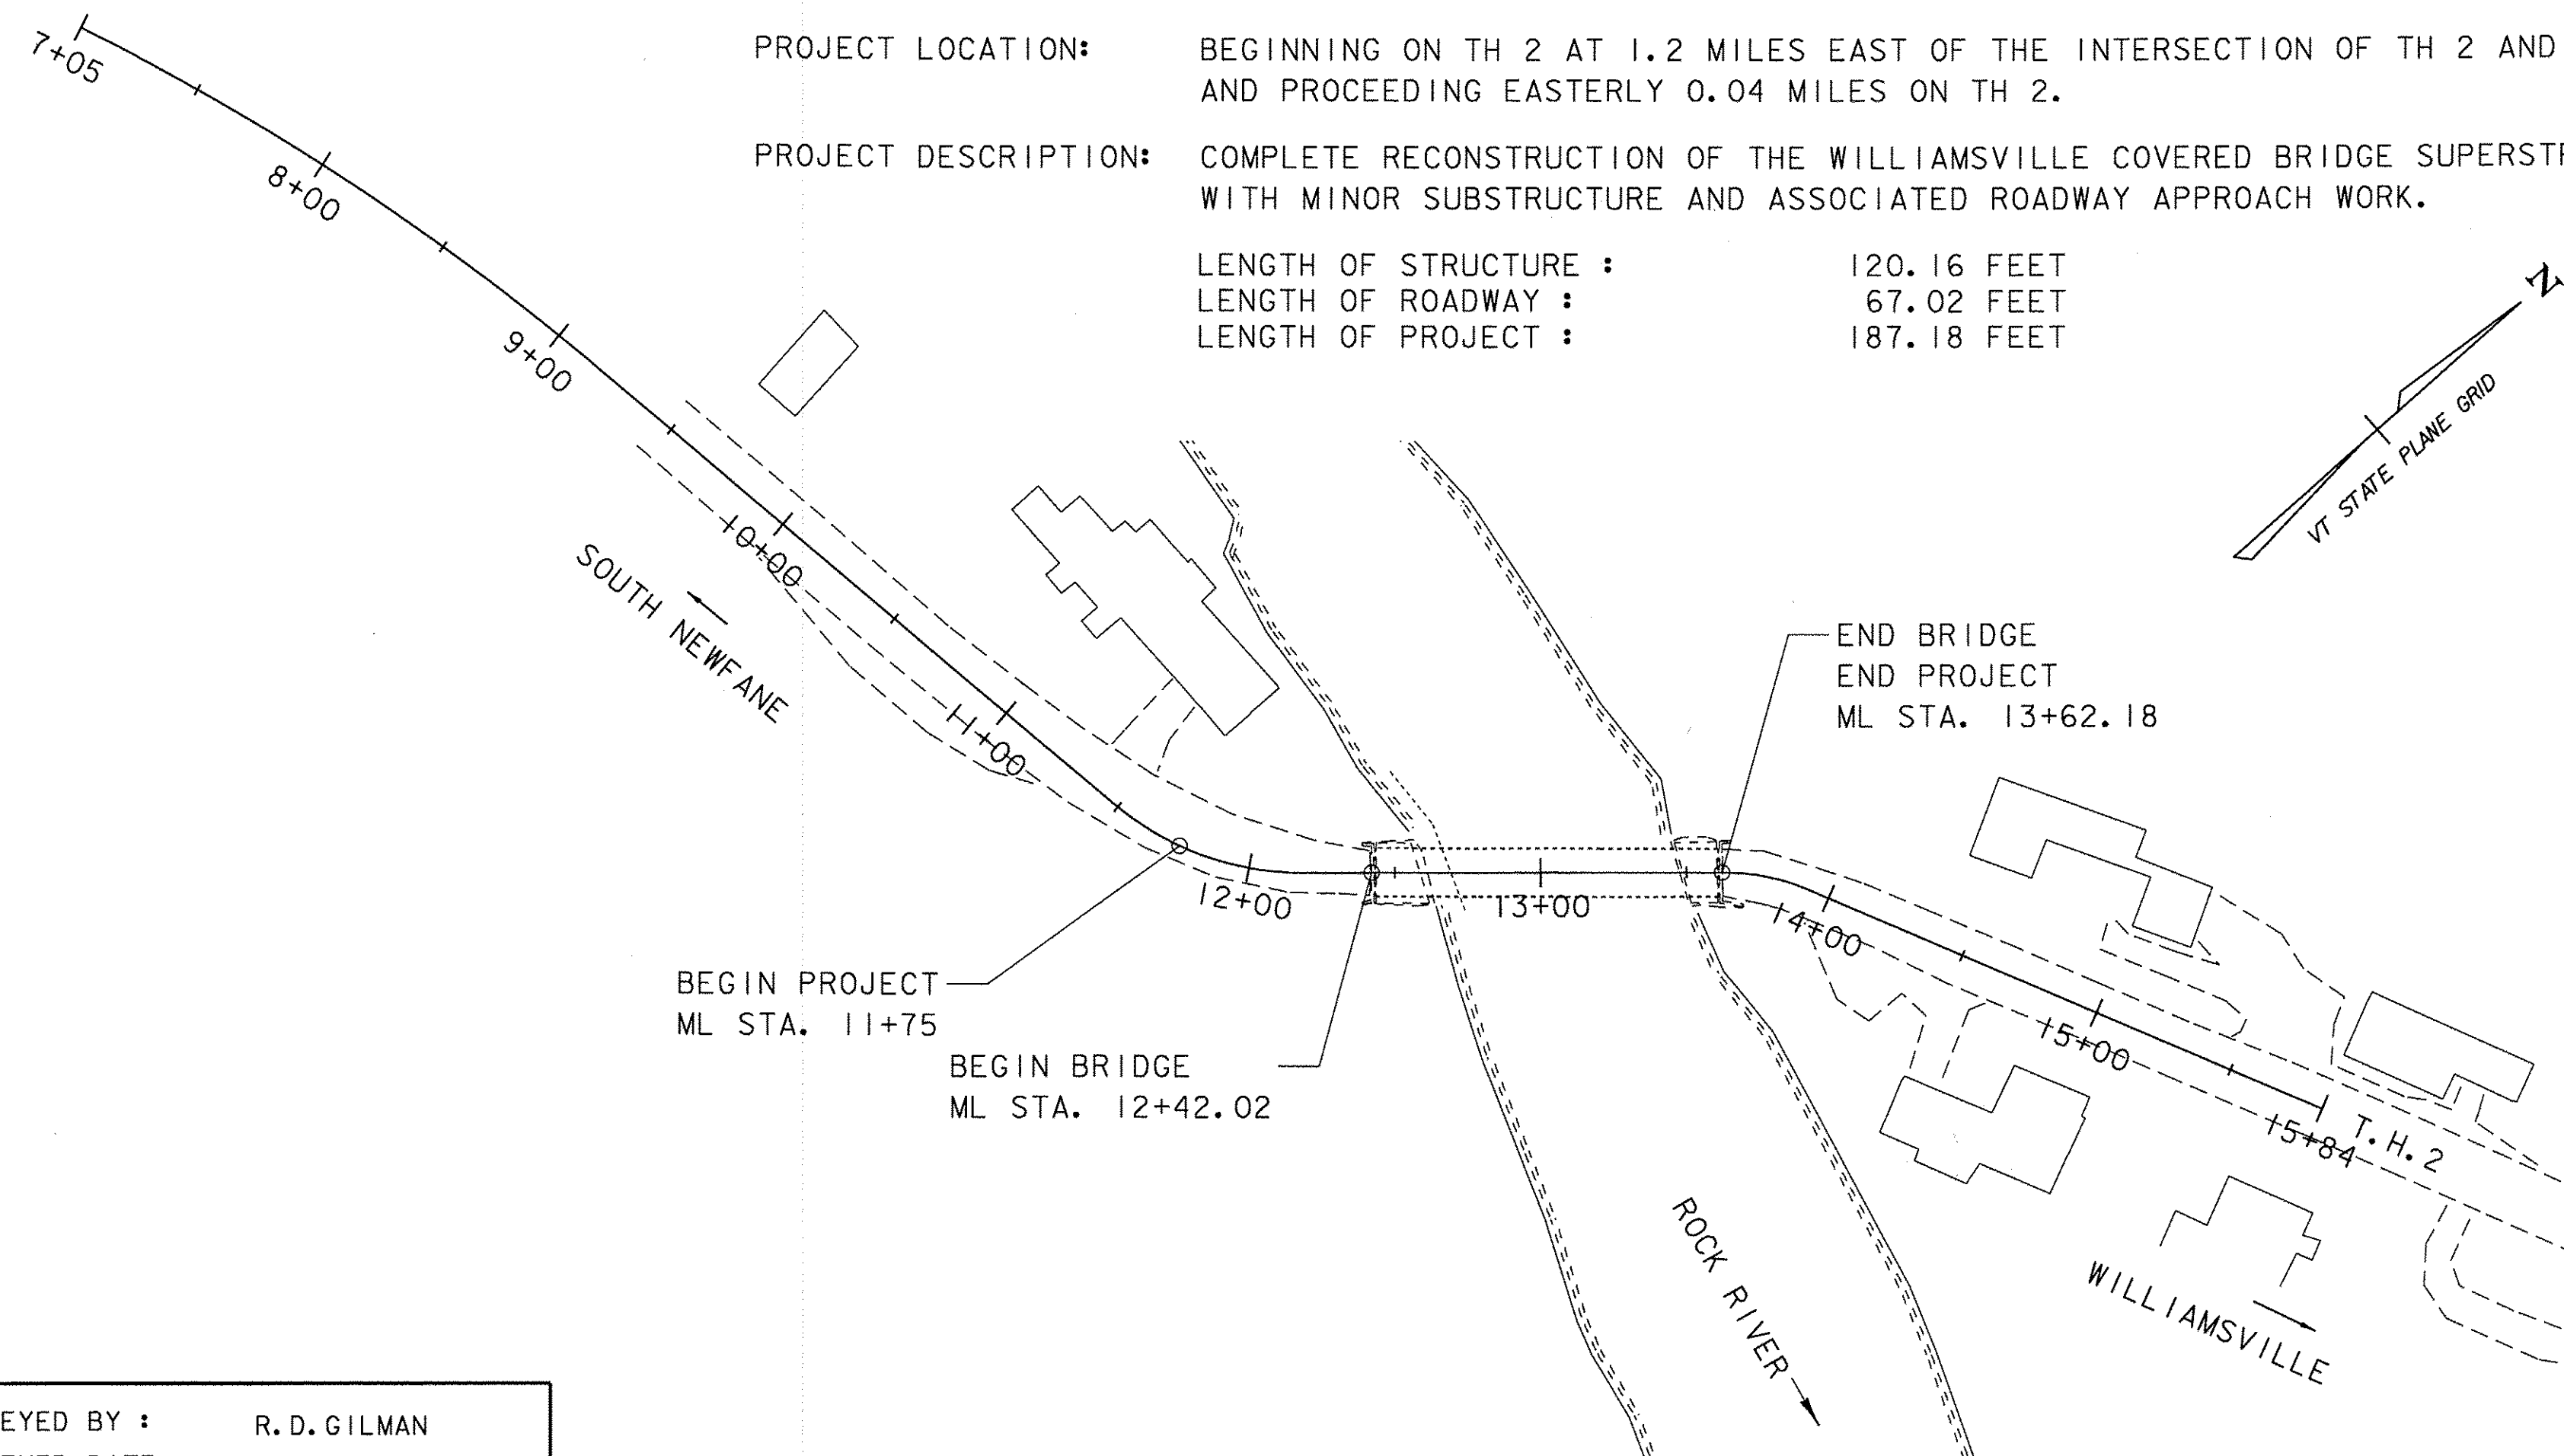

WILLIAMSVILLE COVERED BRIDGE

CONVENTIONAL SYMBOLS	
COUNTY LINE	
TOWN LINE	
LIMITS OF ACCESS	
POINT OF ACCESS	
FENCE LINE	
STONE WALL	
TRAVELED WAY	
GUARD RAIL	
RAILROAD	
SURVEY LINE	
CULVERT	
POWER POLE	
TELEPHONE POLE	
TREES	
CONTROL OF ACCESS	
PROPERTY LINE	
R.O.W. TAKING LINE	
SLOPE RIGHTS	
TOP OF CUT	
TOE OF SLOPE	

SURVEYED BY : R. D. GILMAN
SURVEYED DATE : 4-23-1998

DATUM
VERTICAL NAVD88
HORIZONTAL NAD-83 (92)

SCALE 1" = 50'-0"

THESE PLANS ARE SUBJECT TO SUCH ENGINEERING CHANGES AS MAY BE REQUIRED BY THE FEDERAL HIGHWAY ADMINISTRATION OR THE DIRECTOR OF PROGRAM DEVELOPMENT.

CONSTRUCTION IS TO BE CARRIED ON IN ACCORDANCE WITH THESE PLANS AND THE STANDARD SPECIFICATIONS FOR CONSTRUCTION DATED 2006, AS APPROVED BY THE FEDERAL HIGHWAY ADMINISTRATION ON JUNE 15, 2006 FOR USE ON THIS PROJECT, INCLUDING ALL SUBSEQUENT REVISIONS AND SUCH REVISED SPECIFICATIONS AND SPECIAL PROVISIONS AS ARE INCORPORATED IN THESE PLANS.

DIRECTOR OF PROGRAM DEVELOPMENT	
APPROVED <i>R. R. Whitcomb</i>	DATE 4-29-09
PROJECT MANAGER : R. R. WHITCOMB	
PROJECT NAME : NEWFANE	
PROJECT NUMBER : BHF 0106 (4) S	
SHEET 1 OF 67 SHEETS	

29-APR-2009