

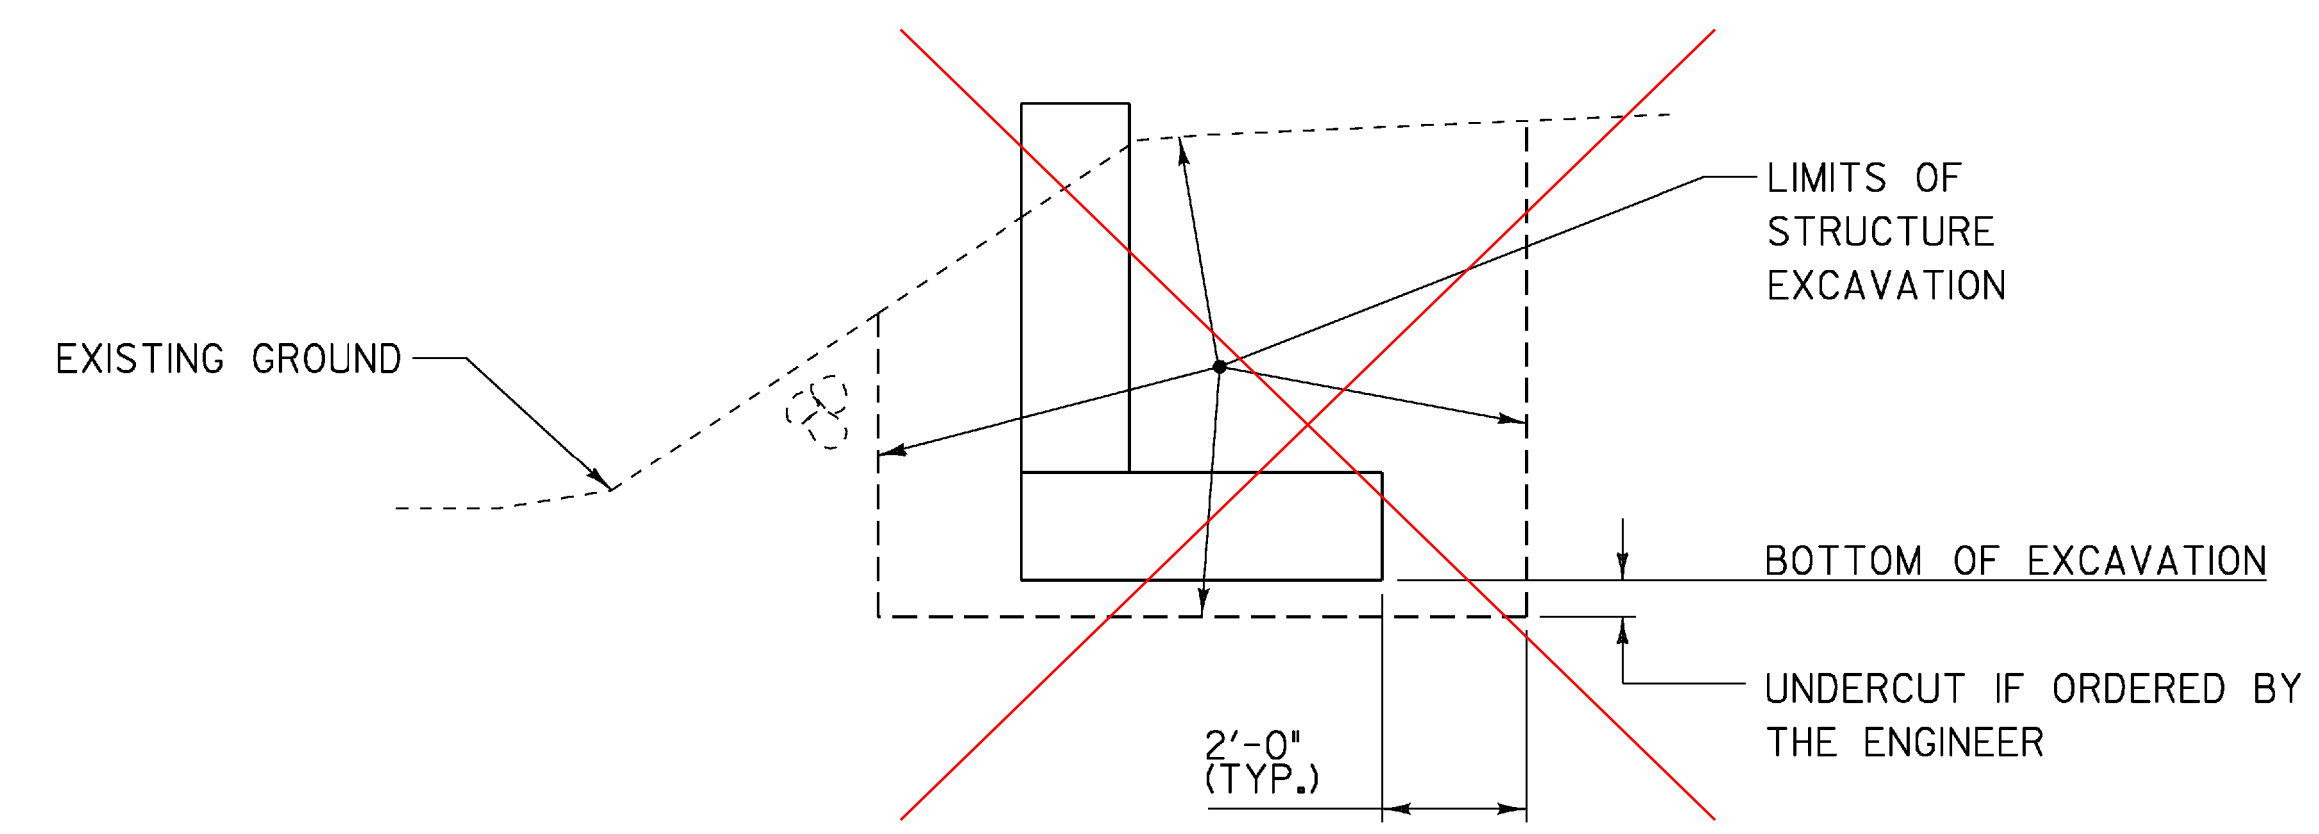


MATERIAL ITEM	TOLERANCE
PAVEMENT	± 1/4" TOTAL THICKNESS
AGGREGATE SURFACE COURSE	± 1/2"
BASE COURSE	± 1/2"
SUBBASE	± 1"
SAND BORROW	± 1"
GRANULAR BORROW	± 1"

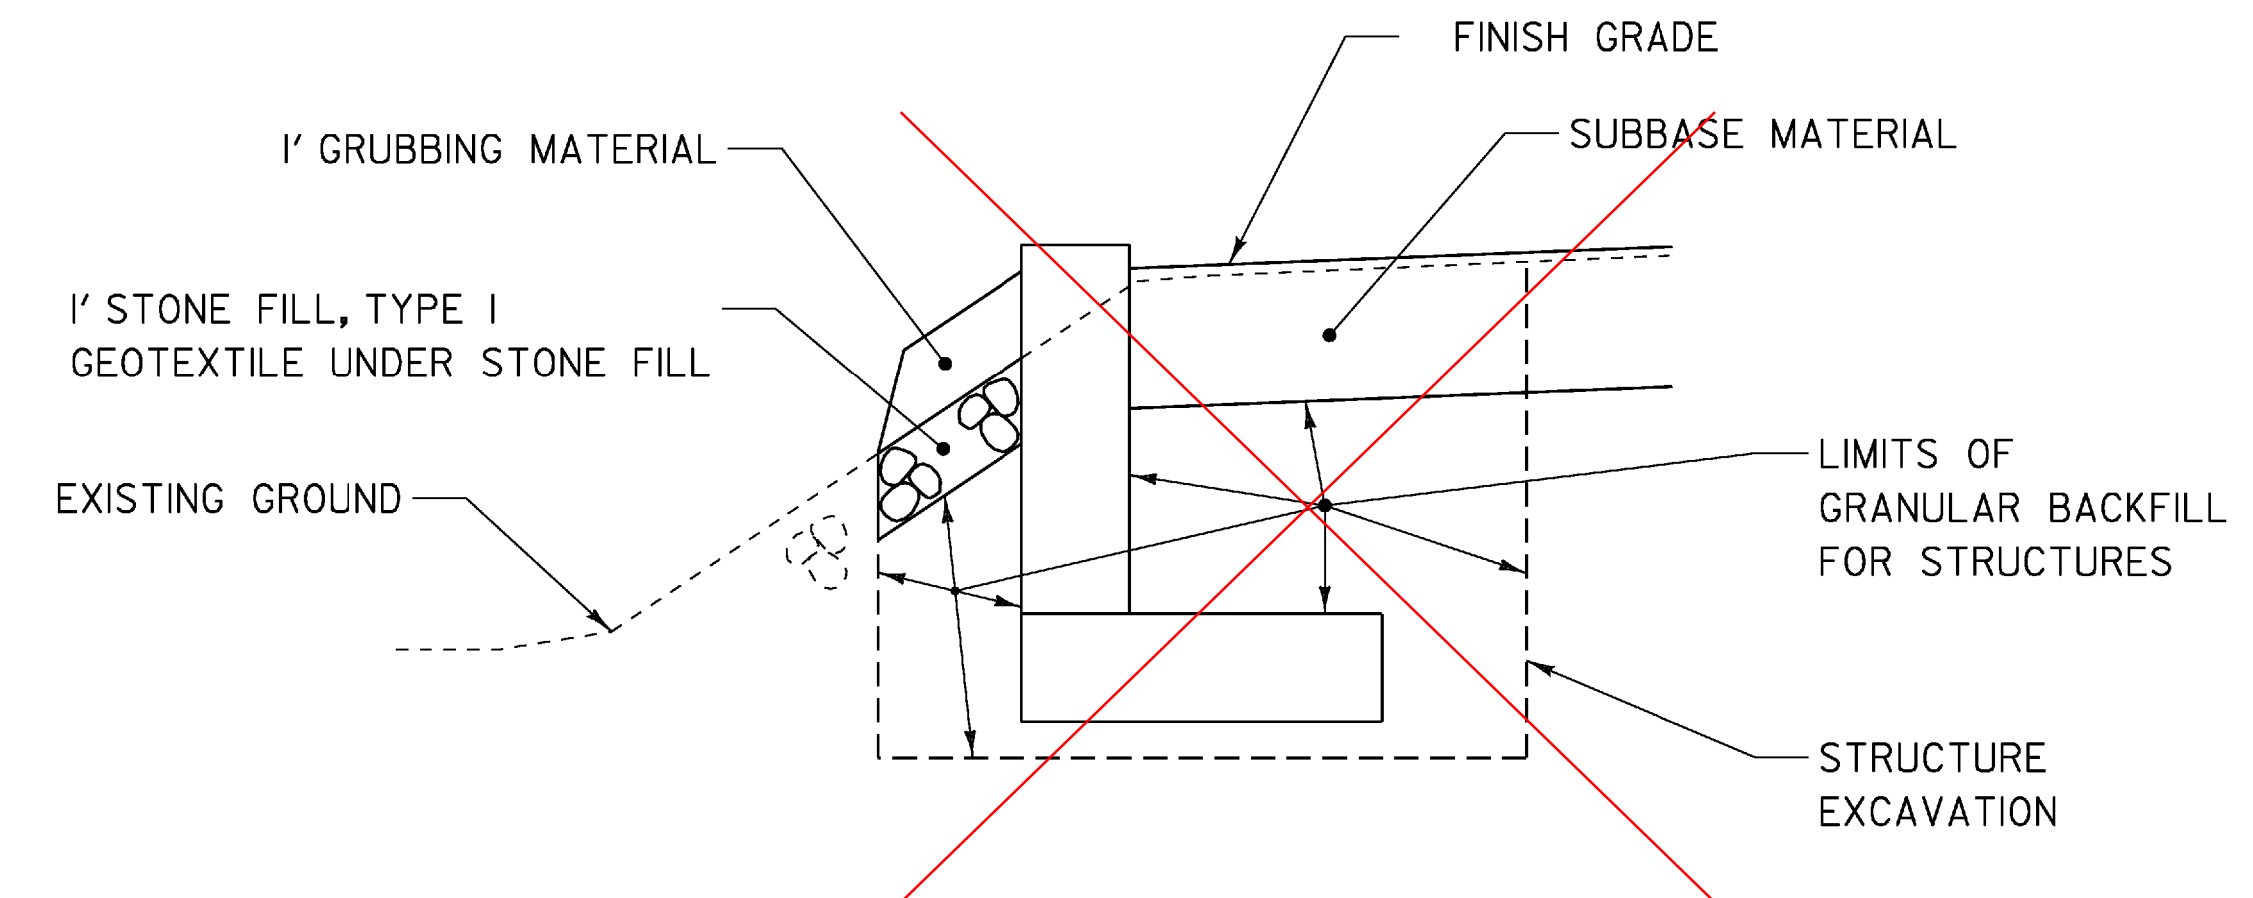


EARTHWORK TYPICAL SECTION WINGWALL EXCAVATIONS

RETAINING WALL ELIMINATED

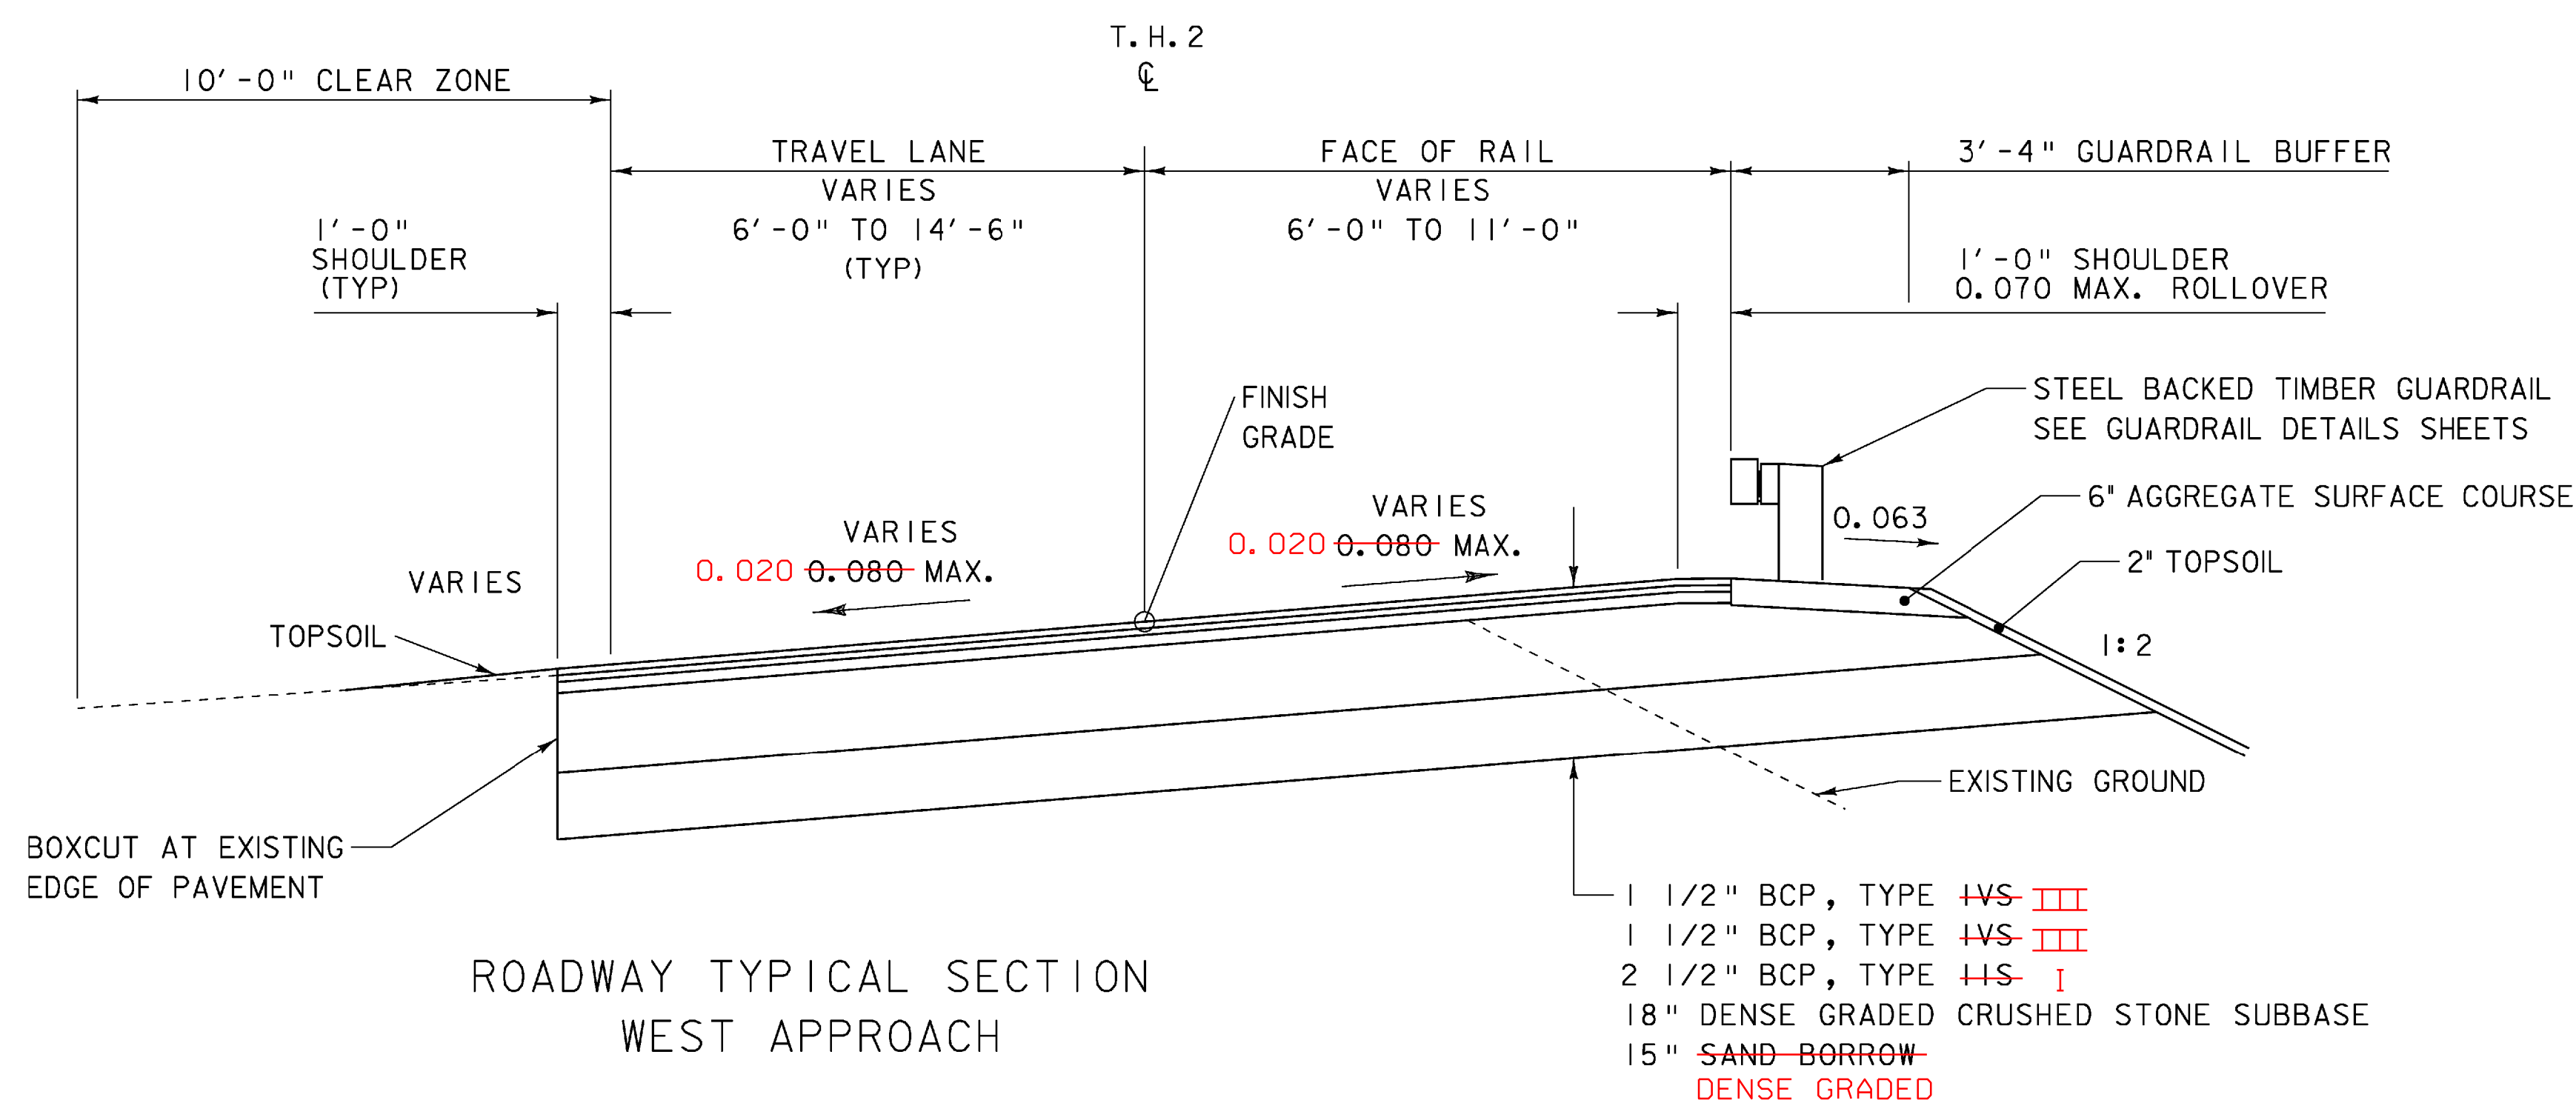

EARTHWORK TYPICAL SECTION WINGWALL FILLS

BCP = SPECIAL PROVISION (BITUMINOUS CONCRETE PAVEMENT, SMALL QUANTITY)

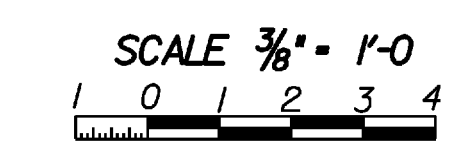

PROJECT NAME: NEWFANE	PLOT DATE: 04-MAY-2009
PROJECT NUMBER: BHF 0106 (4)S	DRAWN BY: T. LACKEY
FILE NAME: s96j230+yp.dgn	CHECKED BY: R. WHITCOMB
PROJECT LEADER: R. WHITCOMB	TYPICAL SECTIONS ROADWAY
DESIGNED BY: T. LACKEY	SHEET 5 OF 67