


EXISTING
TYPICAL SECTION

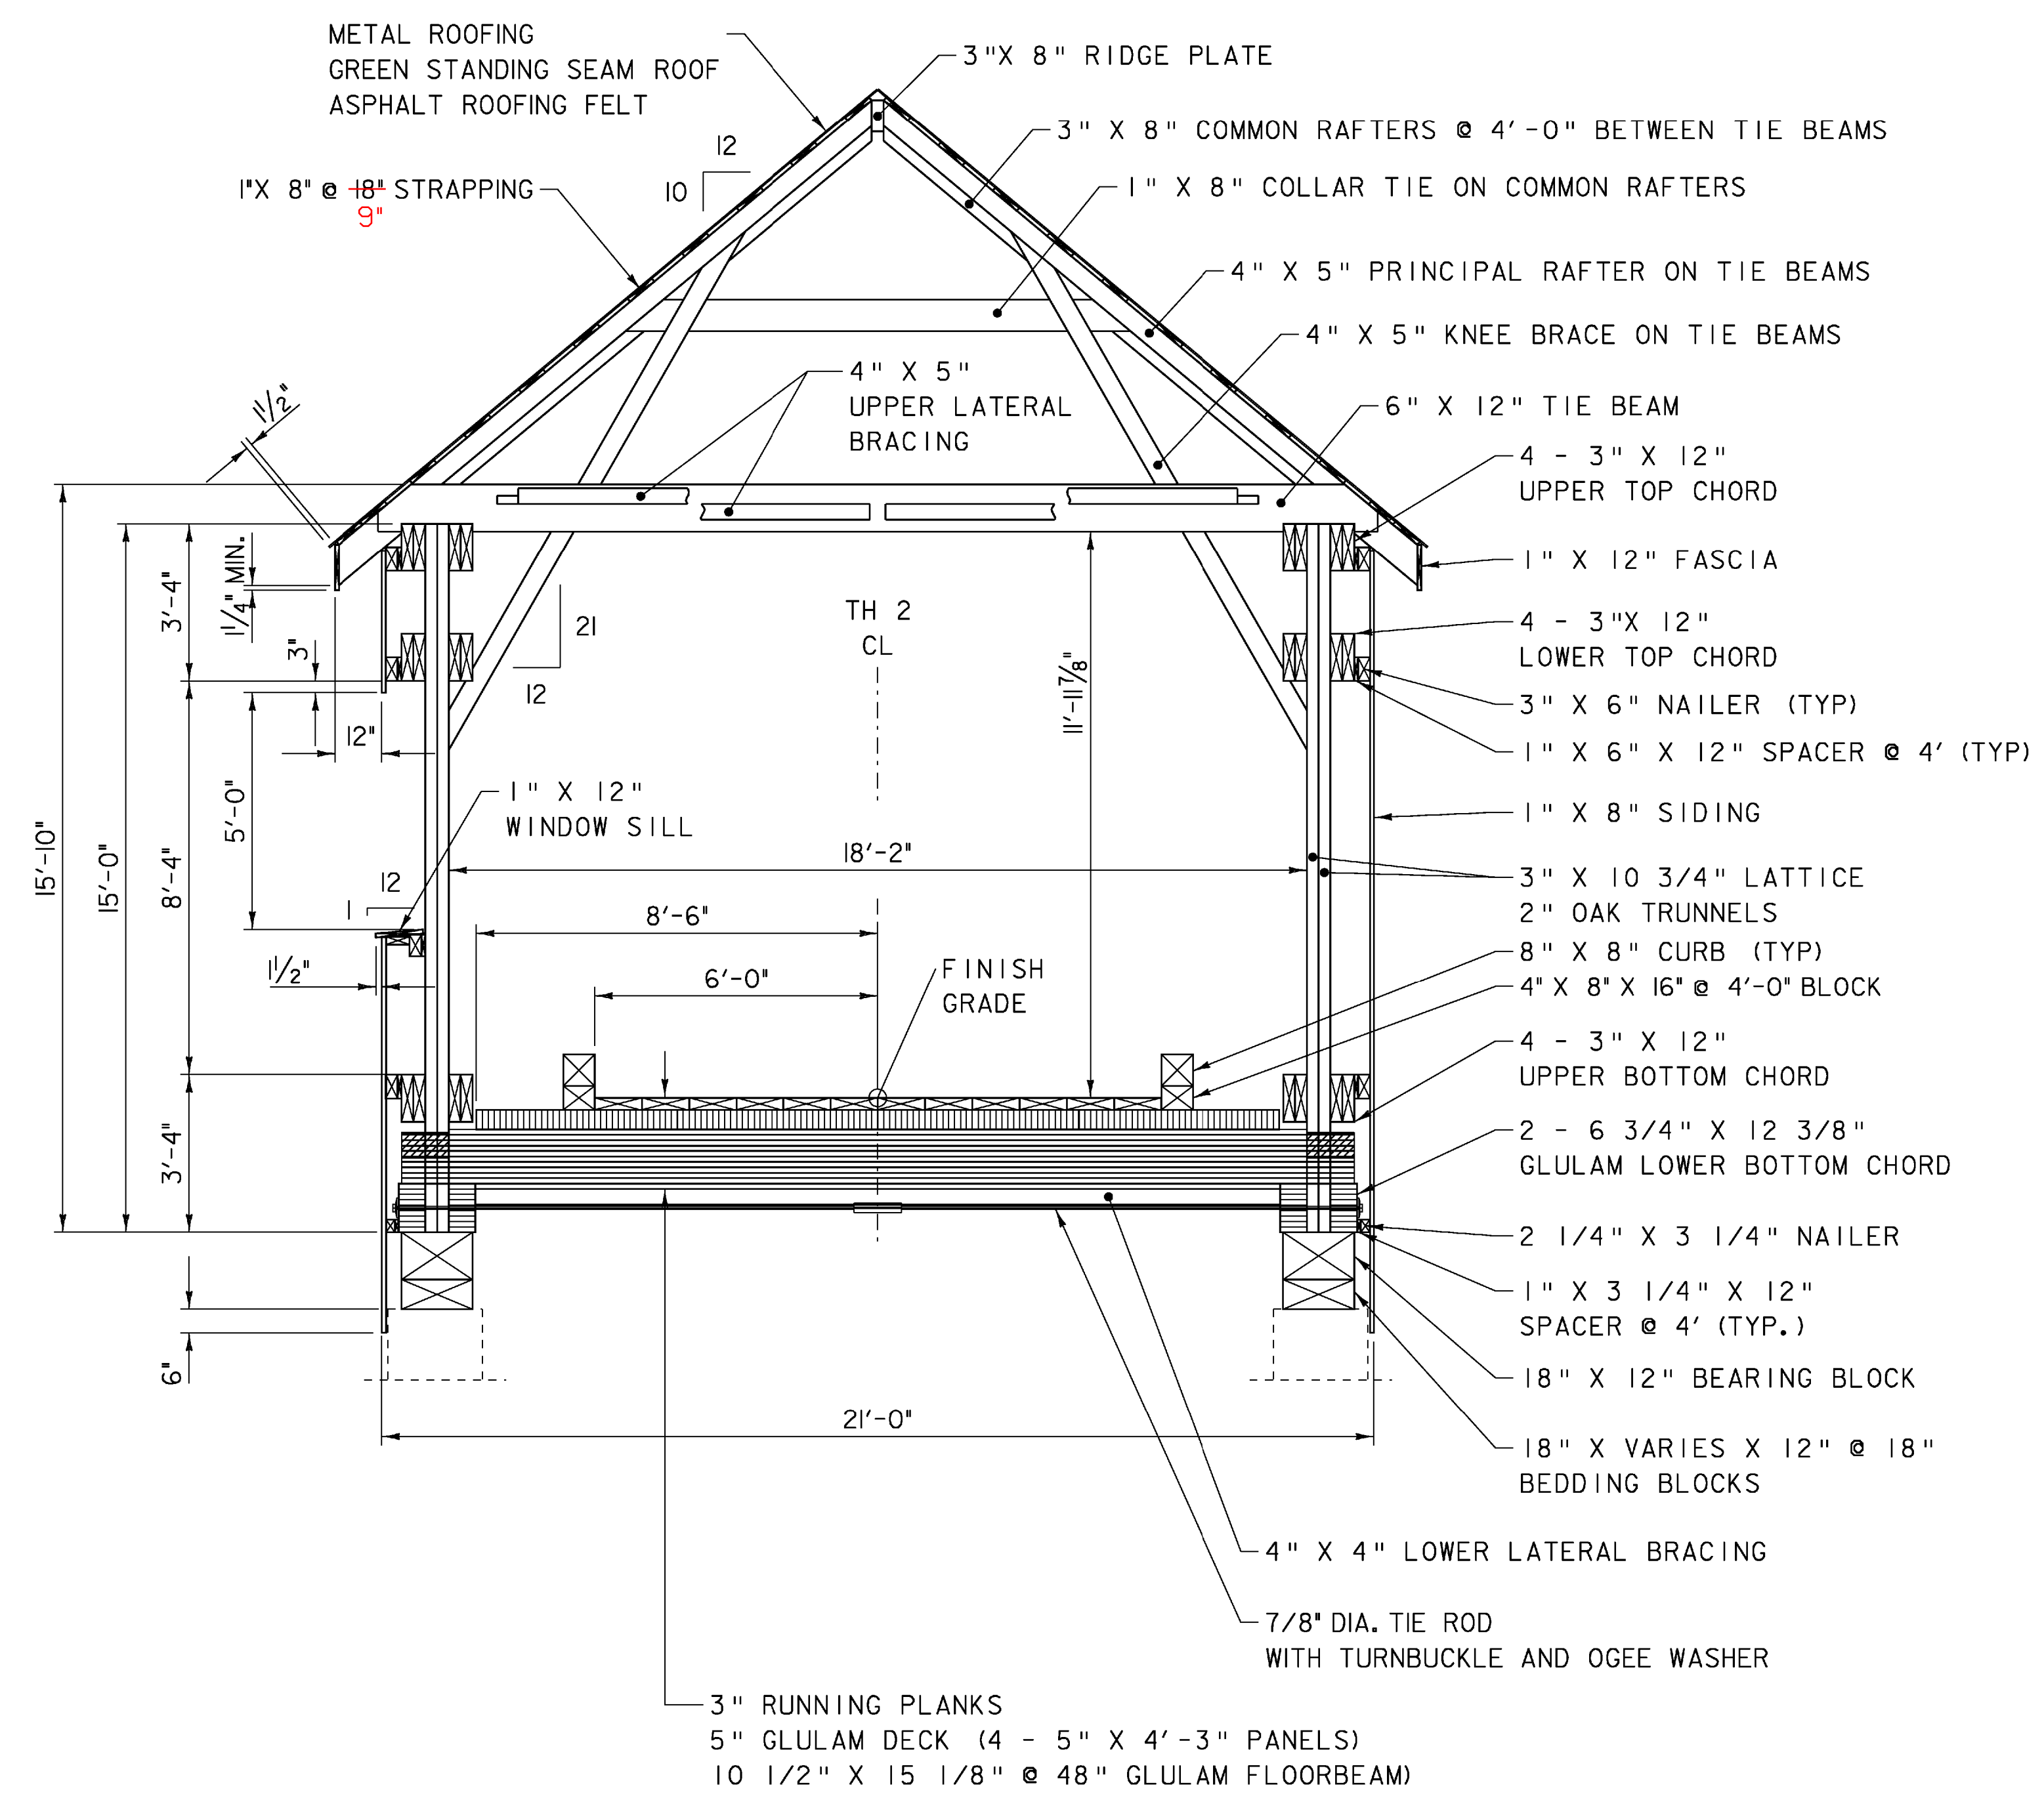

RECONSTRUCTION
TYPICAL SECTION

NOTE: ALL COMPONENTS DETAILED ARE NEW.

SCALE 3/8" = 1'-0"
1 0 1 2 3 4

PROJECT NAME:	NEWFANE	FILE NAME:	s96j230+yp.dgn	PLOT DATE:	29-APR-2009
PROJECT NUMBER:	BHF 0106 (4)S	PROJECT LEADER:	R. WHITCOMB	DRAWN BY:	T. LACKEY
		DESIGNED BY:	T. LACKEY	CHECKED BY:	R. WHITCOMB
		TYPICAL SECTIONS BRIDGE		SHEET 6	OF 67