


WEST PORTAL
ABUTMENT 1

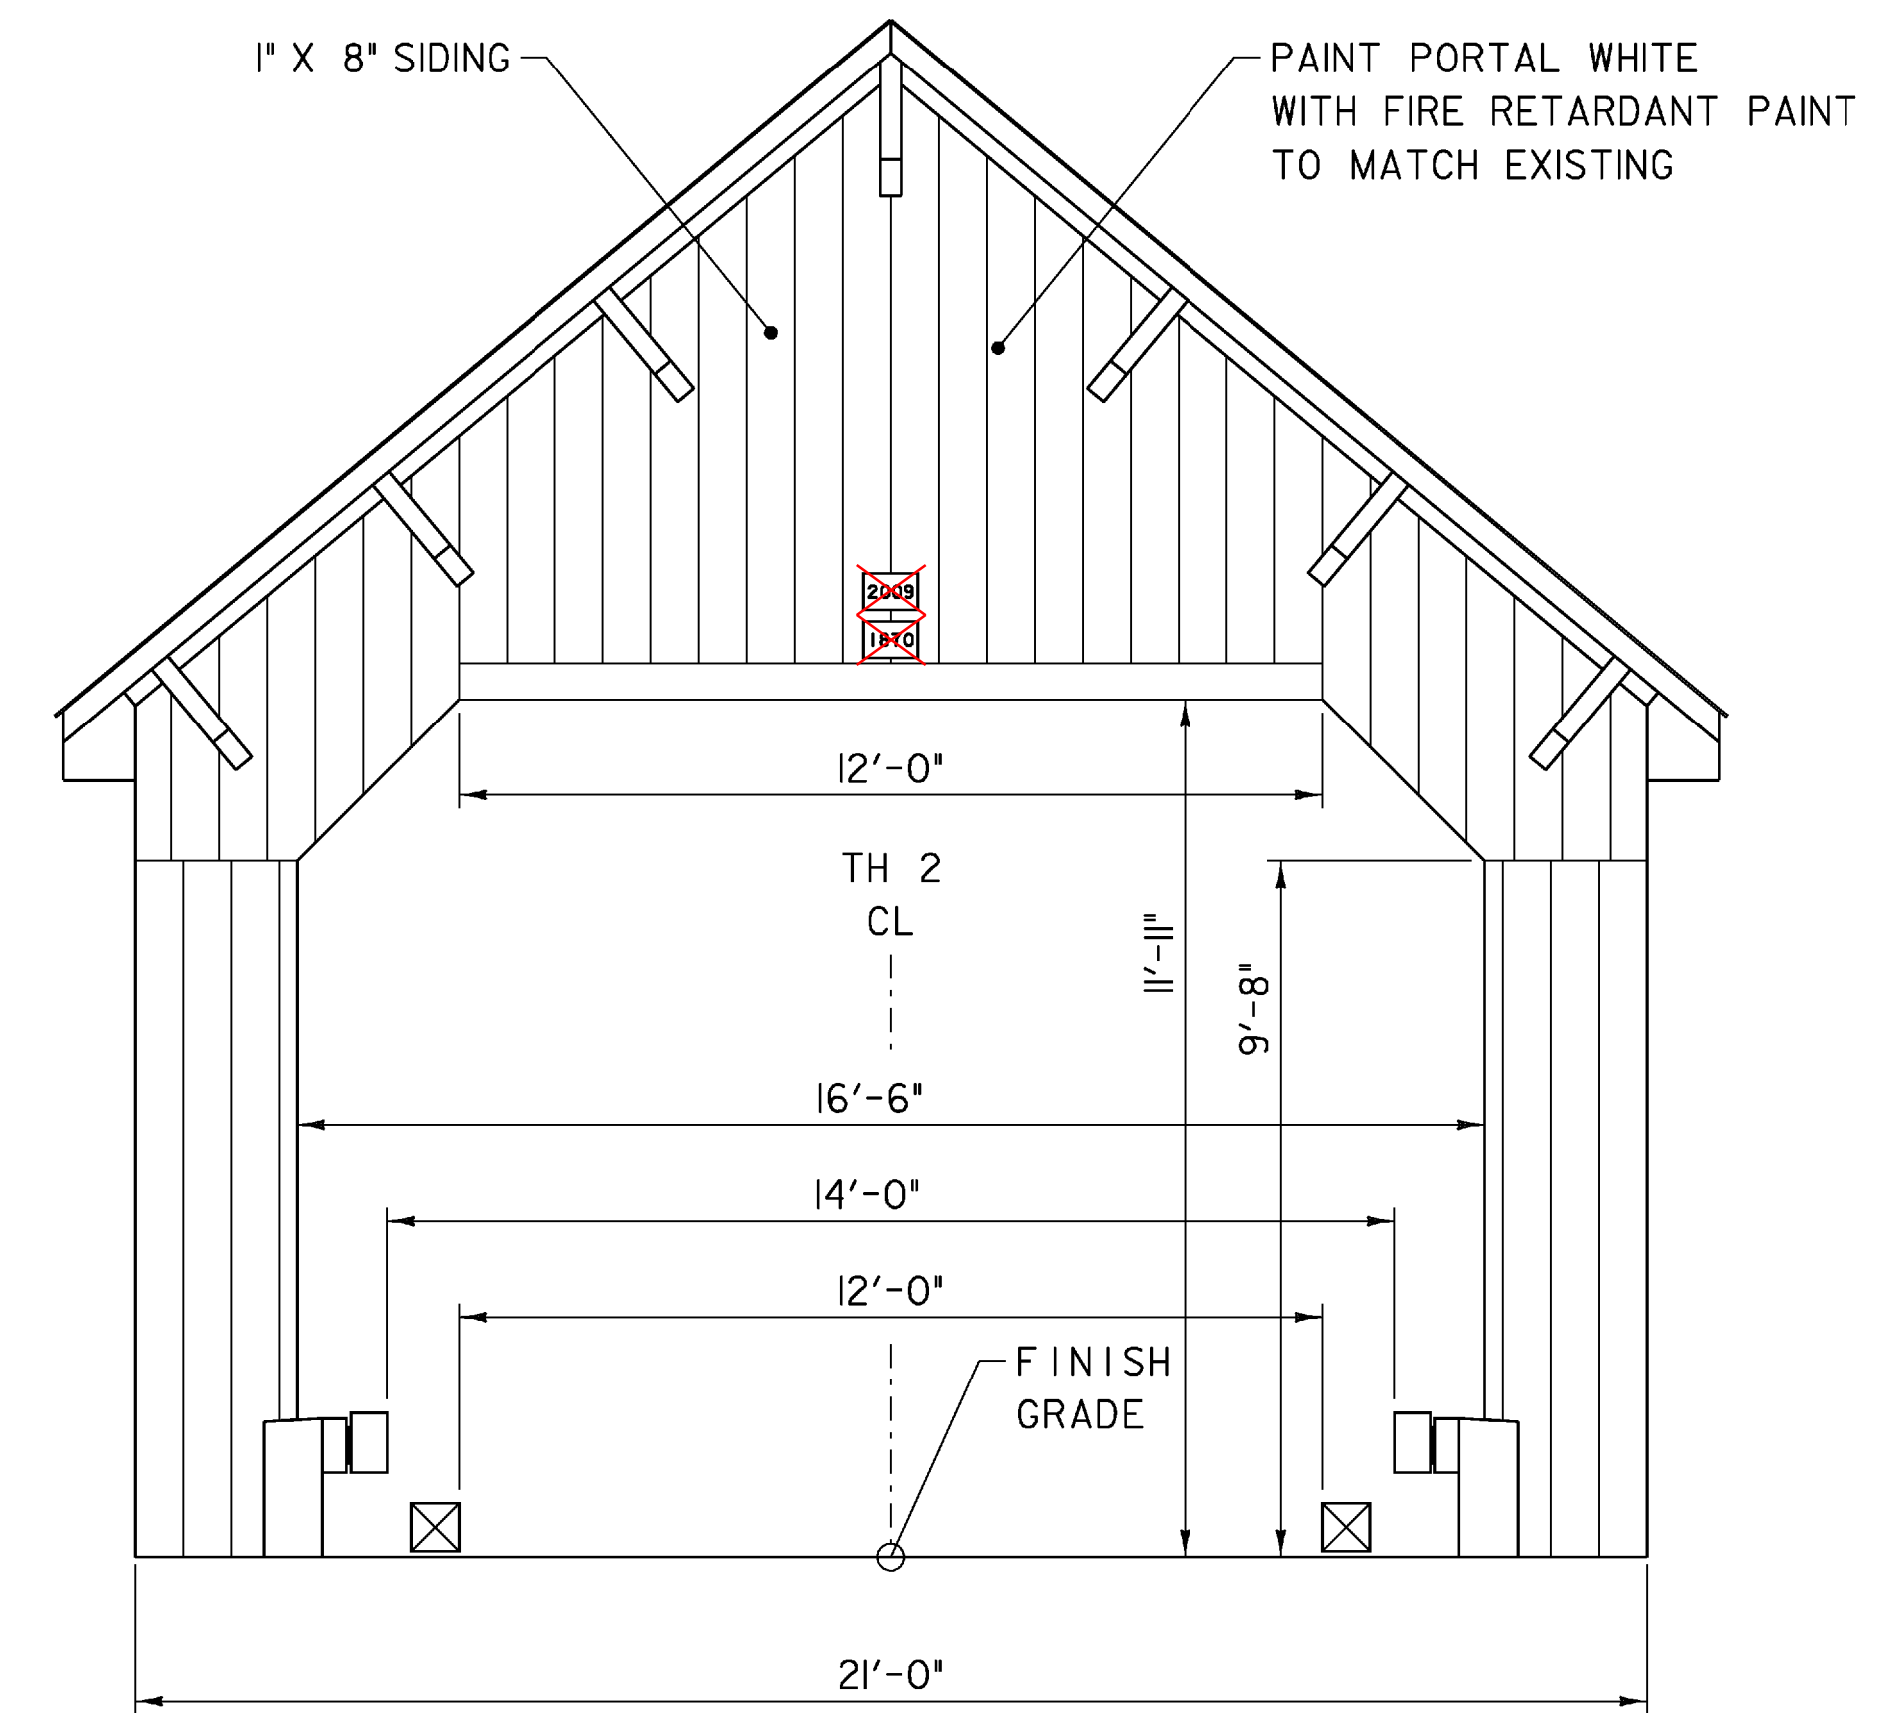

EAST PORTAL
ABUTMENT 2

SCALE 3/8" = 1'-0"
 1 0 1 2 3 4

PROJECT NAME: NEWFANE
 PROJECT NUMBER: BHF 0106 (4)S

FILE NAME: s96j230+yp.dgn
 PROJECT LEADER: R. WHITCOMB
 DESIGNED BY: T. LACKEY
 TYPICAL SECTIONS PORTALS

PLOT DATE: 29-APR-2009
 DRAWN BY: T. LACKEY
 CHECKED BY: R. WHITCOMB
 SHEET 7 OF 67