



TH 2  
SO. NEWFANE

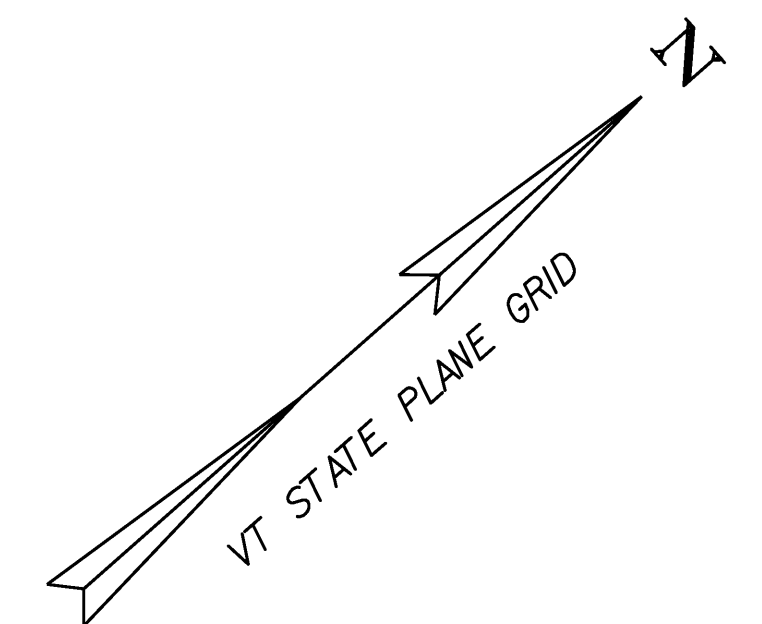

CURVE DATA  
PI ML STA. 8+13.23 BK  
DELTA= 13°05'13" LT  
D = 1°56'26"  
R = 900.00 FT.  
T = 103.23 FT.  
L = 205.57 FT.  
E = 5.90 FT.

STAGING AREA

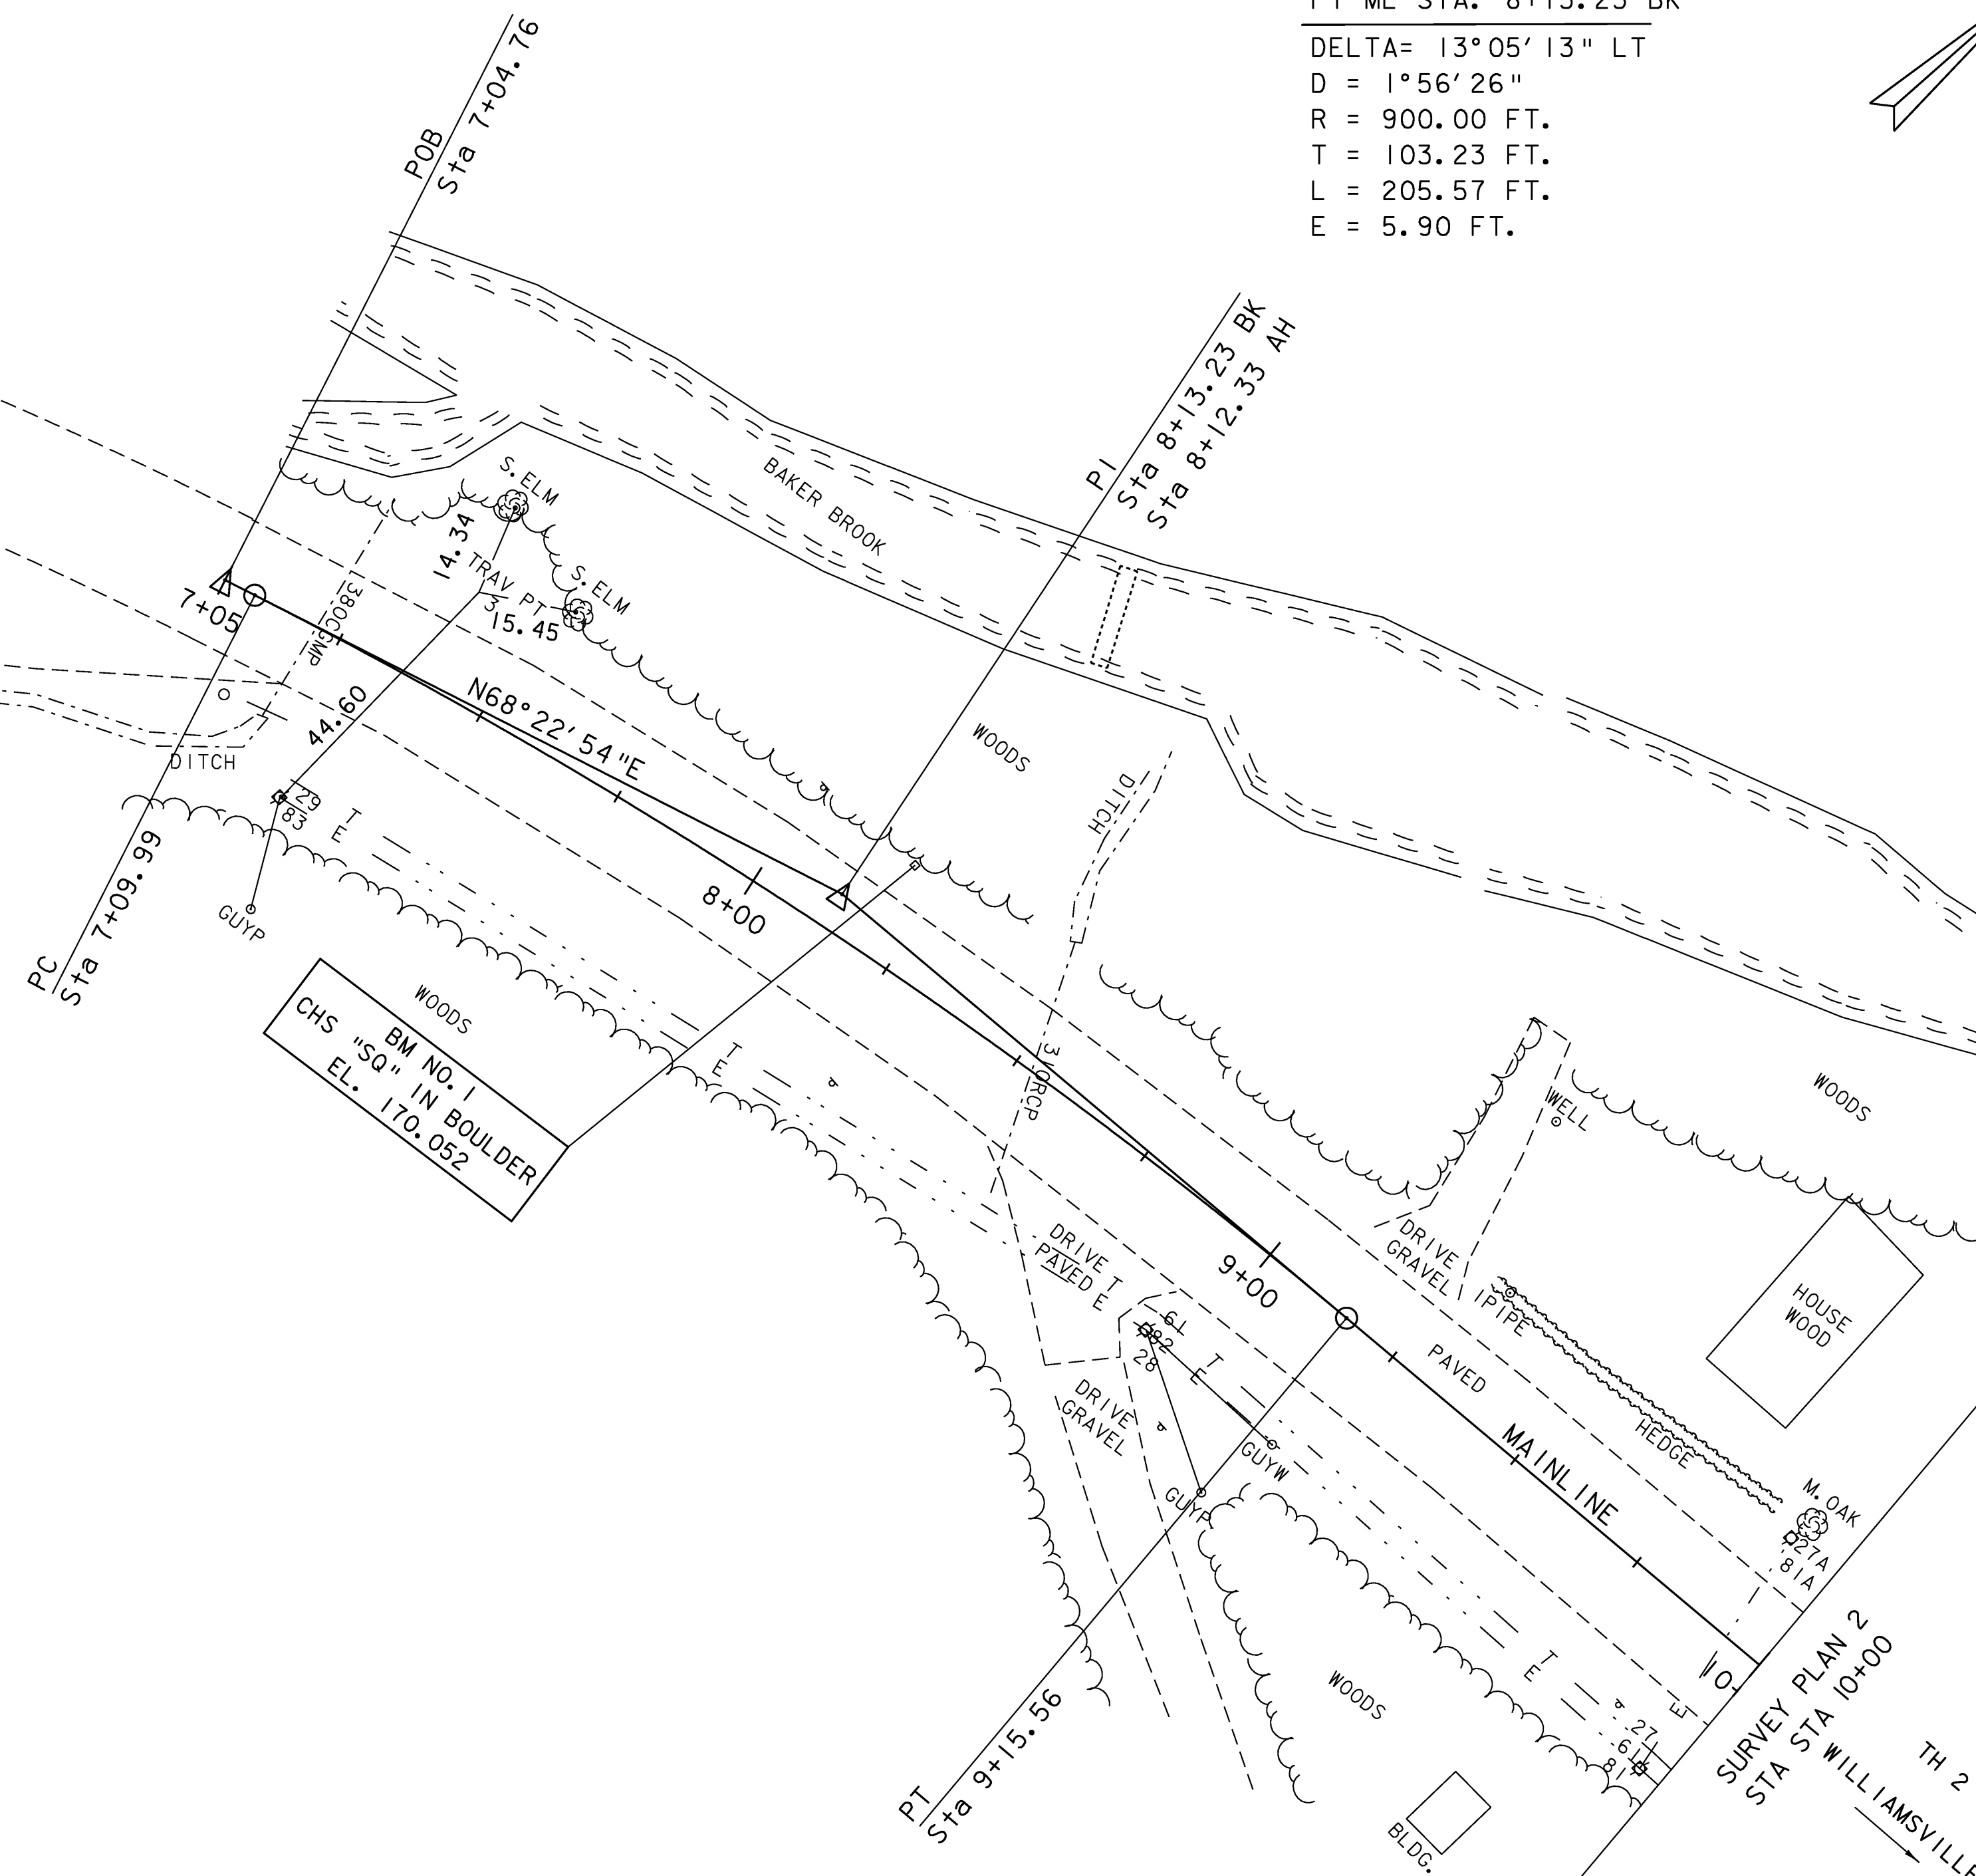

WOODS  
CHS "SQ" IN BOULDER  
BM NO. 1  
EL. 170.052

SCALE 1" = 20'-0"  
0 20

PROJECT NAME:	NEWFANE	PLOT DATE:	29-APR-2009
PROJECT NUMBER:	BHF 0106 (4)S	DRAWN BY:	T. LACKEY
FILE NAME:	s96J230bdr.dgn	CHECKED BY:	R. WHITCOMB
PROJECT LEADER:	R. WHITCOMB	SHEET	12
DESIGNED BY:	T. LACKEY	OF	67
SURVEY PLAN 1			