
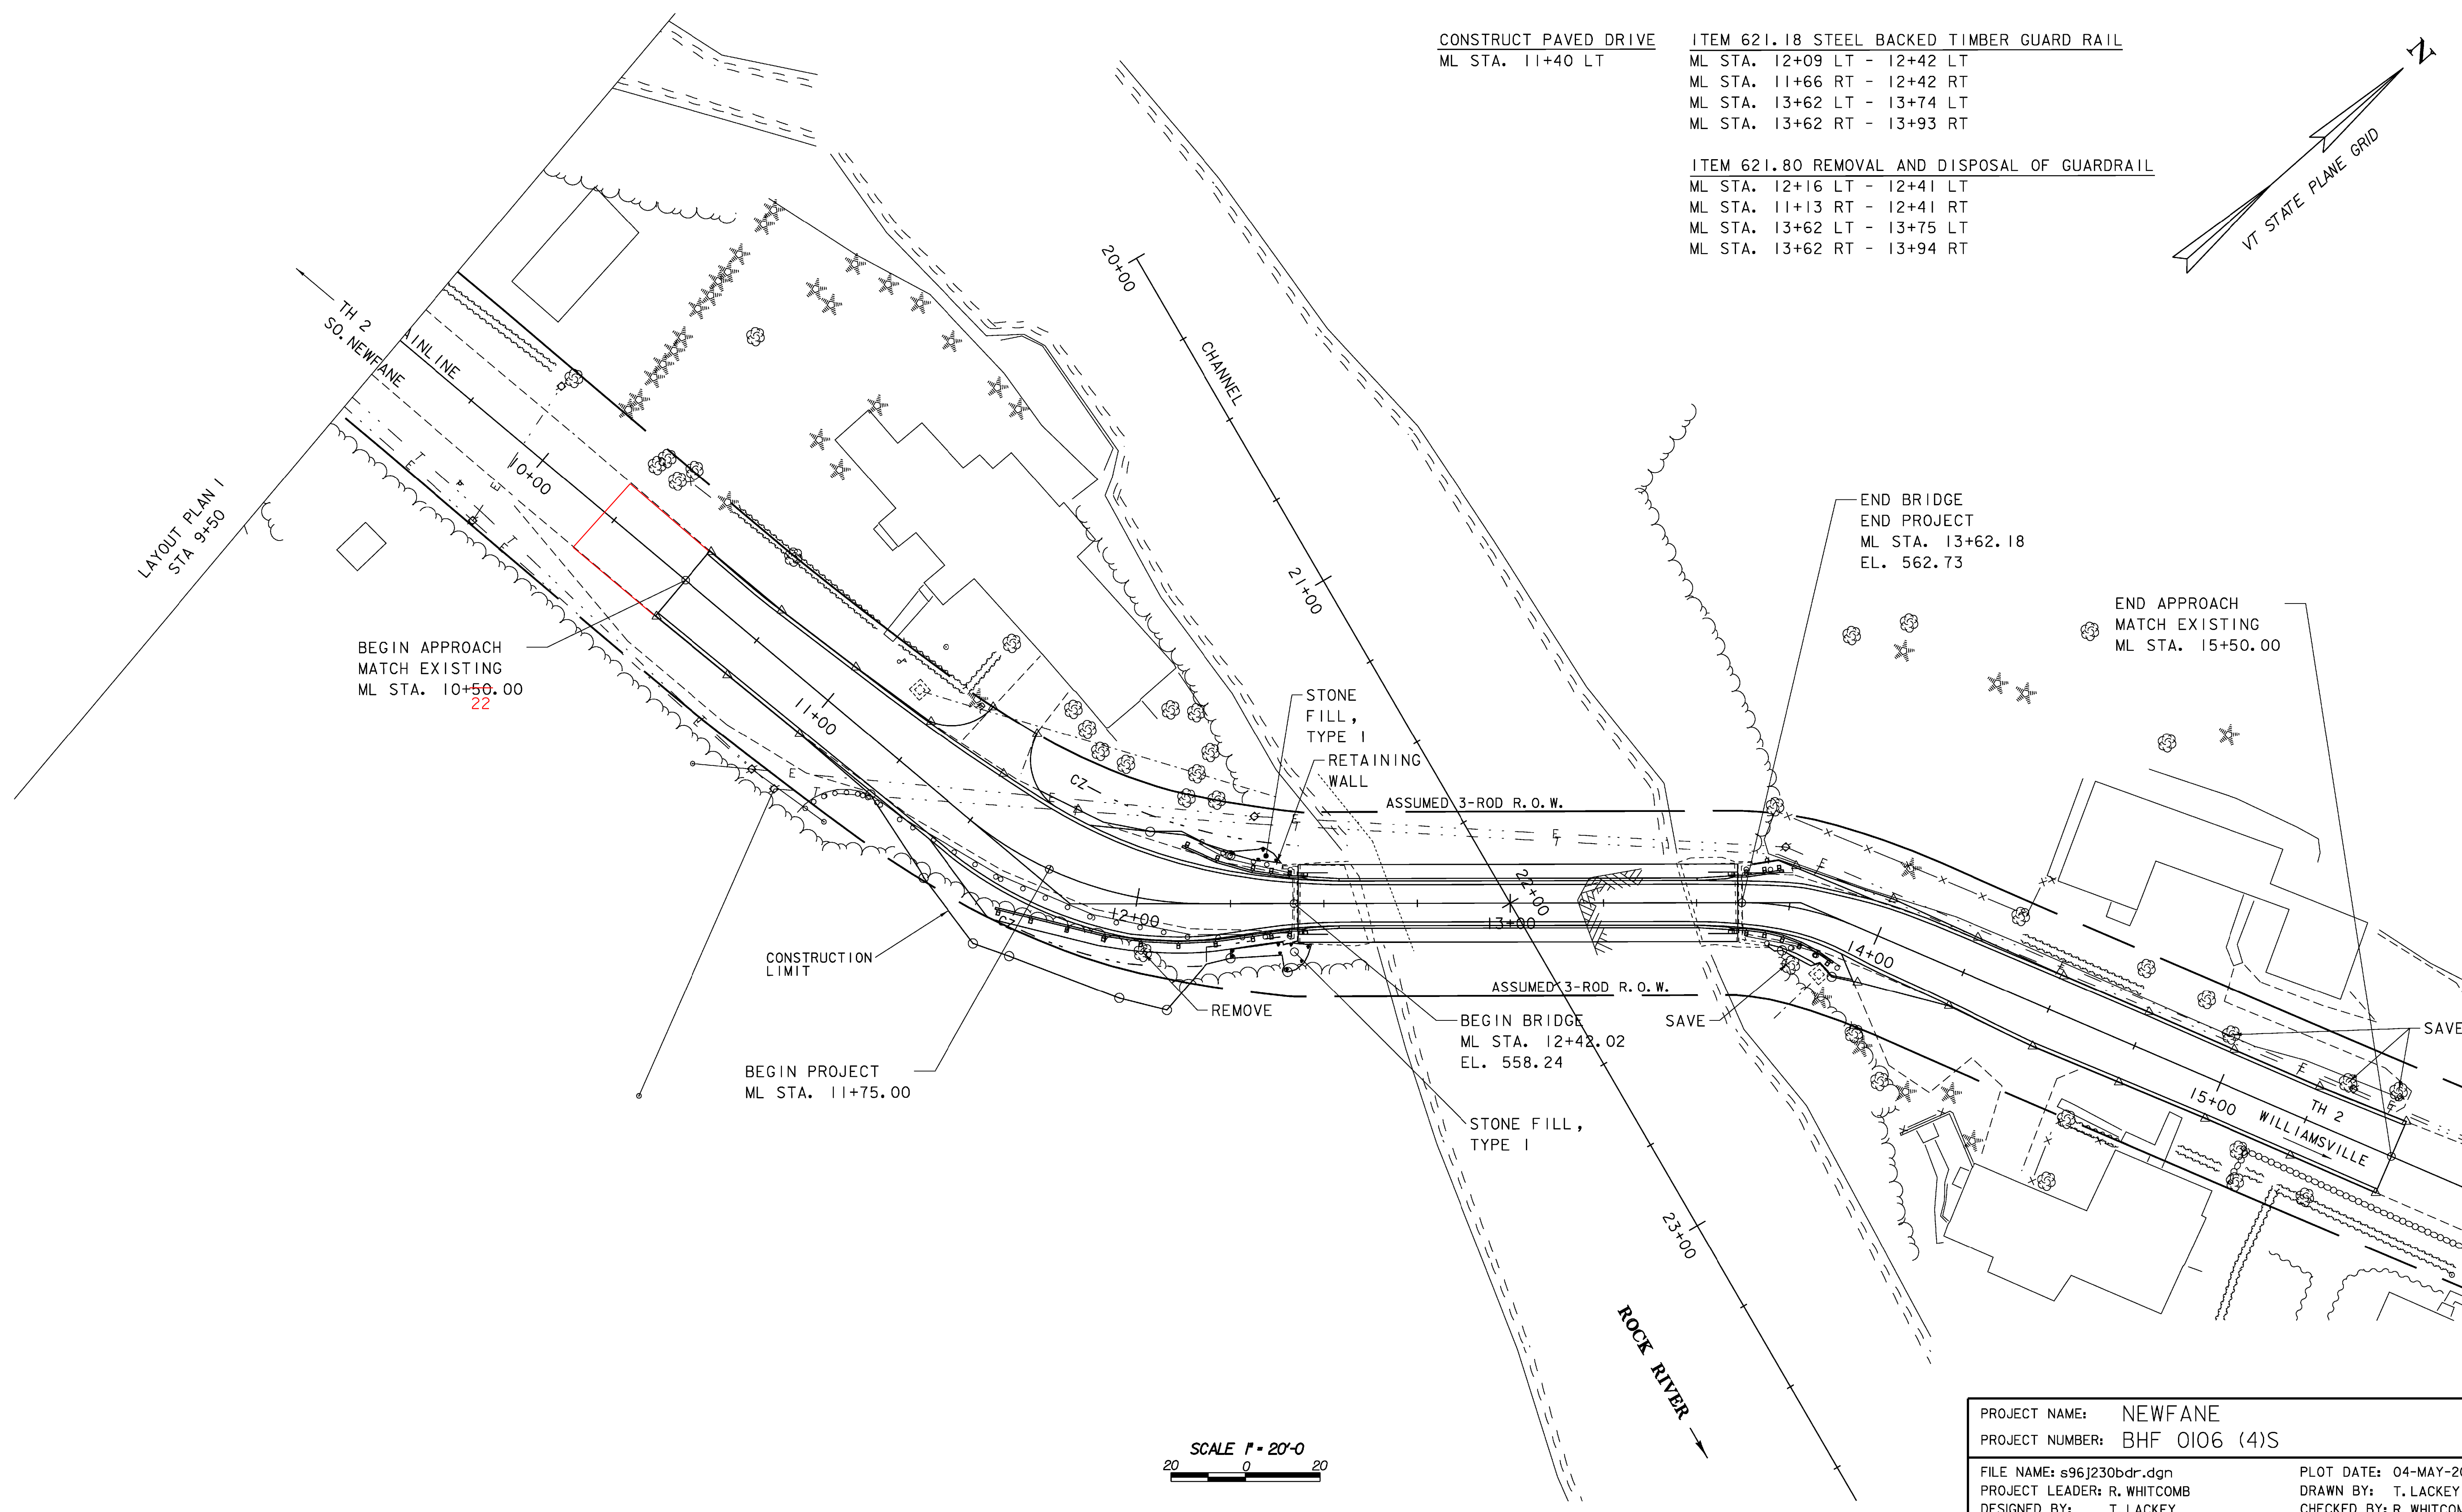


CONSTRUCT PAVED DRIVE
ML STA. 11+40 LT

ITEM 621.18 STEEL BACKED TIMBER GUARD RAIL
ML STA. 12+09 LT - 12+42 LT
ML STA. 11+66 RT - 12+42 RT
ML STA. 13+62 LT - 13+74 LT
ML STA. 13+62 RT - 13+93 RT

ITEM 621.80 REMOVAL AND DISPOSAL OF GUARDRAIL
ML STA. 12+16 LT - 12+41 LT
ML STA. 11+13 RT - 12+41 RT
ML STA. 13+62 LT - 13+75 LT
ML STA. 13+62 RT - 13+94 RT

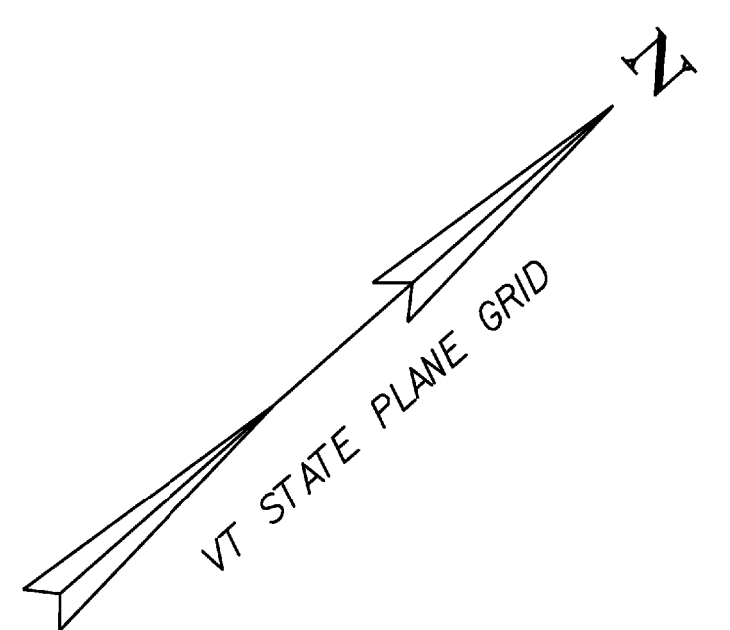

BEGIN APPROACH
MATCH EXISTING
ML STA. 10+50.00
22

BEGIN PROJECT
ML STA. 11+75.00

BEGIN BRIDGE
ML STA. 12+42.02
EL. 558.24

END BRIDGE
END PROJECT
ML STA. 13+62.18
EL. 562.73

END APPROACH
MATCH EXISTING
ML STA. 15+50.00

SCALE 1" = 20'-0"
20 0 20

PROJECT NAME:	NEWFANE	PLOT DATE:	04-MAY-2009
PROJECT NUMBER:	BHF 0106 (4)S	DRAWN BY:	T. LACKEY
FILE NAME:	s96J230bdr.dgn	CHECKED BY:	R. WHITCOMB
PROJECT LEADER:	R. WHITCOMB	LAYOUT PLAN 2	SHEET 15 OF 67