

BEGIN APPROACH  
MATCH EXISTING  
ML 10+50.00

BEGIN BRIDGE  
ML 12+42.02  
EL. 558.24

END BRIDGE  
END PROJECT  
MATCH EXISTING  
ML 13+62.18  
EL. 562.73


END APPROACH  
MATCH EXISTING  
ML 15+50.00

COLTON LOAMY  
FINE SAND 15-25%  
(NO RAISING)  
Kw = 0.17 LOW

COLTON LOAMY  
FINE SAND 2-8%  
(STATEWIDE)  
Kw = 0.17 LOW

LEGEND	
- HISTORIC DIST -	HISTORIC DISTRICT BOUNDARY IDENTIFIED BY VAOT HISTORIAN (REFER TO HISTORIAN'S REPORT)
[ HISTORIC ]	HISTORIC STRUCTURES IDENTIFIED BY VAOT HISTORIAN
- ARCH -	LIMITS OF ARCHEOLOGICALLY SENSITIVE AREAS (REFER TO ARCHEOLOGICAL RESOURCE REPORT)
- PREHISTORIC -	ARCHEOLOGICALLY SENSITIVE FOR PREHISTORIC RESOURCES
- HISTORIC -	ARCHEOLOGICALLY SENSITIVE FOR HISTORIC RESOURCES
SLOPE	ARCHEOLOGIST'S DESCRIPTION OF TERRAIN (TYP.)
▲	WETLAND BOUNDARY
◆ 2B	WETLAND TRANSECT DATA POINT
- - - - -	50' RIPARIAN BUFFER

BEGIN PROJECT  
ML 11+75.00

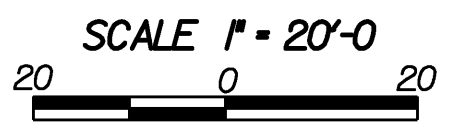

PROJECT NAME:	NEWFANE	PROJECT NUMBER:	BHF 0106 (4)S
FILE NAME:	s96J230ero.dgn	PLOT DATE:	29-APR-2009
PROJECT LEADER:	R.WHITCOMB	DRAWN BY:	T. LACKEY
DESIGNED BY:	T. LACKEY	CHECKED BY:	R.WHITCOMB
EPSC EXISTING SITE PLAN		SHEET 21	OF 67