


- LEGEND**
- Project Demarcation Fence
 - Silt Fences
 - Temporary Erosion Matting
 - Vehicle Tracking Pad
 - Inlet Protection Device, Type I

- LEGEND**
- 50' Riparian Buffer
 - Soil Line
 - Wetland Limit
 - R.O.W. & Property Lines

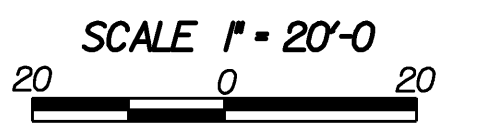

PROJECT NAME:	NEWFANE	PLOT DATE:	29-APR-2009
PROJECT NUMBER:	BHF 0106 (4)S	DRAWN BY:	T. LACKEY
FILE NAME:	s96j230ero.dgn	CHECKED BY:	R.WHITCOMB
PROJECT LEADER:	R.WHITCOMB	EPSC CONSTRUCTION SITE PLAN	SHEET 22 OF 67
DESIGNED BY:	T. LACKEY		