



PLAN

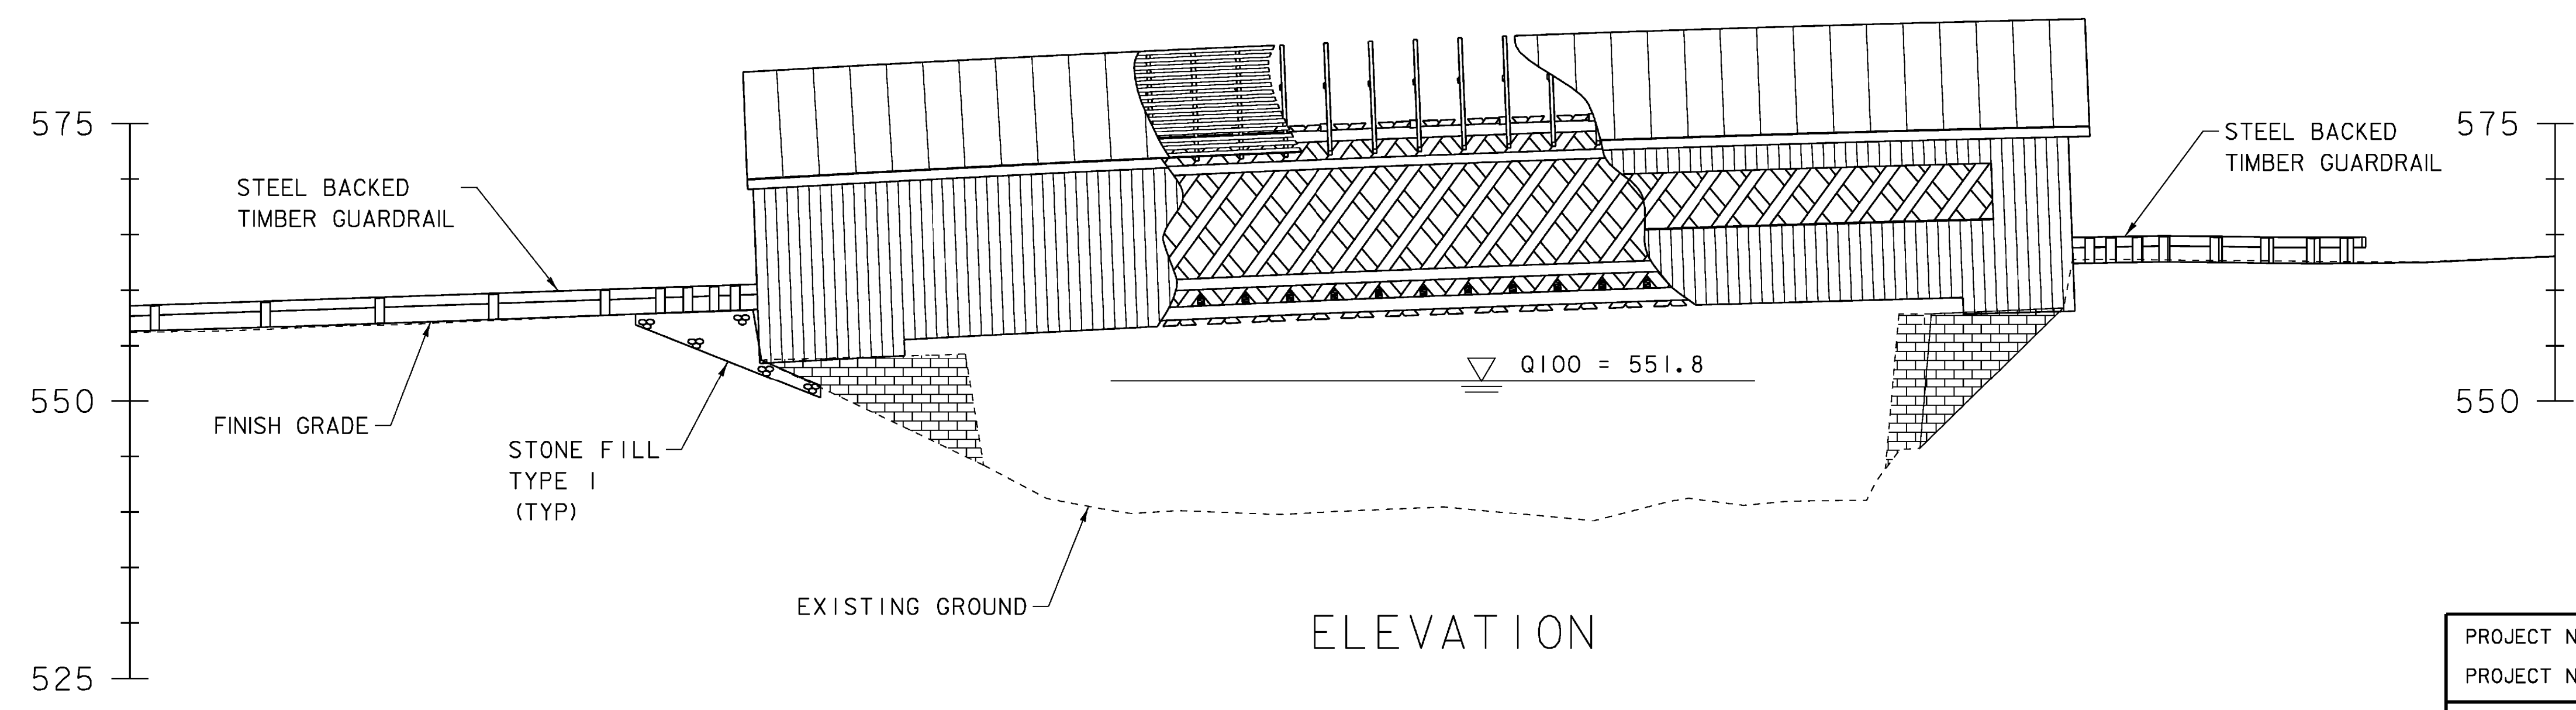

ELEVATION

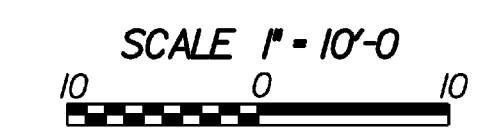

PROJECT NAME:	NEWFANE	PLOT DATE:	29-APR-2009
PROJECT NUMBER:	BHF 0106 (4)S	DRAWN BY:	T. LACKEY
FILE NAME:	s96j230pe.dgn	CHECKED BY:	R. WHITCOMB
PROJECT LEADER:	R. WHITCOMB	DESIGNED BY:	T. LACKEY
DESIGNED BY:	T. LACKEY	PLAN & ELEVATION	SHEET 30 OF 67