


ABUTMENT 1
BRIDGE END ELEVATION
ABUTMENT WAS LONGER THAN SHOWN

THE EXISTING BEARING AREAS ARE SLOPED LONGITUDINALLY WITH THE GRADE.

12" W X 20" L BEDDING BLOCK
ADJUST BEDDING BLOCK DEPTHS SO FINISH GRADE
OF DECK IS LEVEL WITH THE TOP OF THE BACKWALL

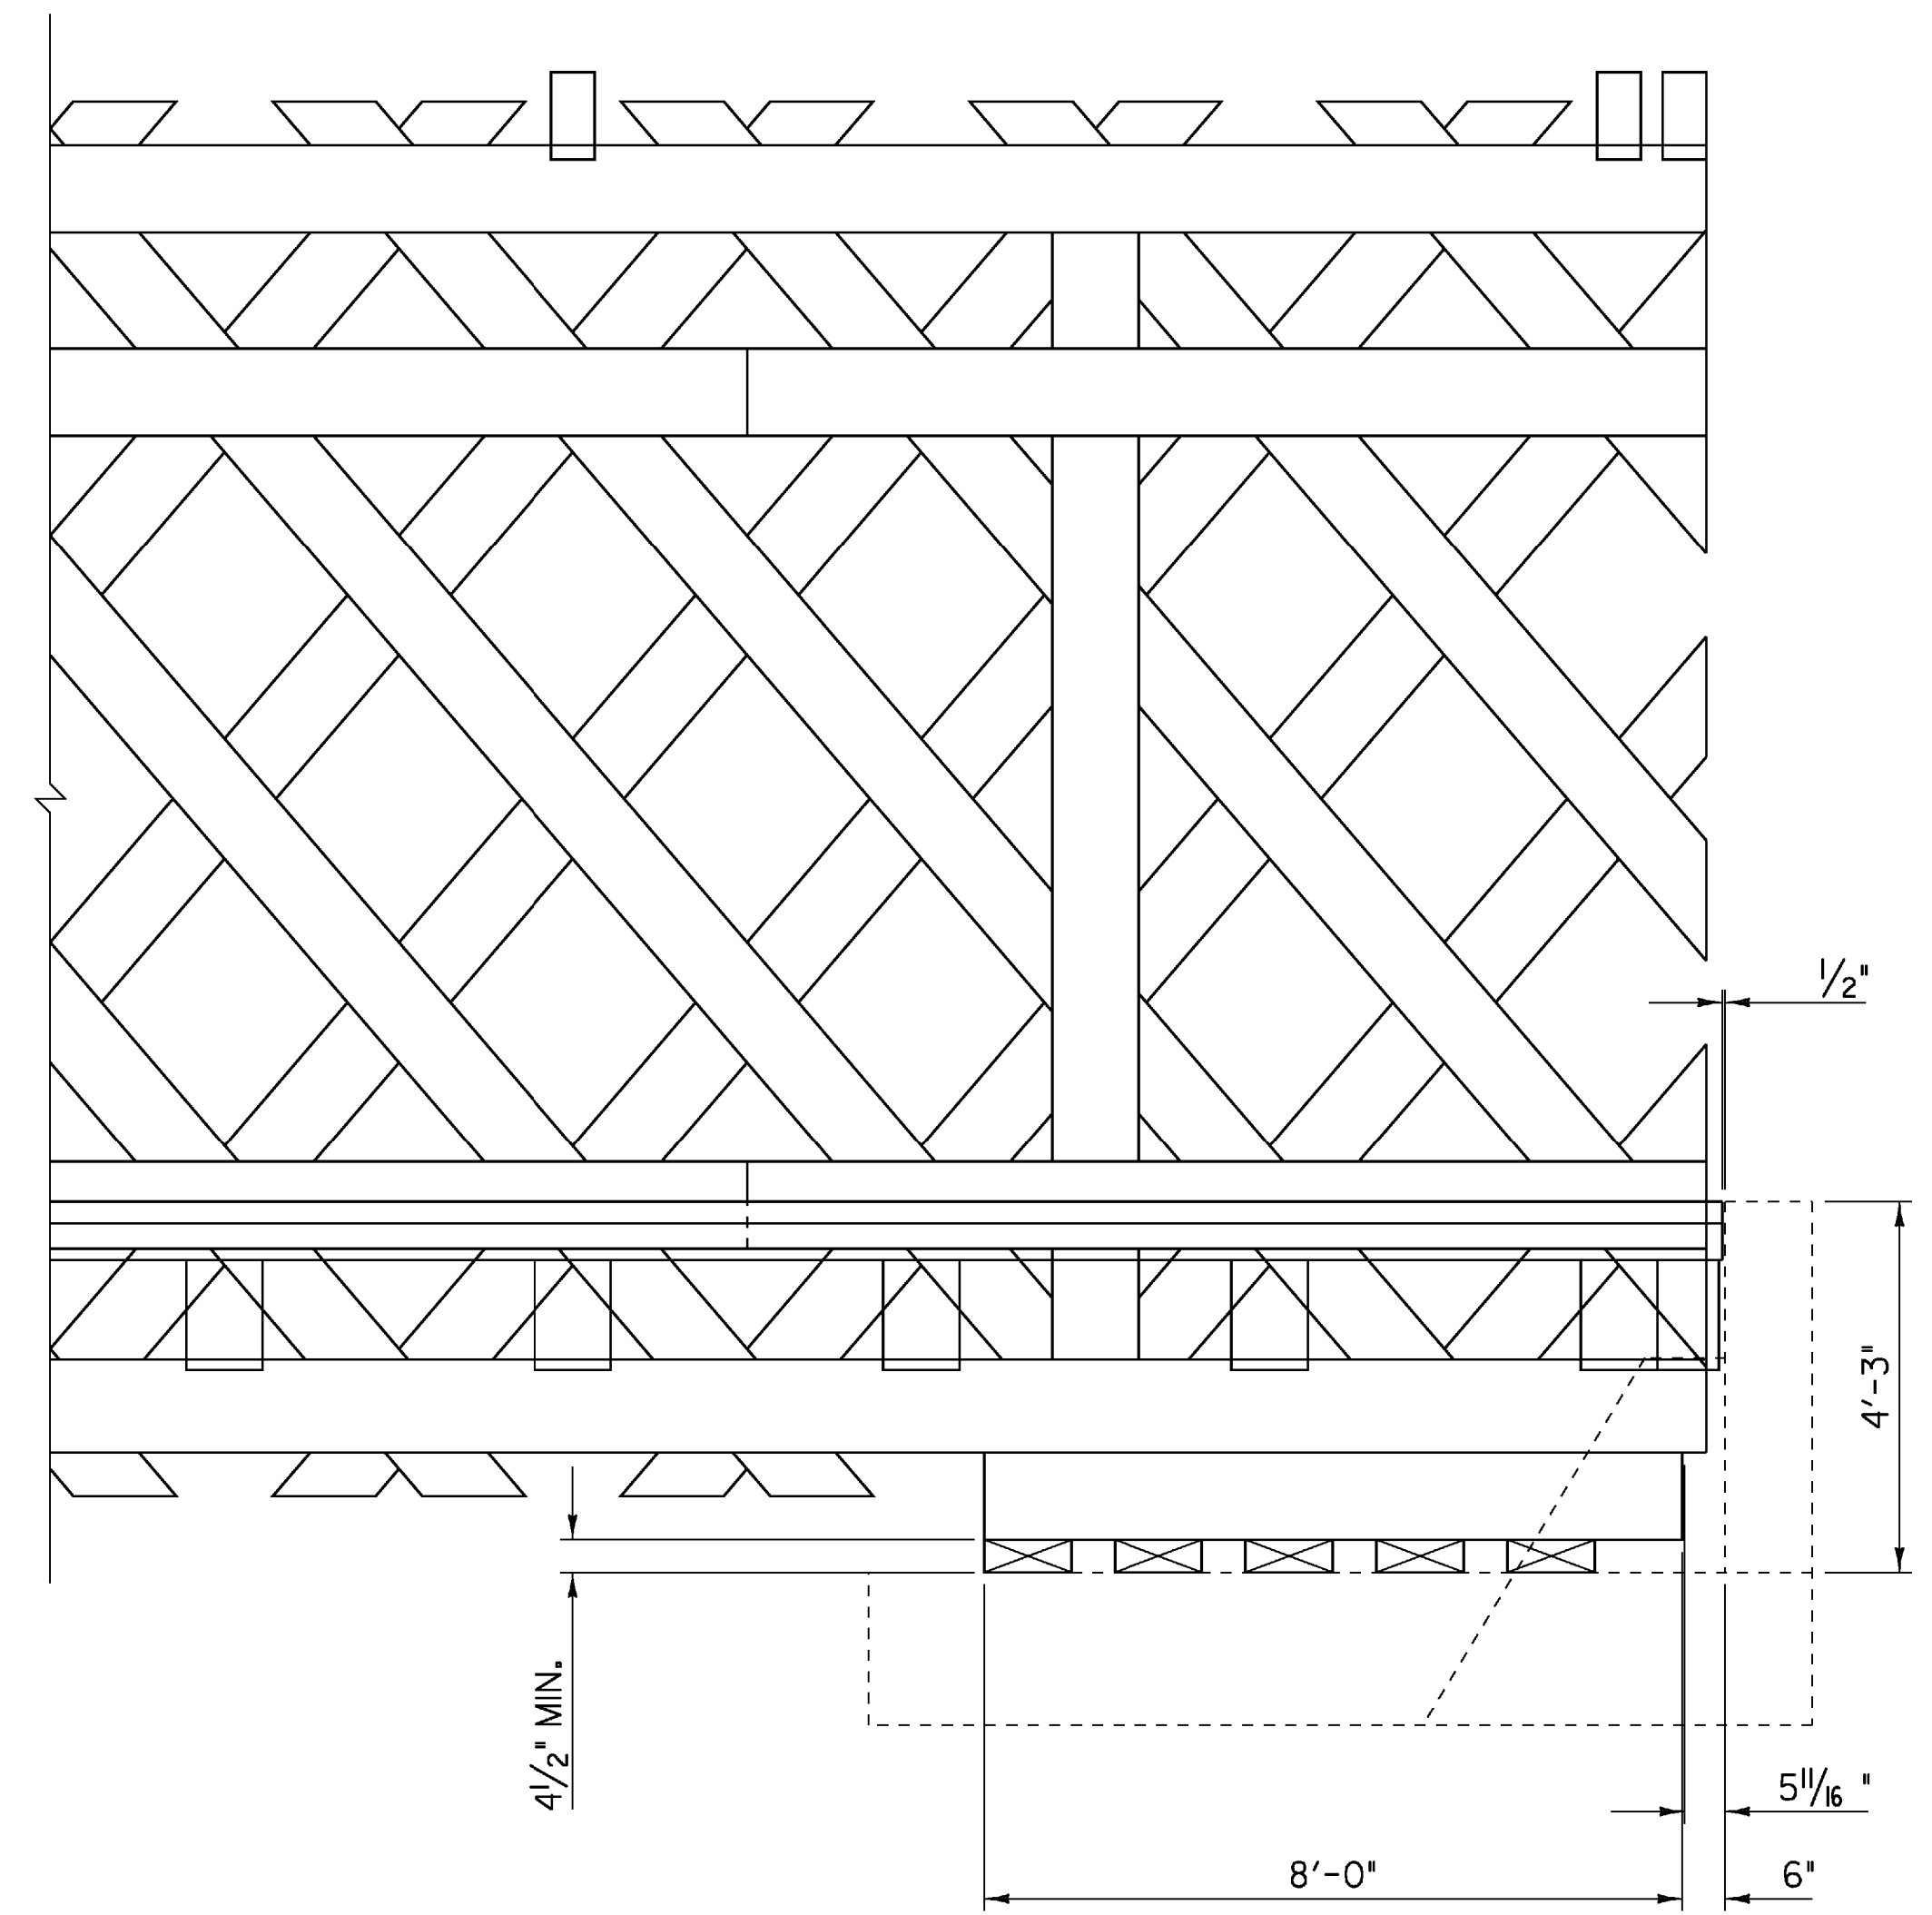

ABUTMENT 2
BRIDGE END ELEVATION

SCALE 1/2" = 1'-0"
1 0 1 2

PROJECT NAME: NEWFANE
PROJECT NUMBER: BHF 0106 (4)S

FILE NAME: s96j230str.dgn
PROJECT LEADER: R. WHITCOMB
DESIGNED BY: T. LACKEY
BRIDGE END DETAILS

PLOT DATE: 29-APR-2009
DRAWN BY: T. LACKEY
CHECKED BY: R. WHITCOMB
SHEET 35 OF 67