



LOWER LATERAL BRACING PLAN

SCALE $\frac{3}{16}'' = 1'-0''$
 1 0 2 4 6 8

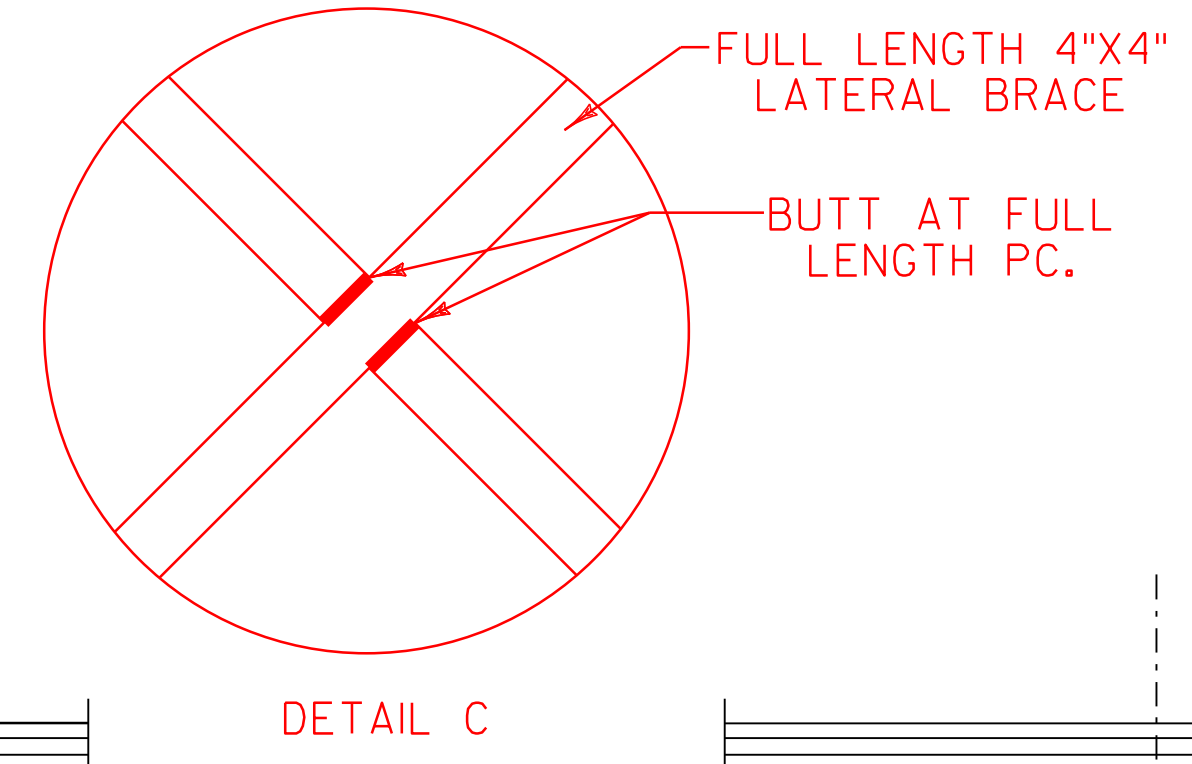


DETAIL C

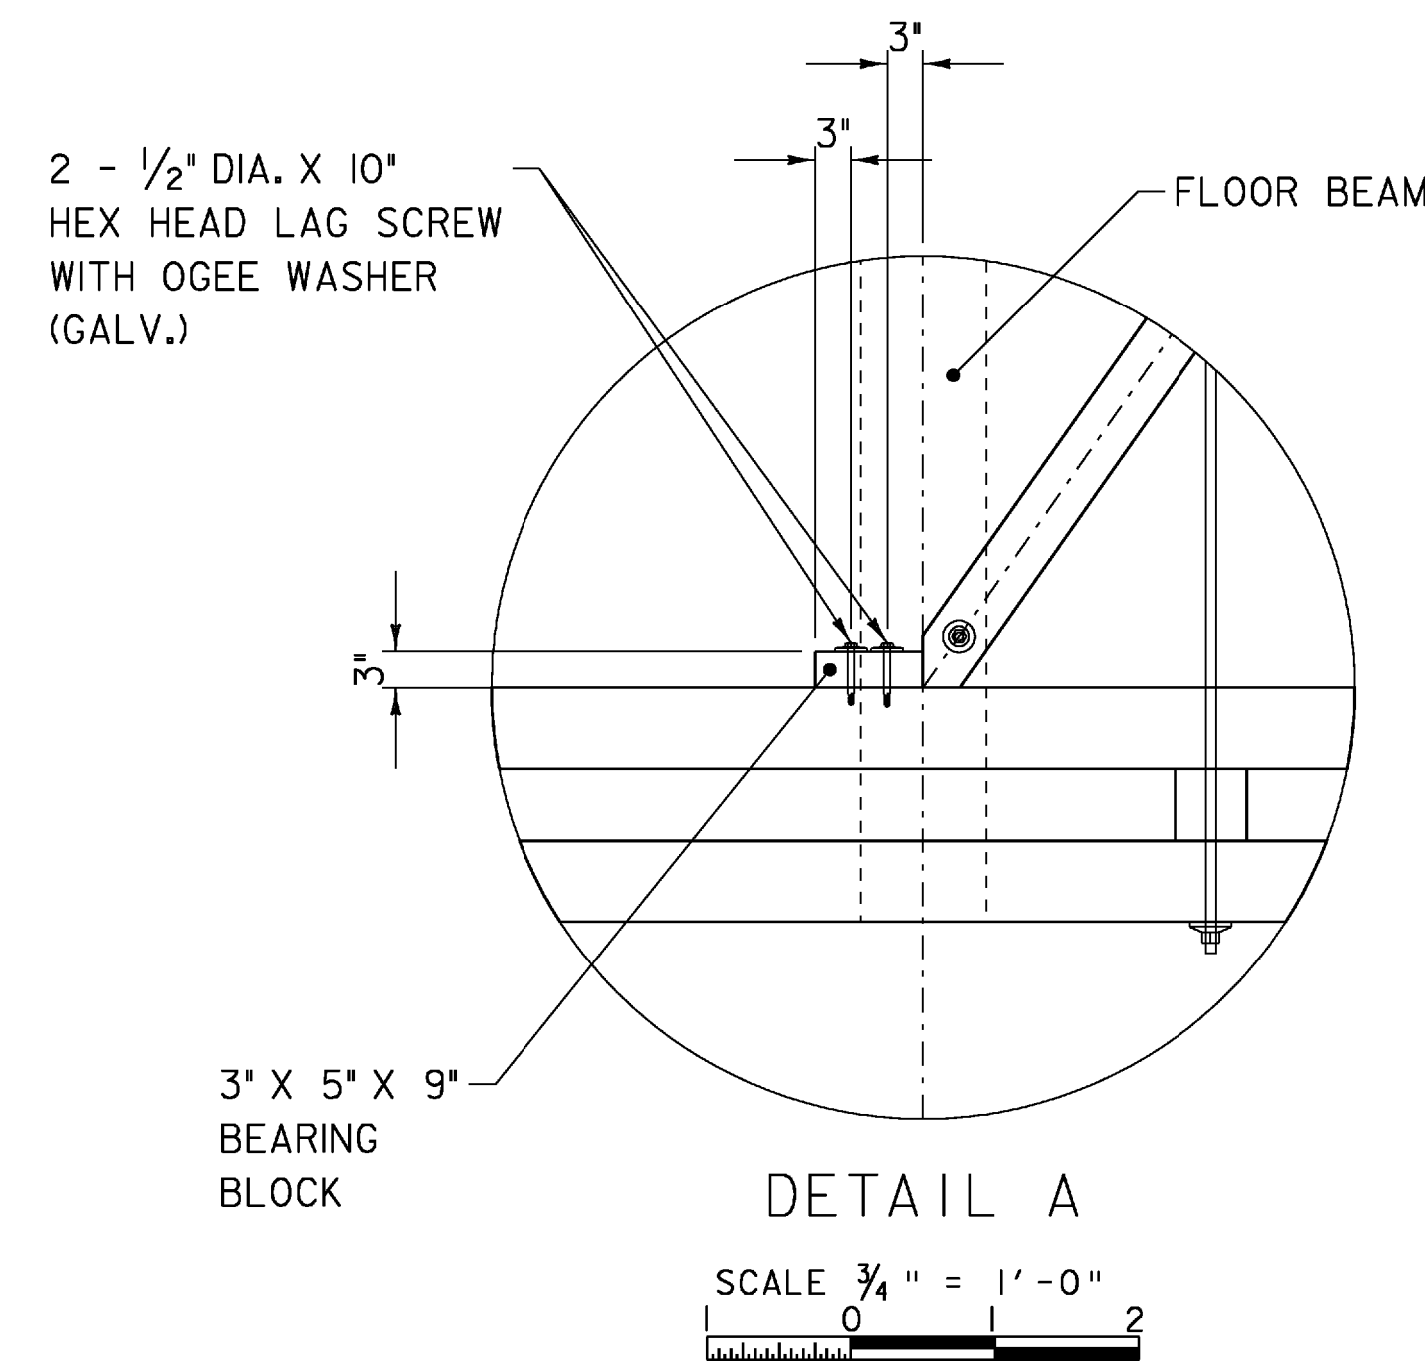


DETAIL A

SCALE $\frac{3}{4}'' = 1'-0''$
 0 1 2

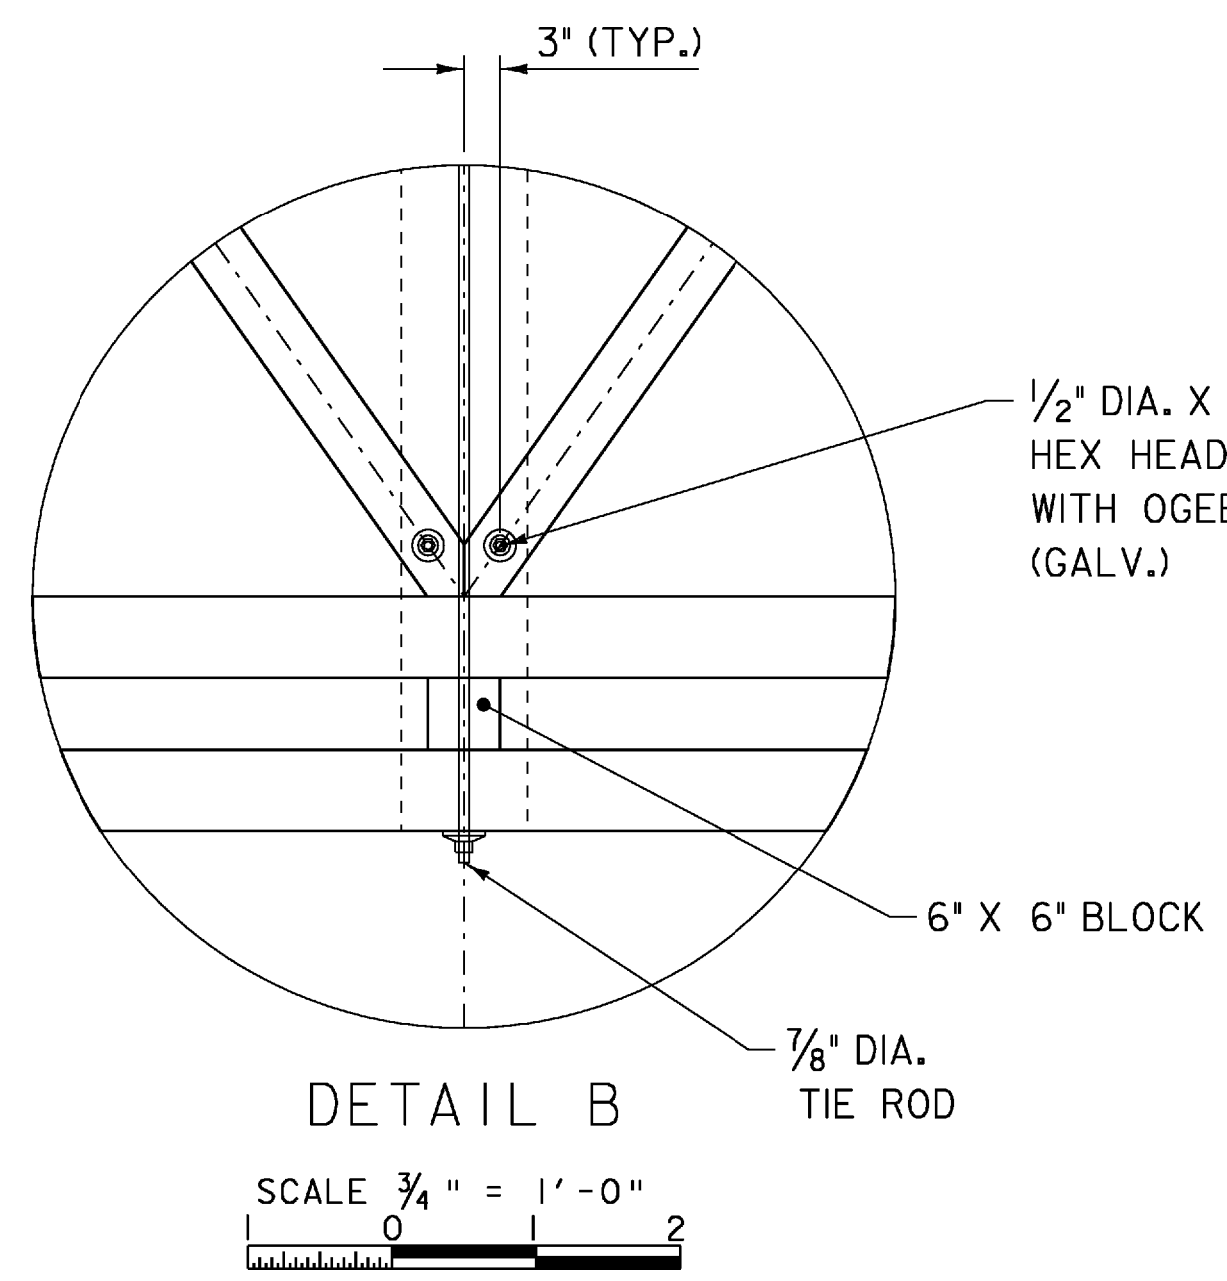


DETAIL B

SCALE $\frac{3}{4}'' = 1'-0''$
 0 1 2

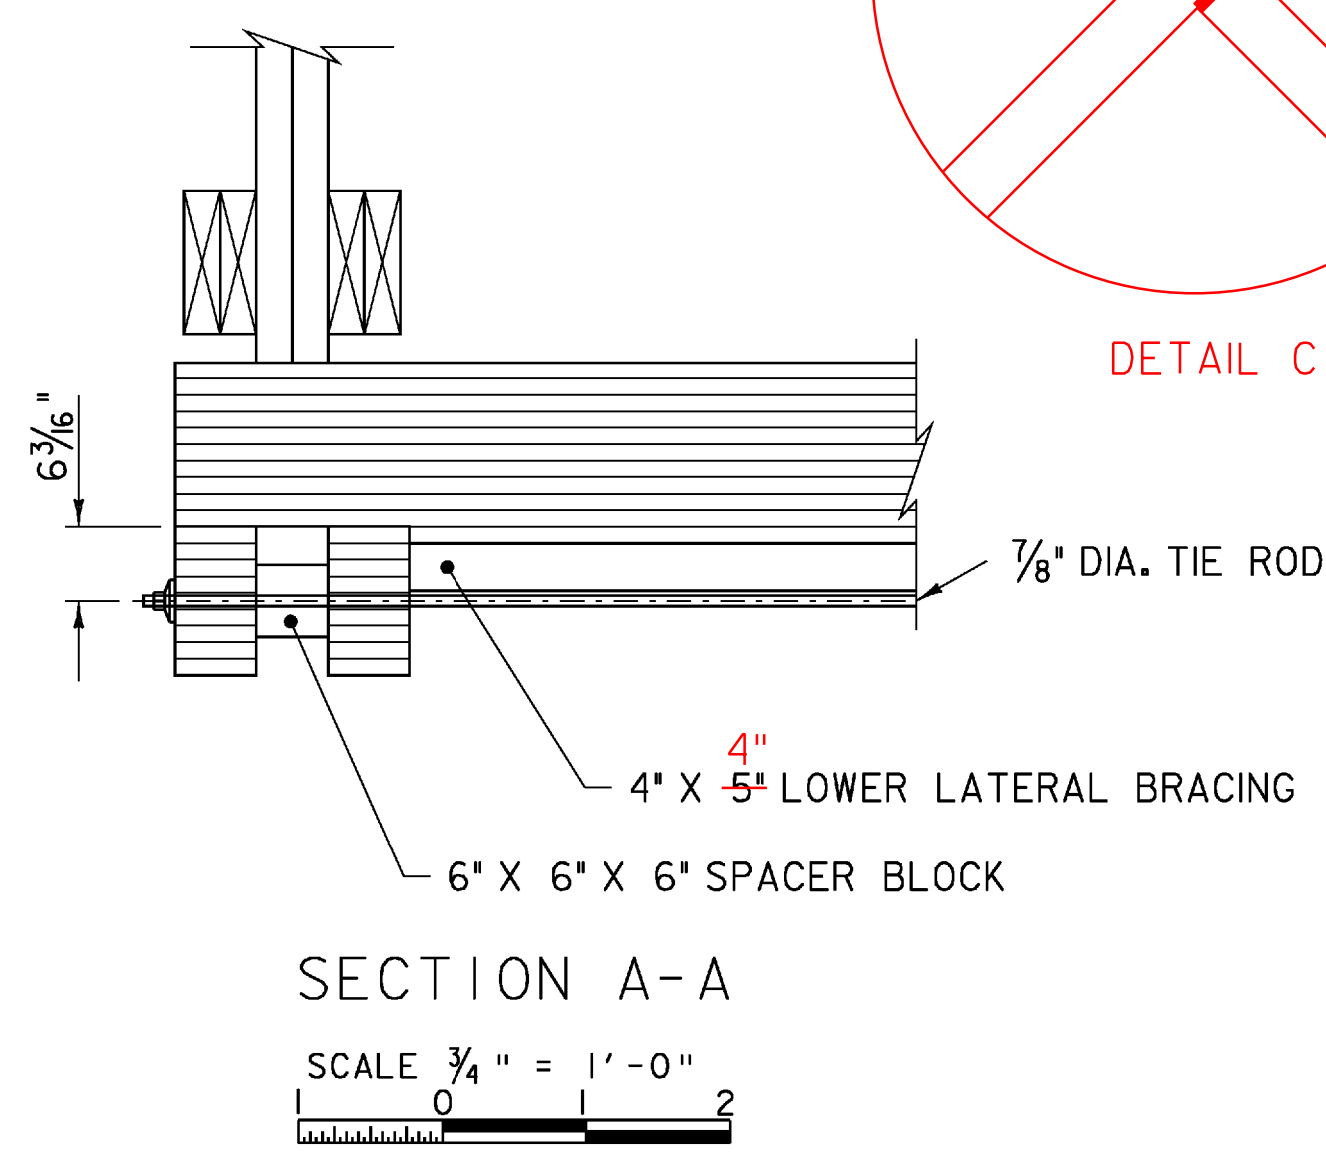


SECTION A-A

SCALE $\frac{3}{4}'' = 1'-0''$
 0 1 2

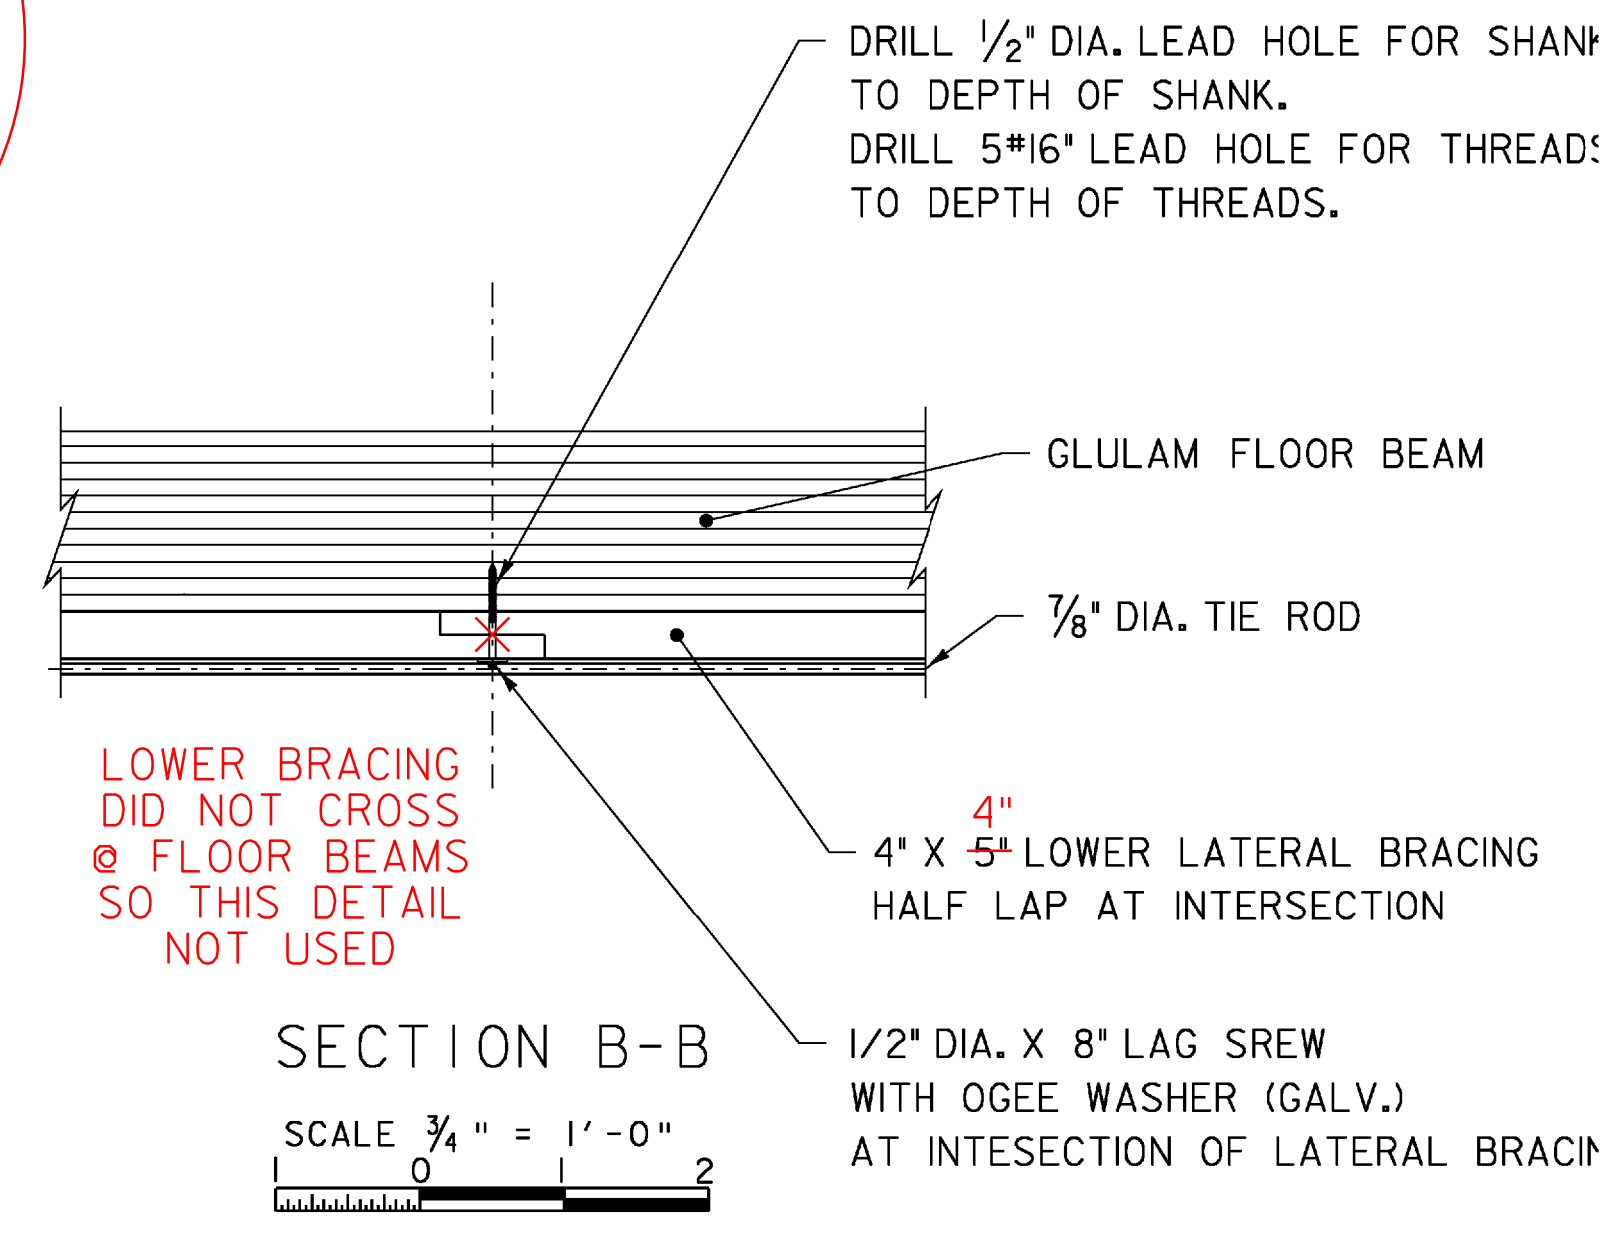

SECTION B-B

SCALE $\frac{3}{4}'' = 1'-0''$
 0 1 2

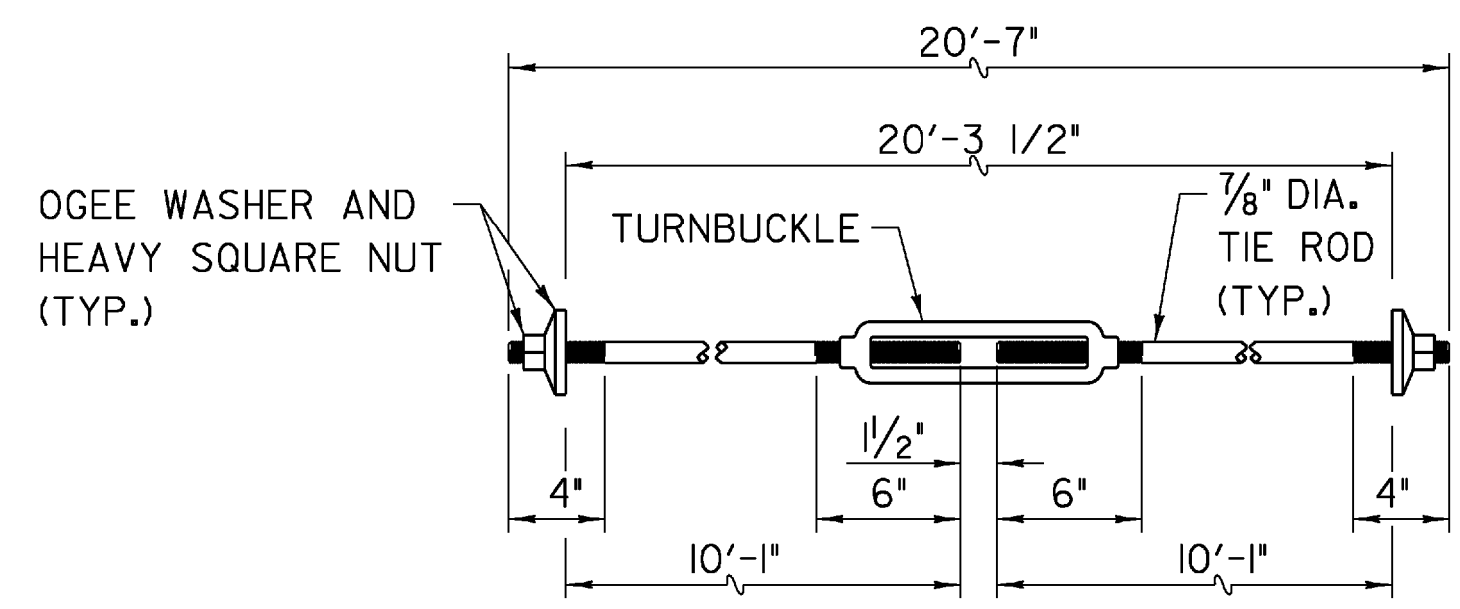

STRUCTURAL STEEL GALVANIZED TIE ROD ASSEMBLY

SCALE: $1\frac{1}{2}'' = 1'-0''$
 1 0 1 2

PROJECT NAME: NEWFANE	PLOT DATE: 29-APR-2009
PROJECT NUMBER: BHF 0106 (4)S	DRAWN BY: T. LACKEY
FILE NAME: s96j230str.dgn	CHECKED BY: R. WHITCOMB
PROJECT LEADER: R. WHITCOMB	SHEET 36 OF 67
DESIGNED BY: T. LACKEY	
LOWER LATERAL BRACING DETAILS	