


LEFT TRUSS PROFILE
(LOOKING DOWNSTREAM)

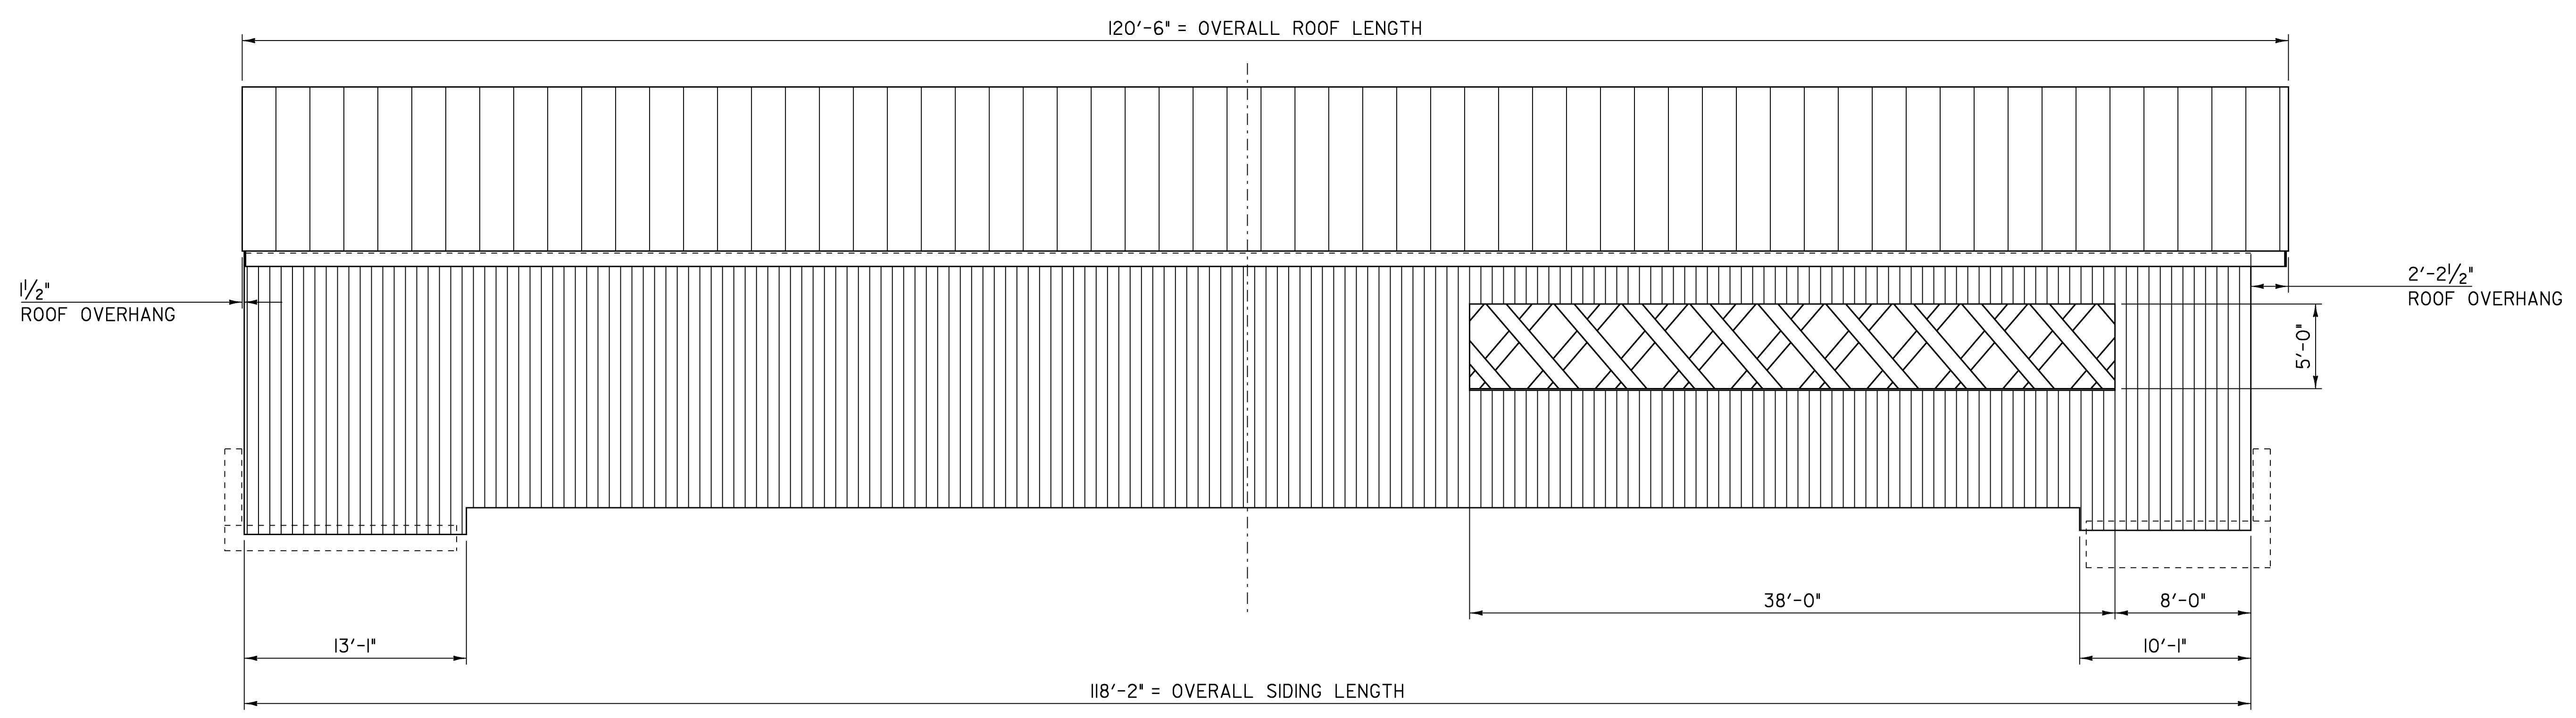

RIGHT TRUSS PROFILE
(LOOKING UPSTREAM)

SCALE 3/16" = 1'-0"
0 2 4 6 8

PROJECT NAME:	NEWFANE	PLOT DATE:	29-APR-2009
PROJECT NUMBER:	BHF 0106 (4)S	DRAWN BY:	T. LACKEY
FILE NAME:	s96j230str.dgn	CHECKED BY:	R. WHITCOMB
PROJECT LEADER:	R. WHITCOMB	SHEET	50 OF 67
DESIGNED BY:	T. LACKEY		
SIDING DETAILS I			