
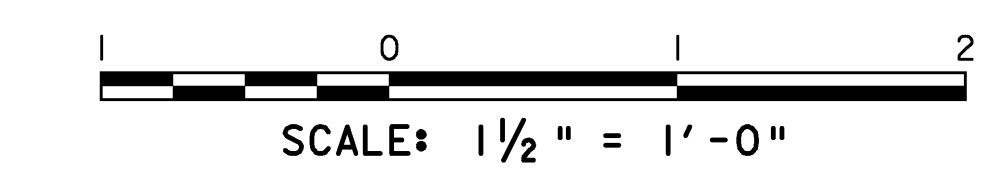


GUARDRAIL DETAIL AT END OF COVERED BRIDGE

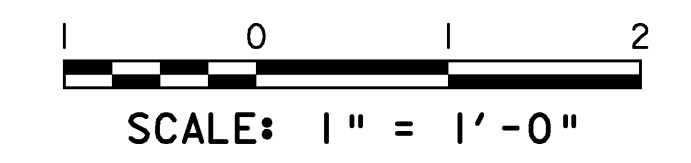

PROJECT NAME:	NEWFANE	PLOT DATE:	29-APR-2009
PROJECT NUMBER:	BHF 0106 (4)S	DRAWN BY:	STR3
FILE NAME:	s96j230r-01.dgn	CHECKED BY:	R. WHITCOMB
DESIGNED BY:	T. LACKEY	SHEET	57 OF 67
GUARDRAIL DETAILS	3		