



10+75

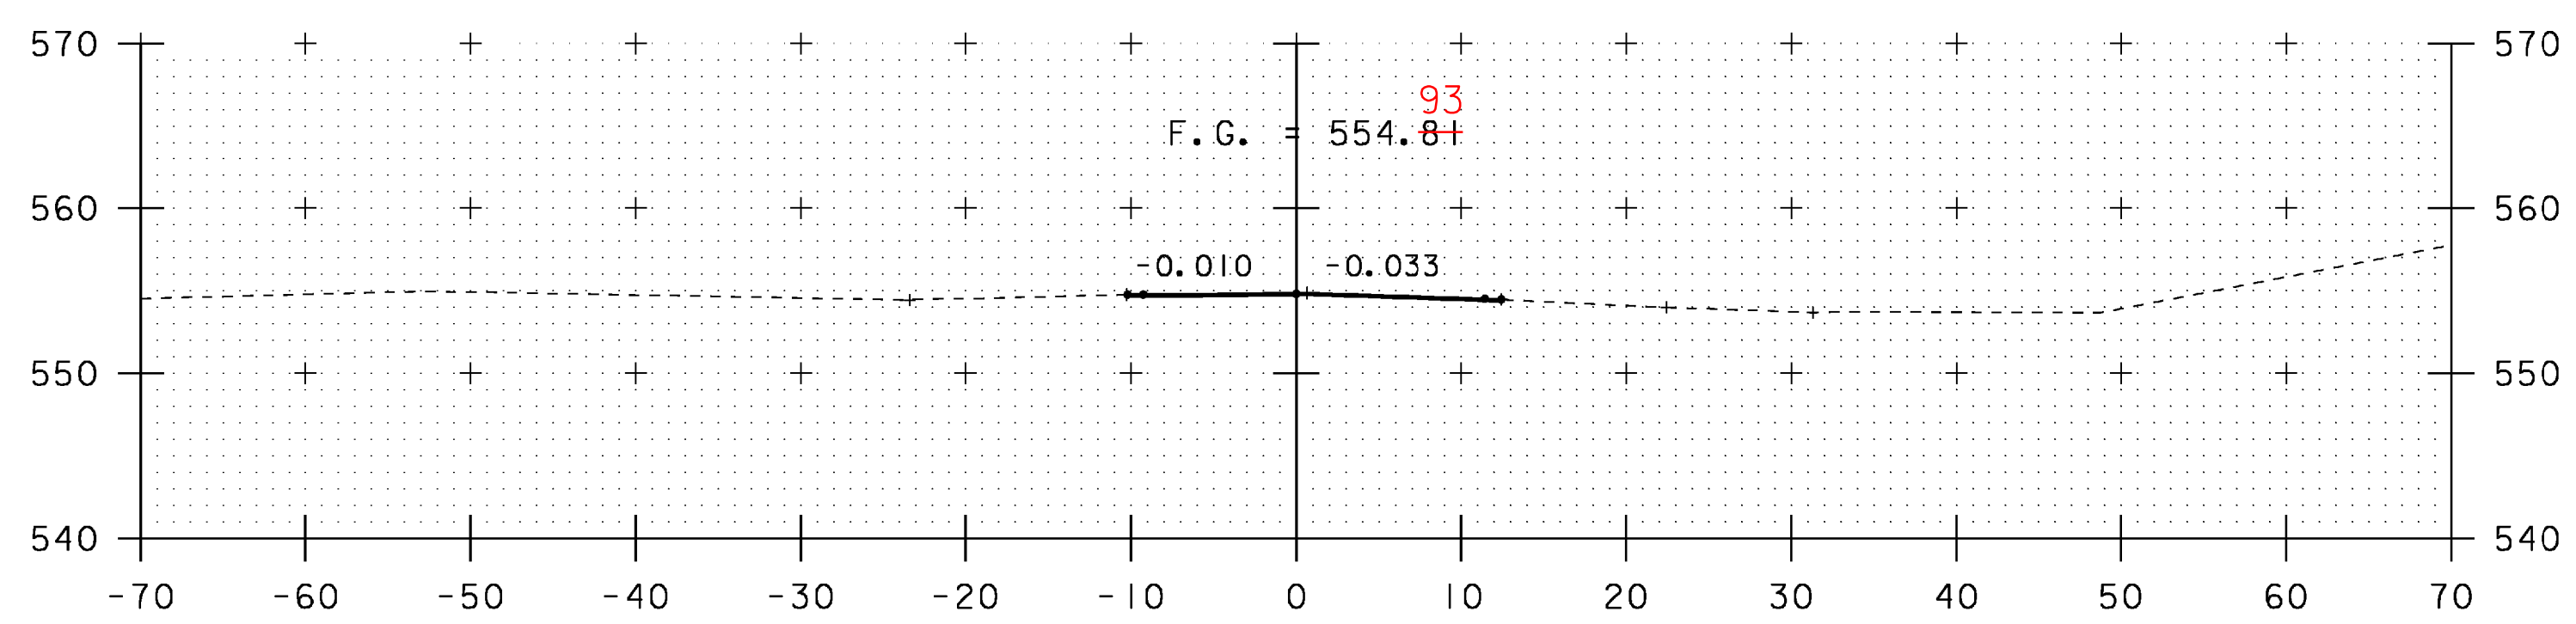


10+50 **SAW CUT PAVEMENT FOR BASE & BINDER**

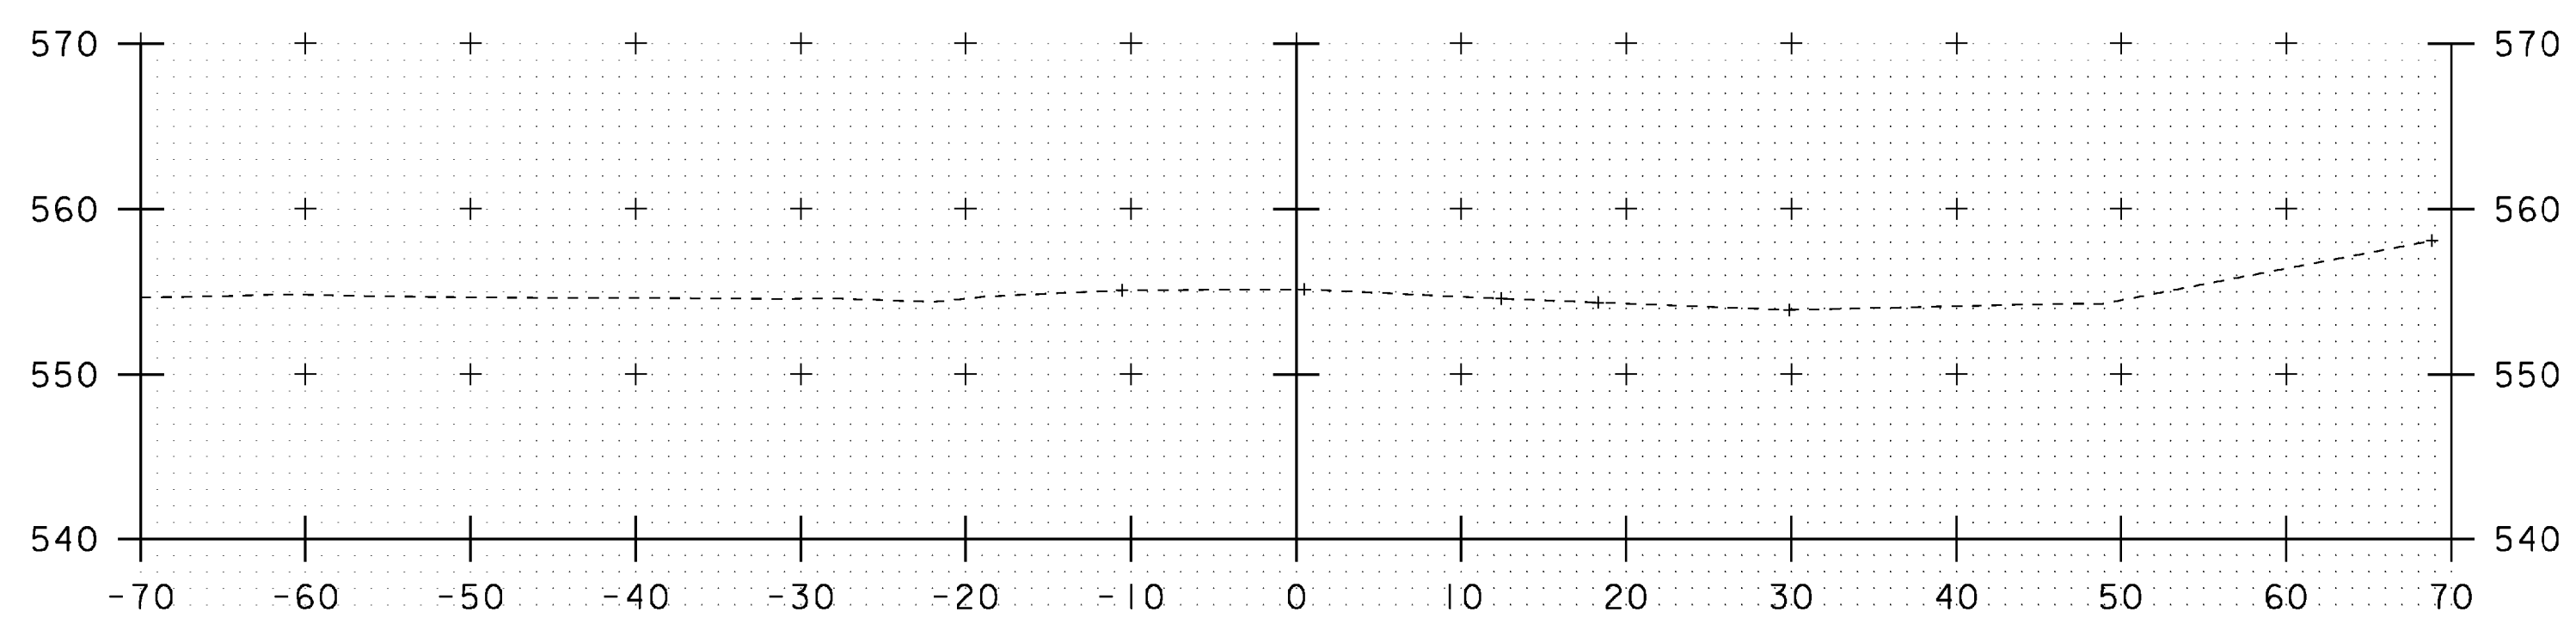


10+25


ML 10+50
BEGIN APPROACH
MATCH EXISTING

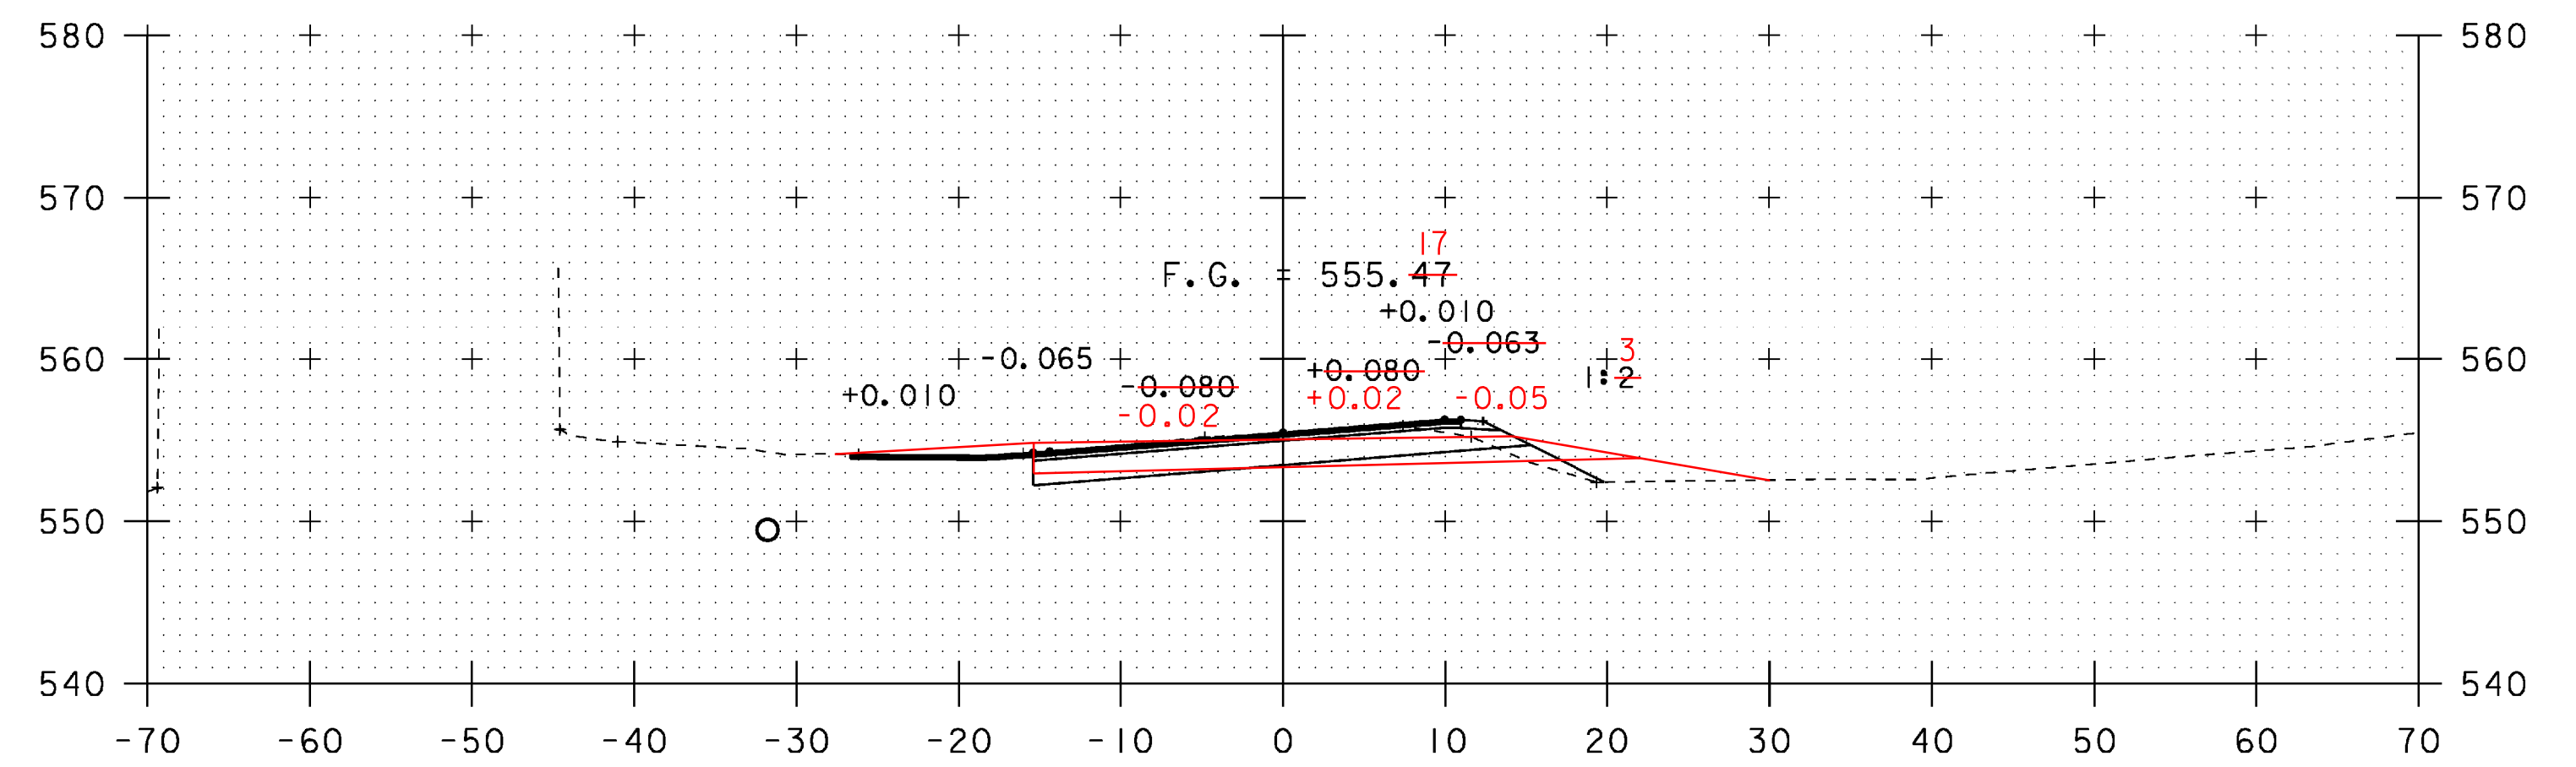


11+50 ML 11+50
BEGIN SAND

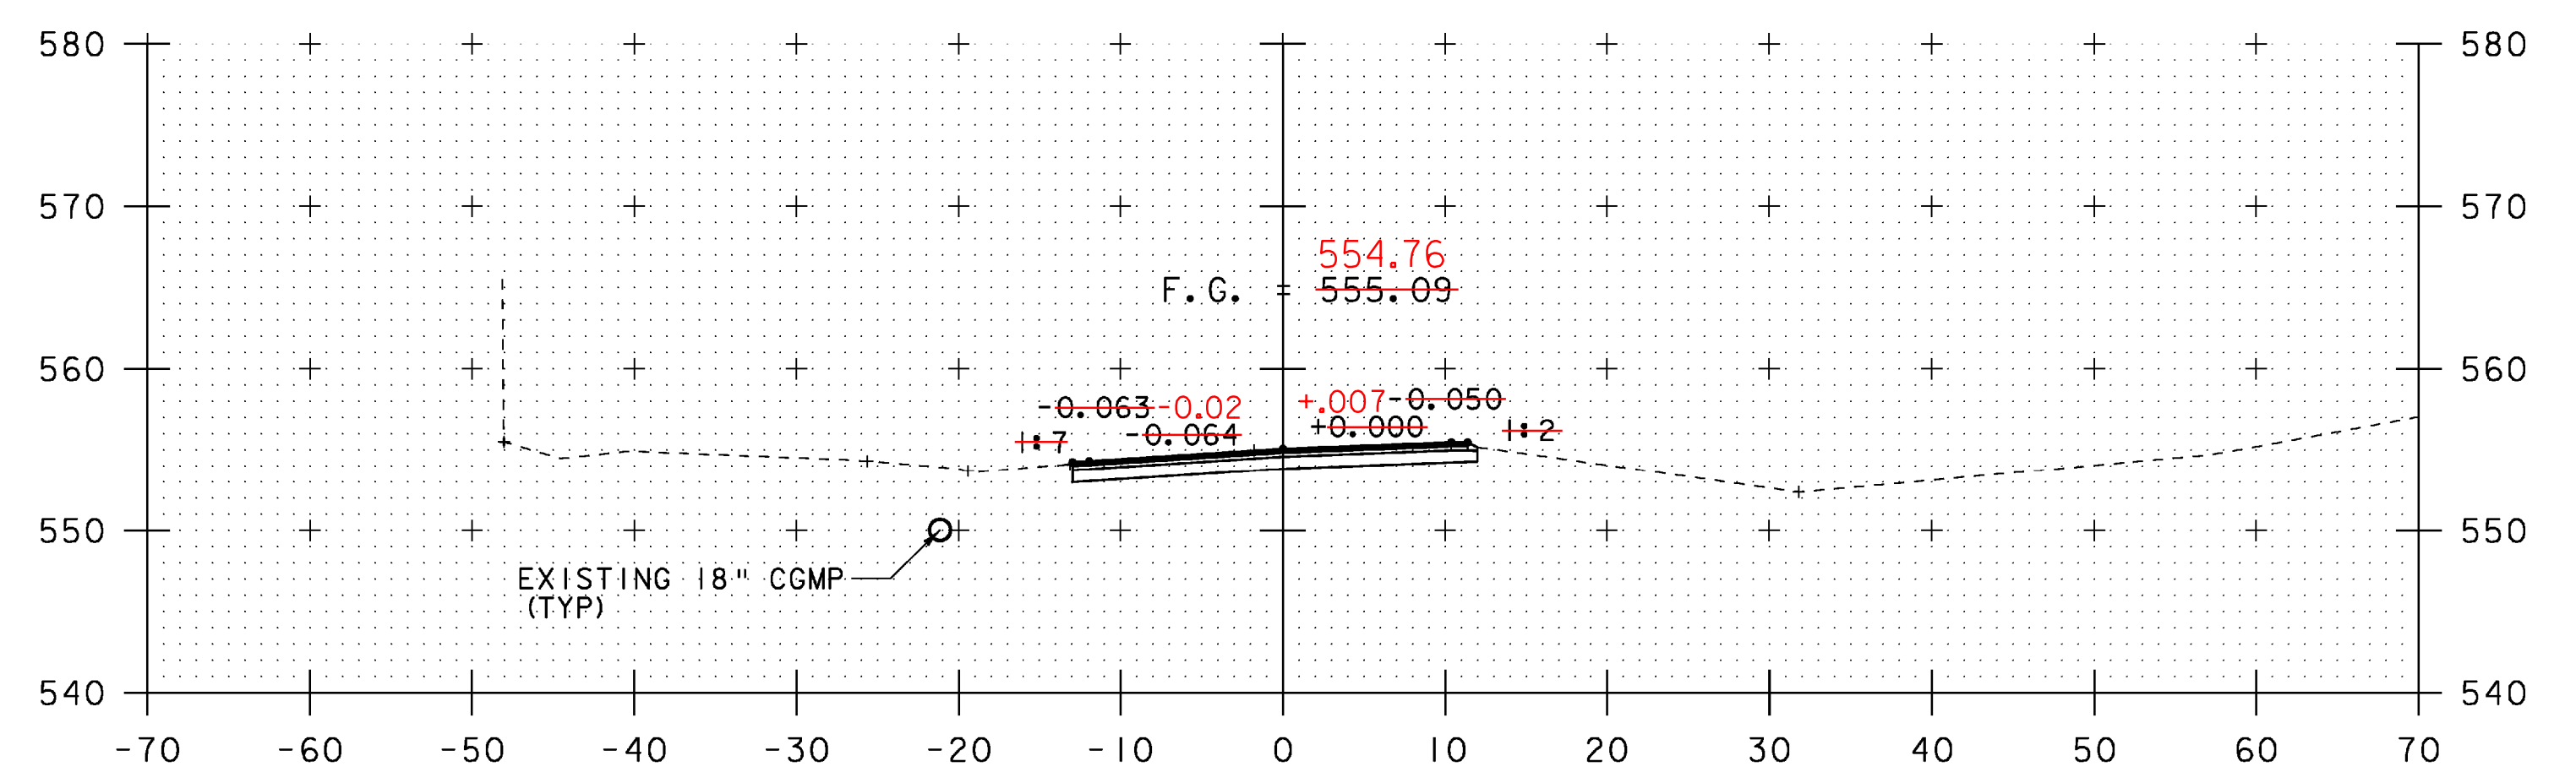

11+25

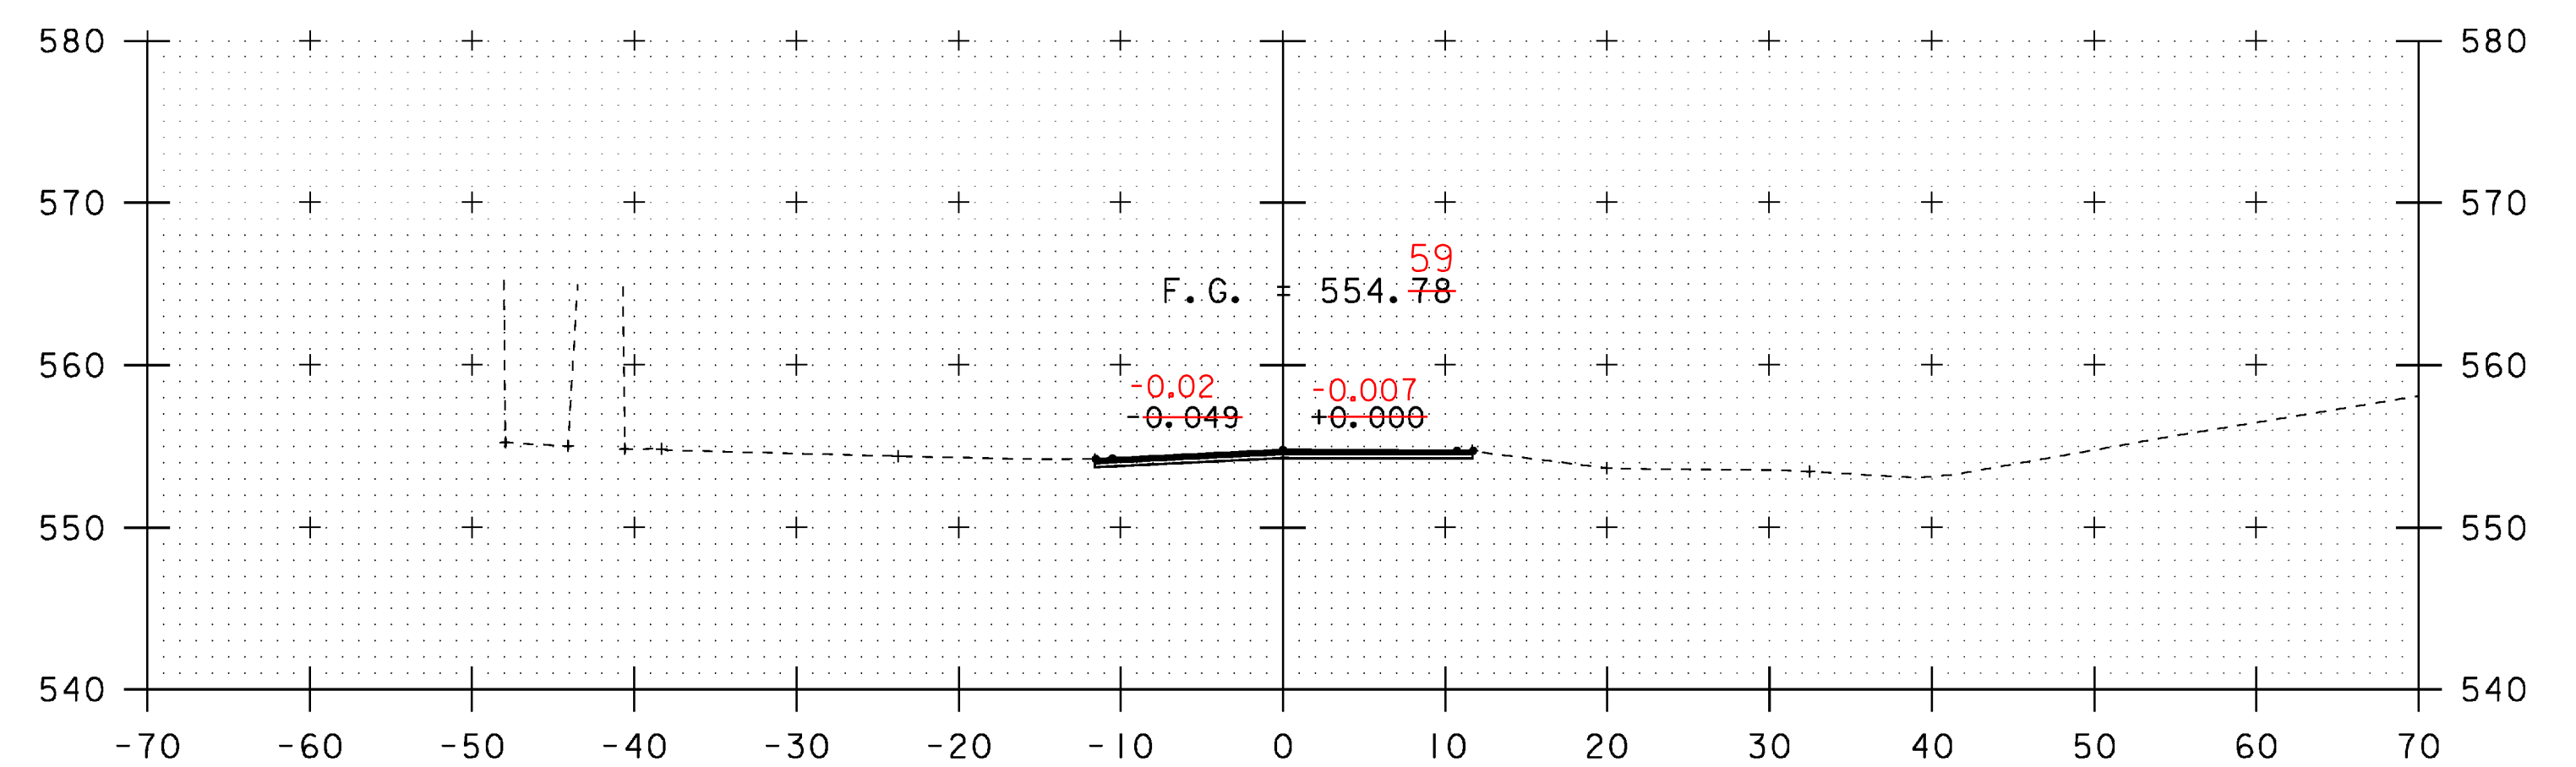

11+00 ML 11+00
BEGIN SUBBASE

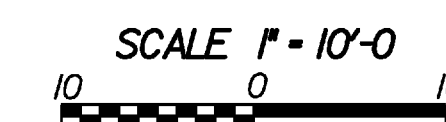

STA. 10+25 TO STA. 11+50

PROJECT NAME: NEWANE
PROJECT NUMBER: BHF 0106 (4)S

FILE NAME: s96j230xs.dgn
PROJECT LEADER: R. WHITCOMB
DESIGNED BY: T. LACKEY
MAINLINE CROSS SECTIONS 1

PLOT DATE: 29-APR-2009
DRAWN BY: T. LACKEY
CHECKED BY: R. WHITCOMB
SHEET 58 OF 67