



12+00

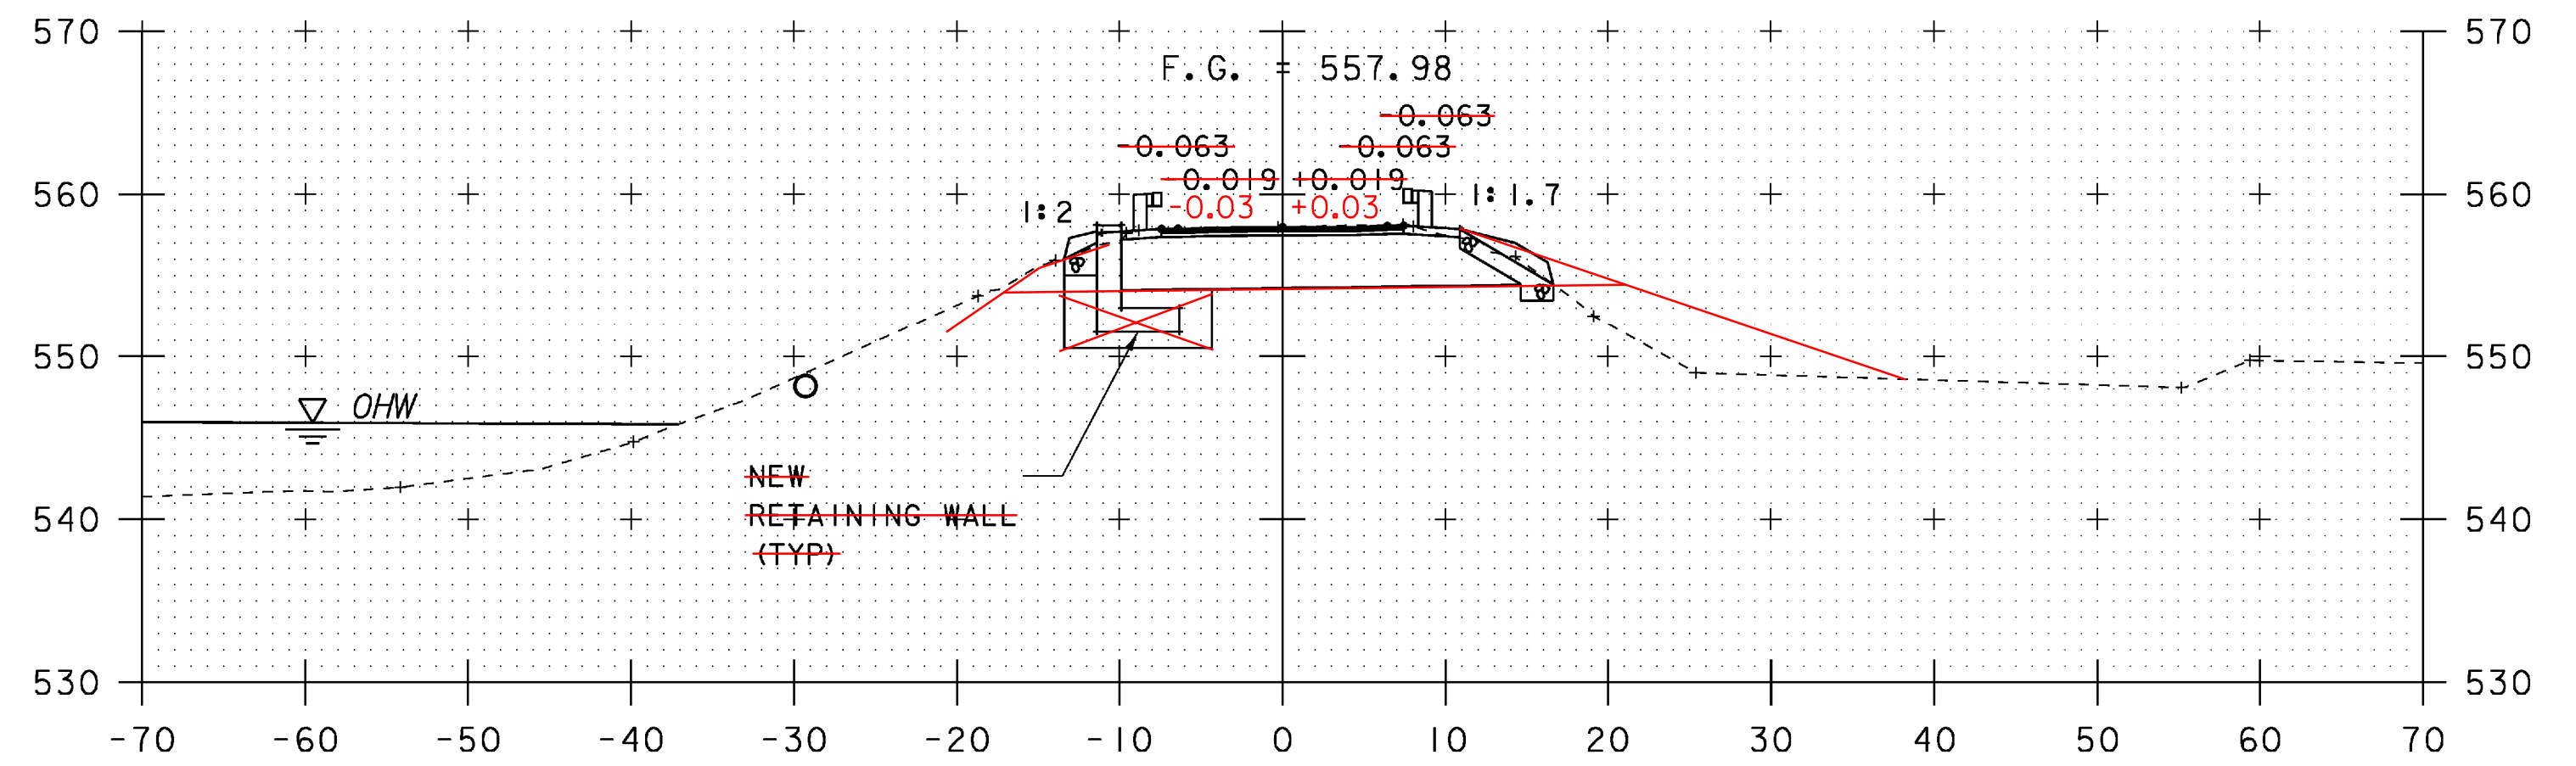


12+35

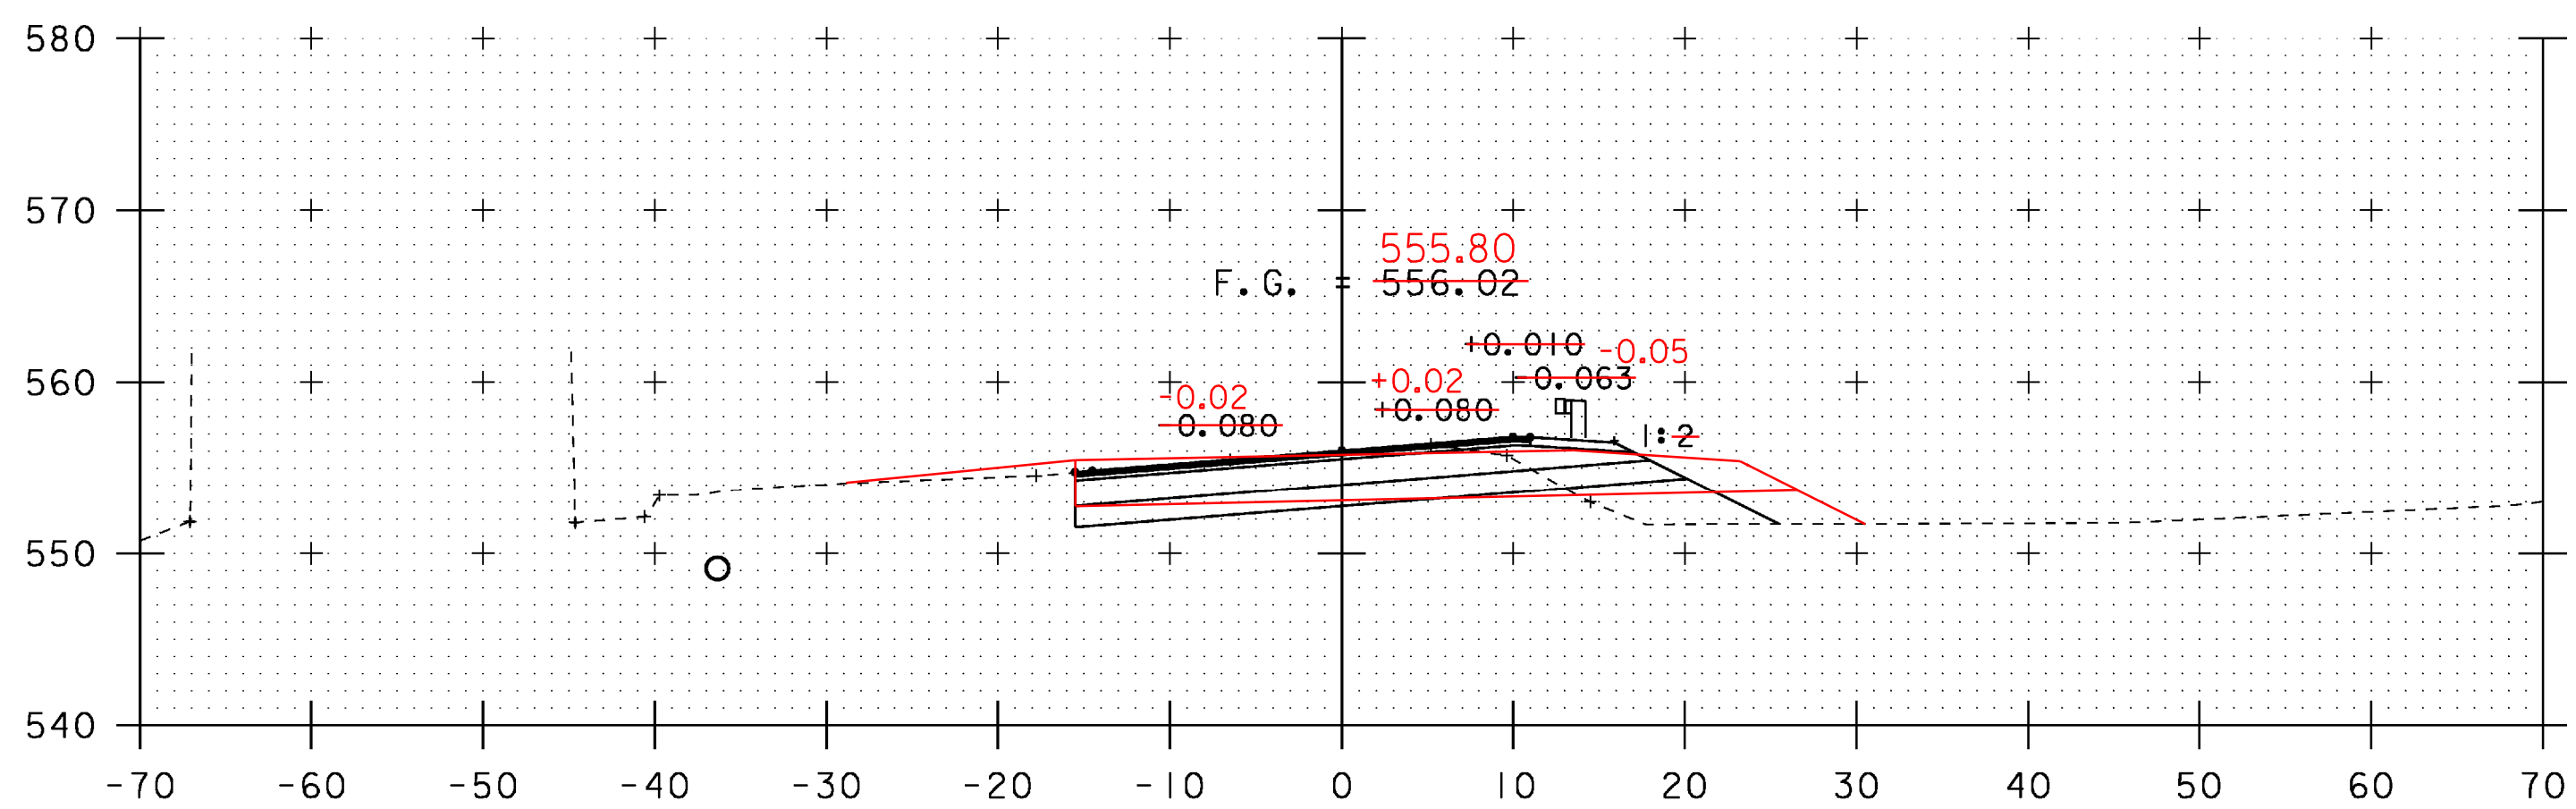


11+75

ML 11+75  
END APPROACH  
BEGIN PROJECT

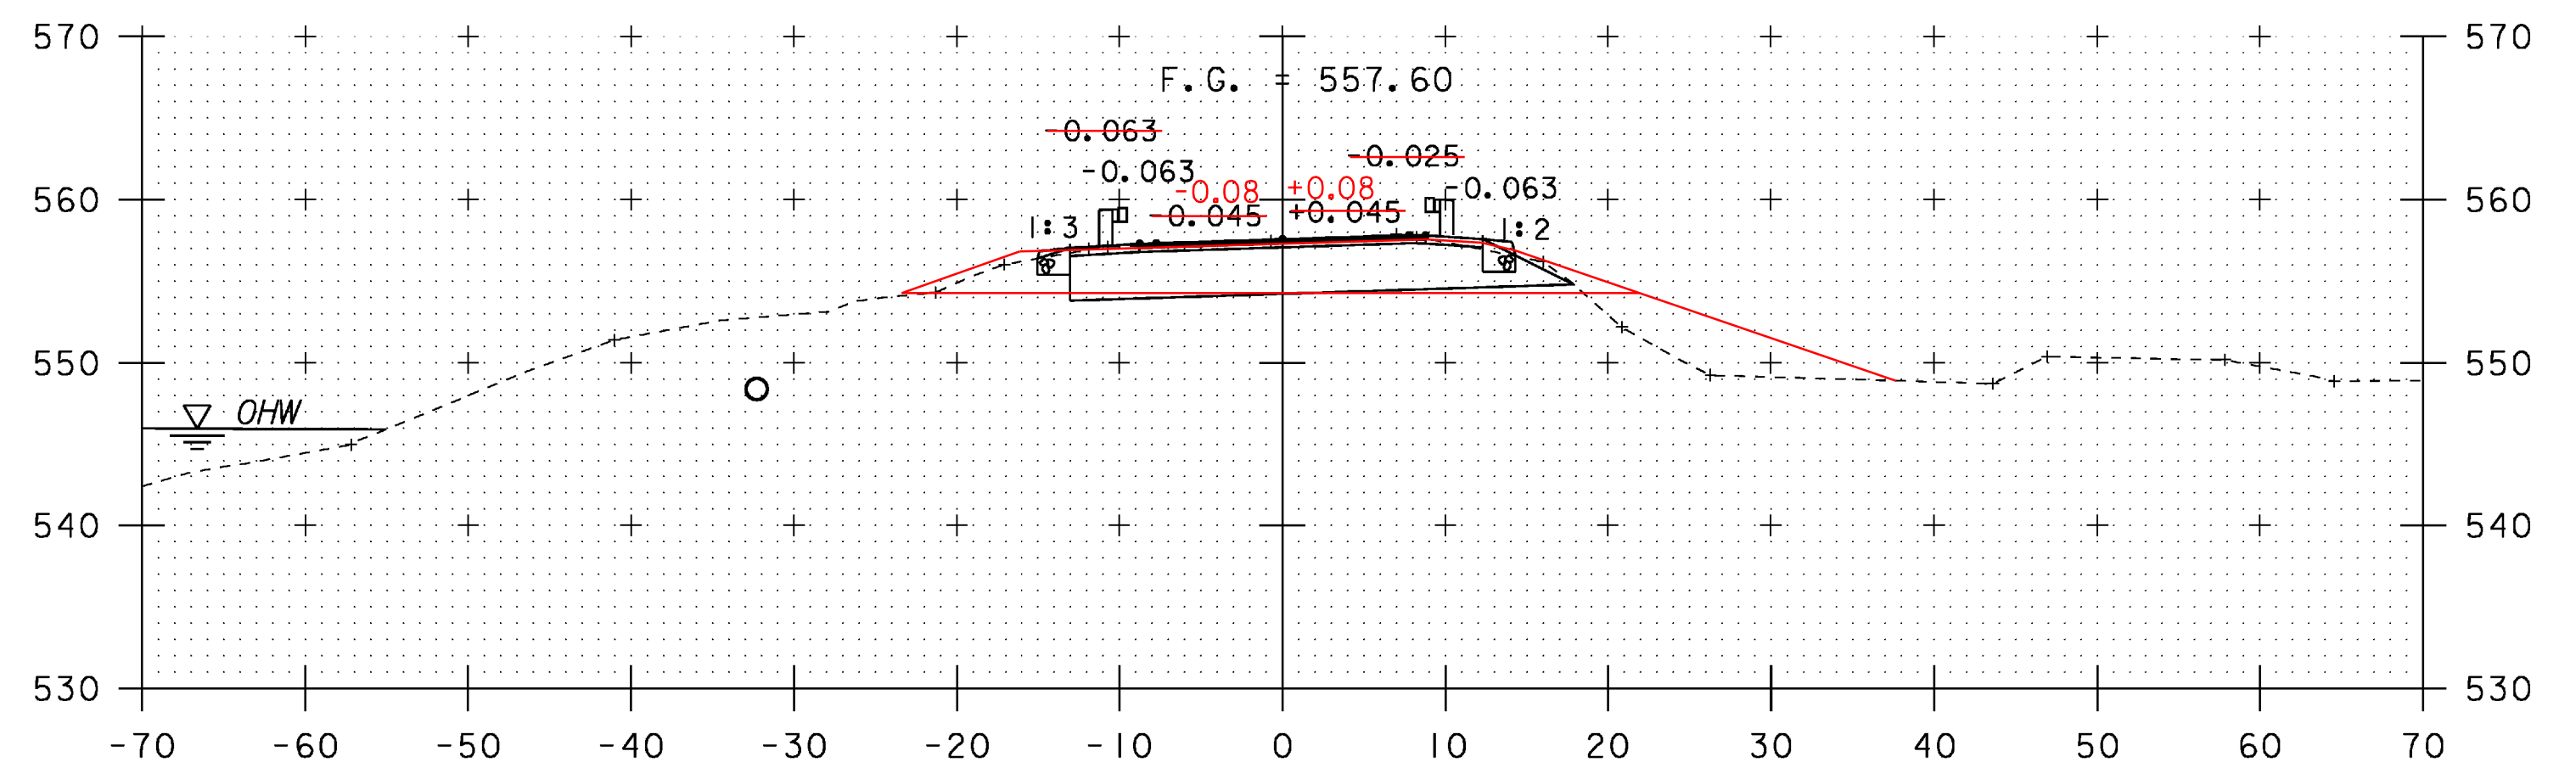


12+25


ML 12+22.5  
END SAND

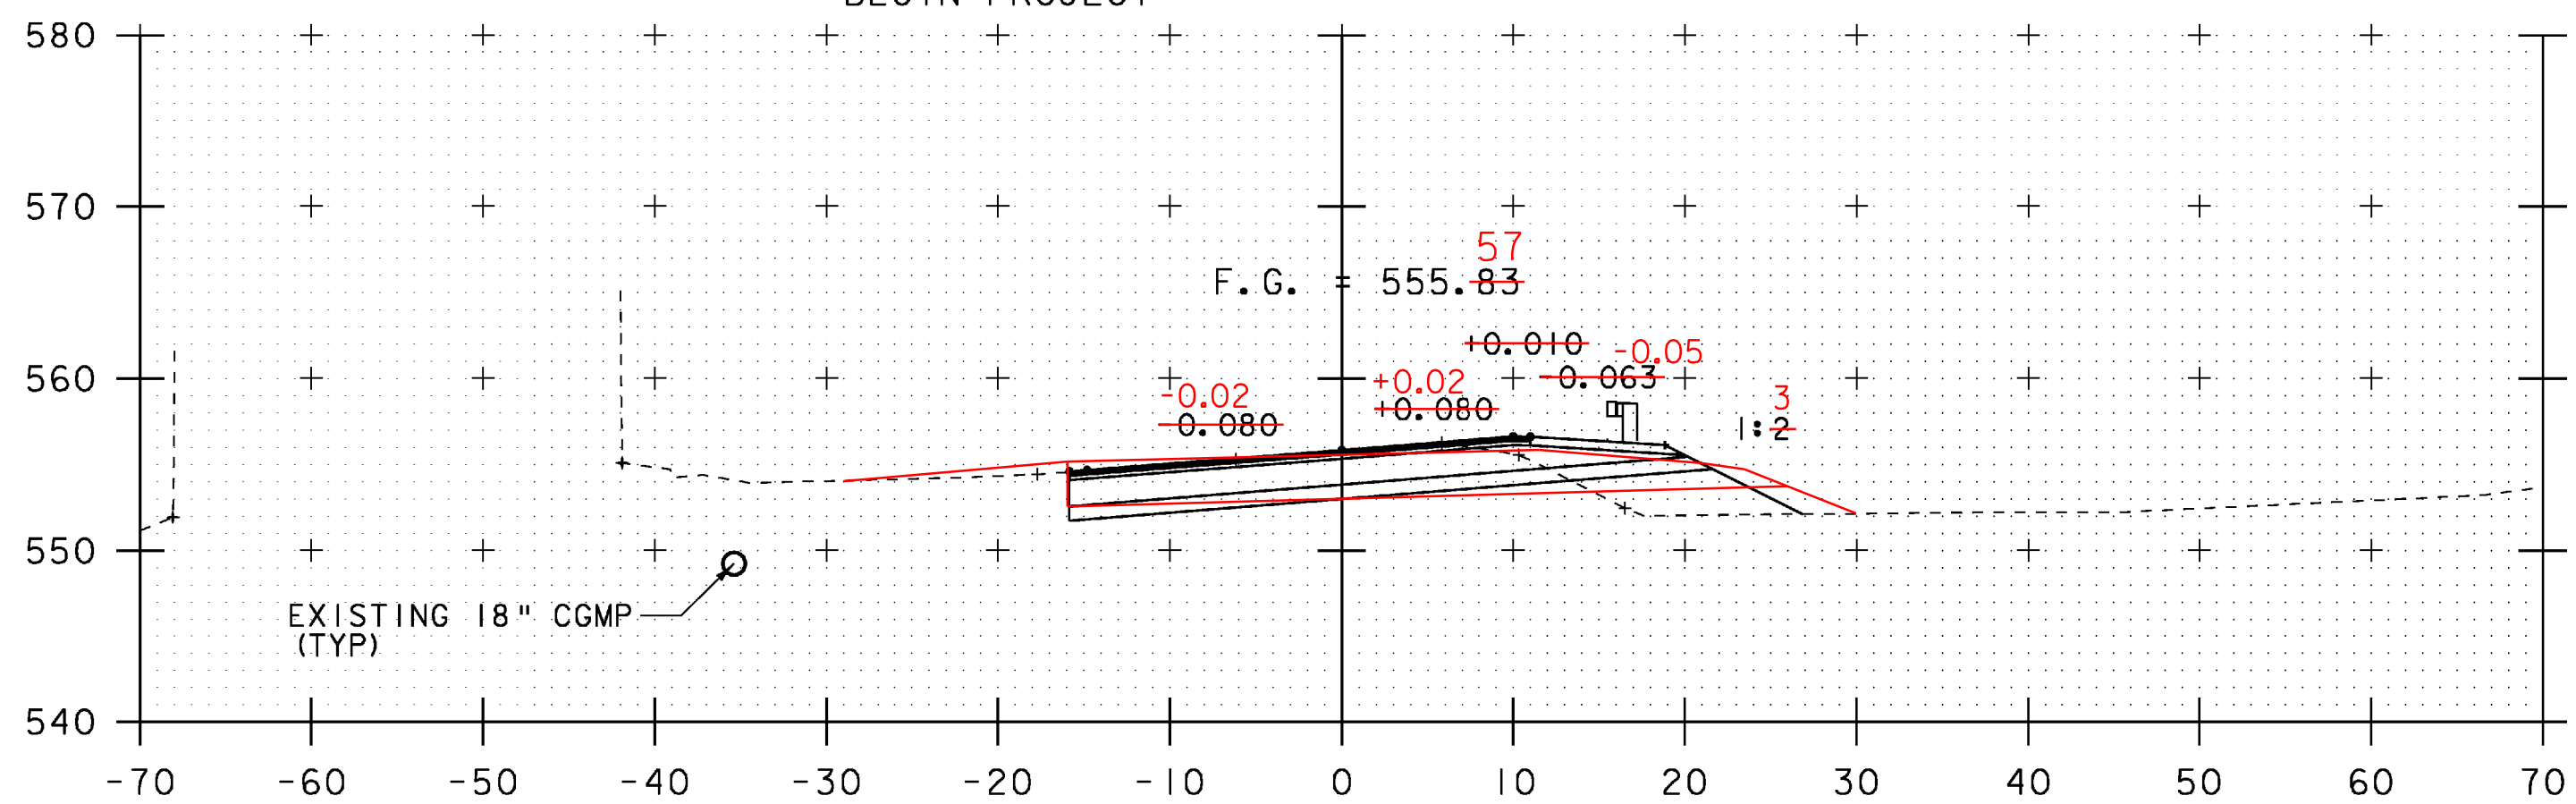

11+67

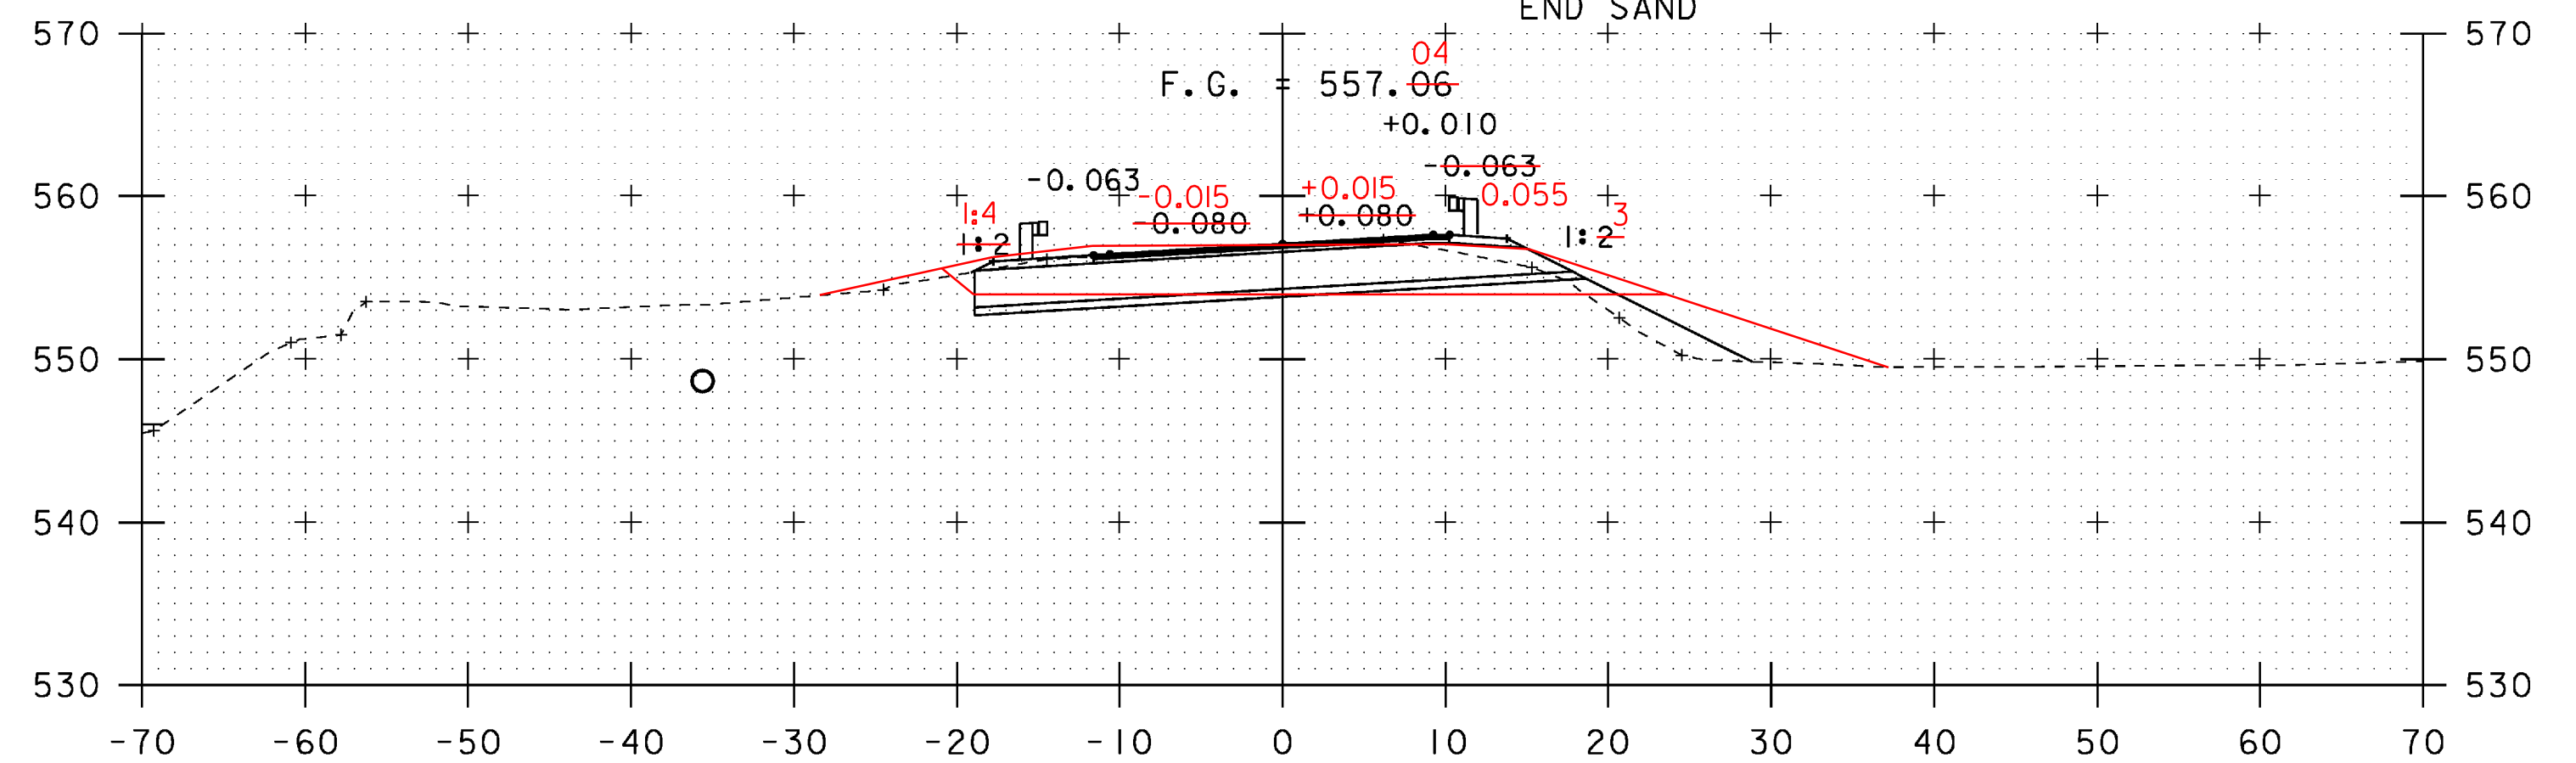

12+10

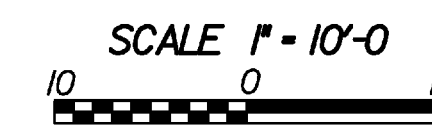

STA. 11+67 TO STA. 12+35

PROJECT NAME:	NEWANE	FILE NAME:	s96j230xs.dgn	PLOT DATE:	29-APR-2009
PROJECT NUMBER:	BHF 0106 (4)S	PROJECT LEADER:	R. WHITCOMB	DRAWN BY:	T. LACKEY
		DESIGNED BY:	T. LACKEY	CHECKED BY:	R. WHITCOMB
		MAINLINE CROSS SECTIONS 2		SHEET 59	OF 67