



ML 12+42.02
BEGIN BRIDGE


12+42

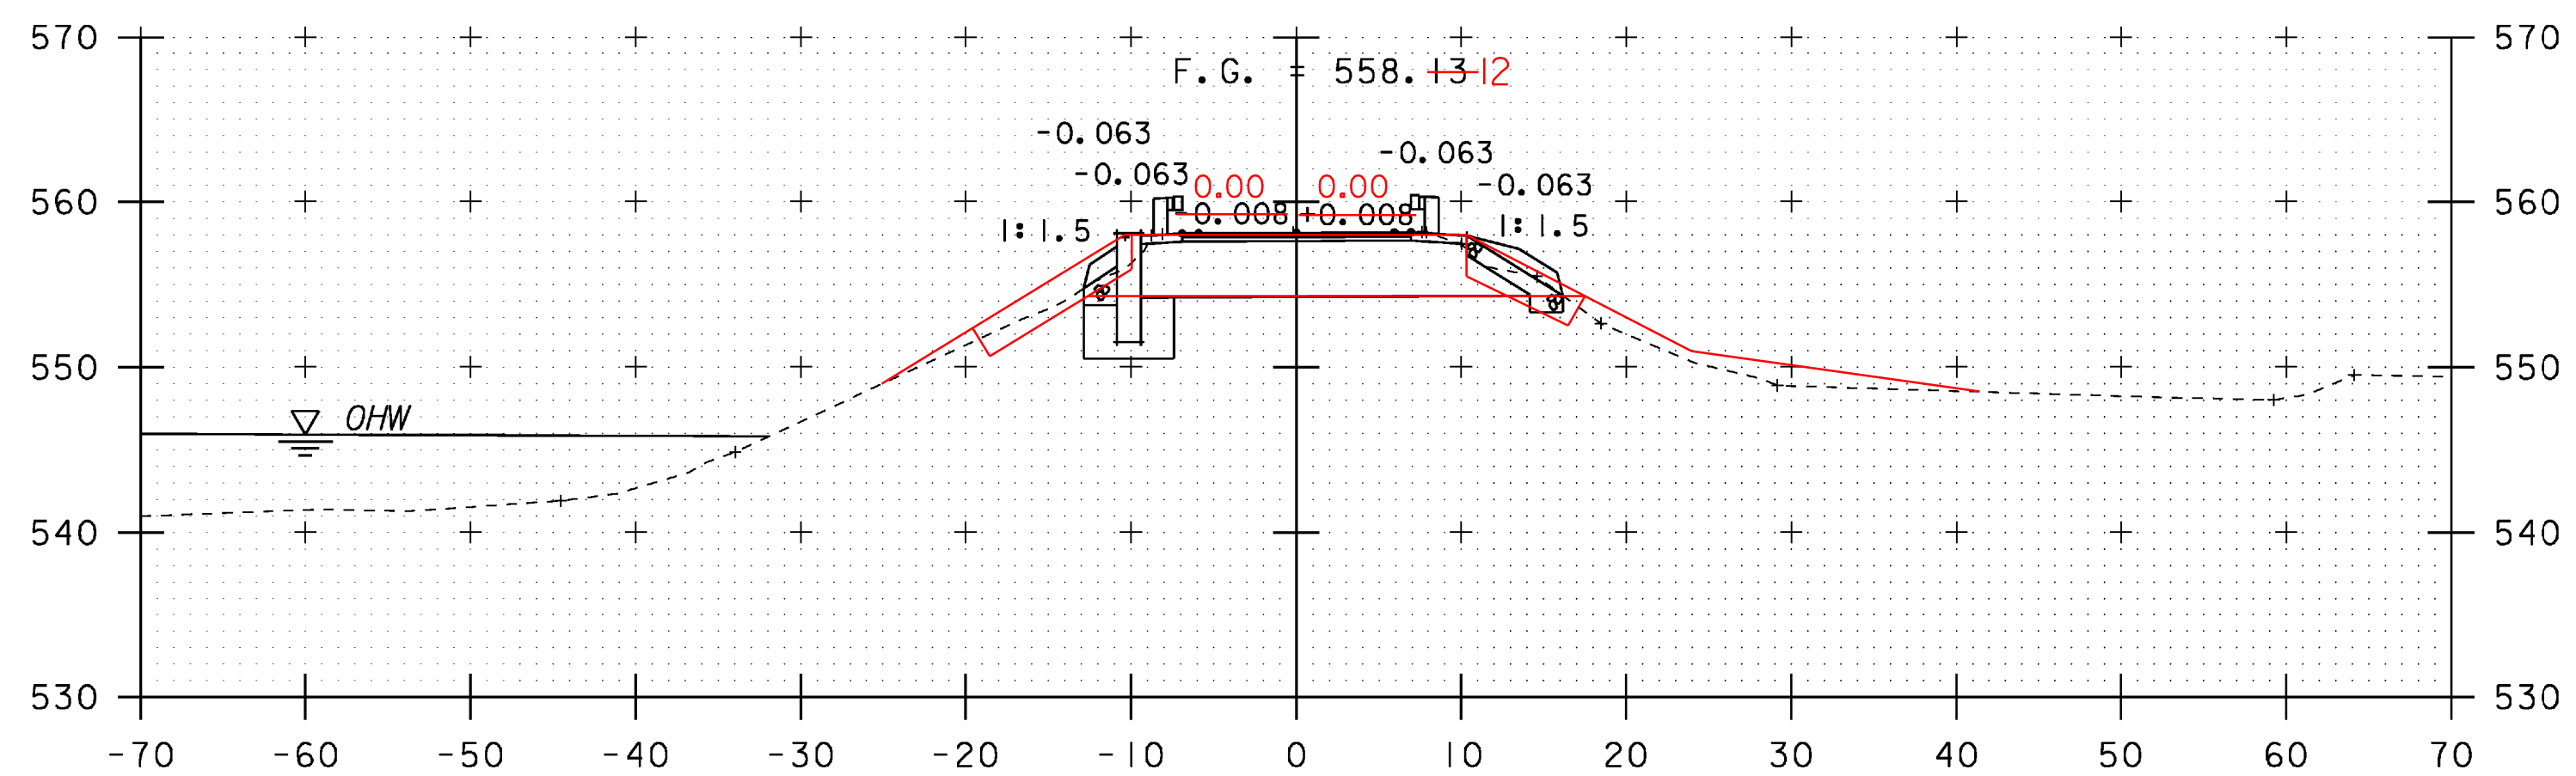


12+39

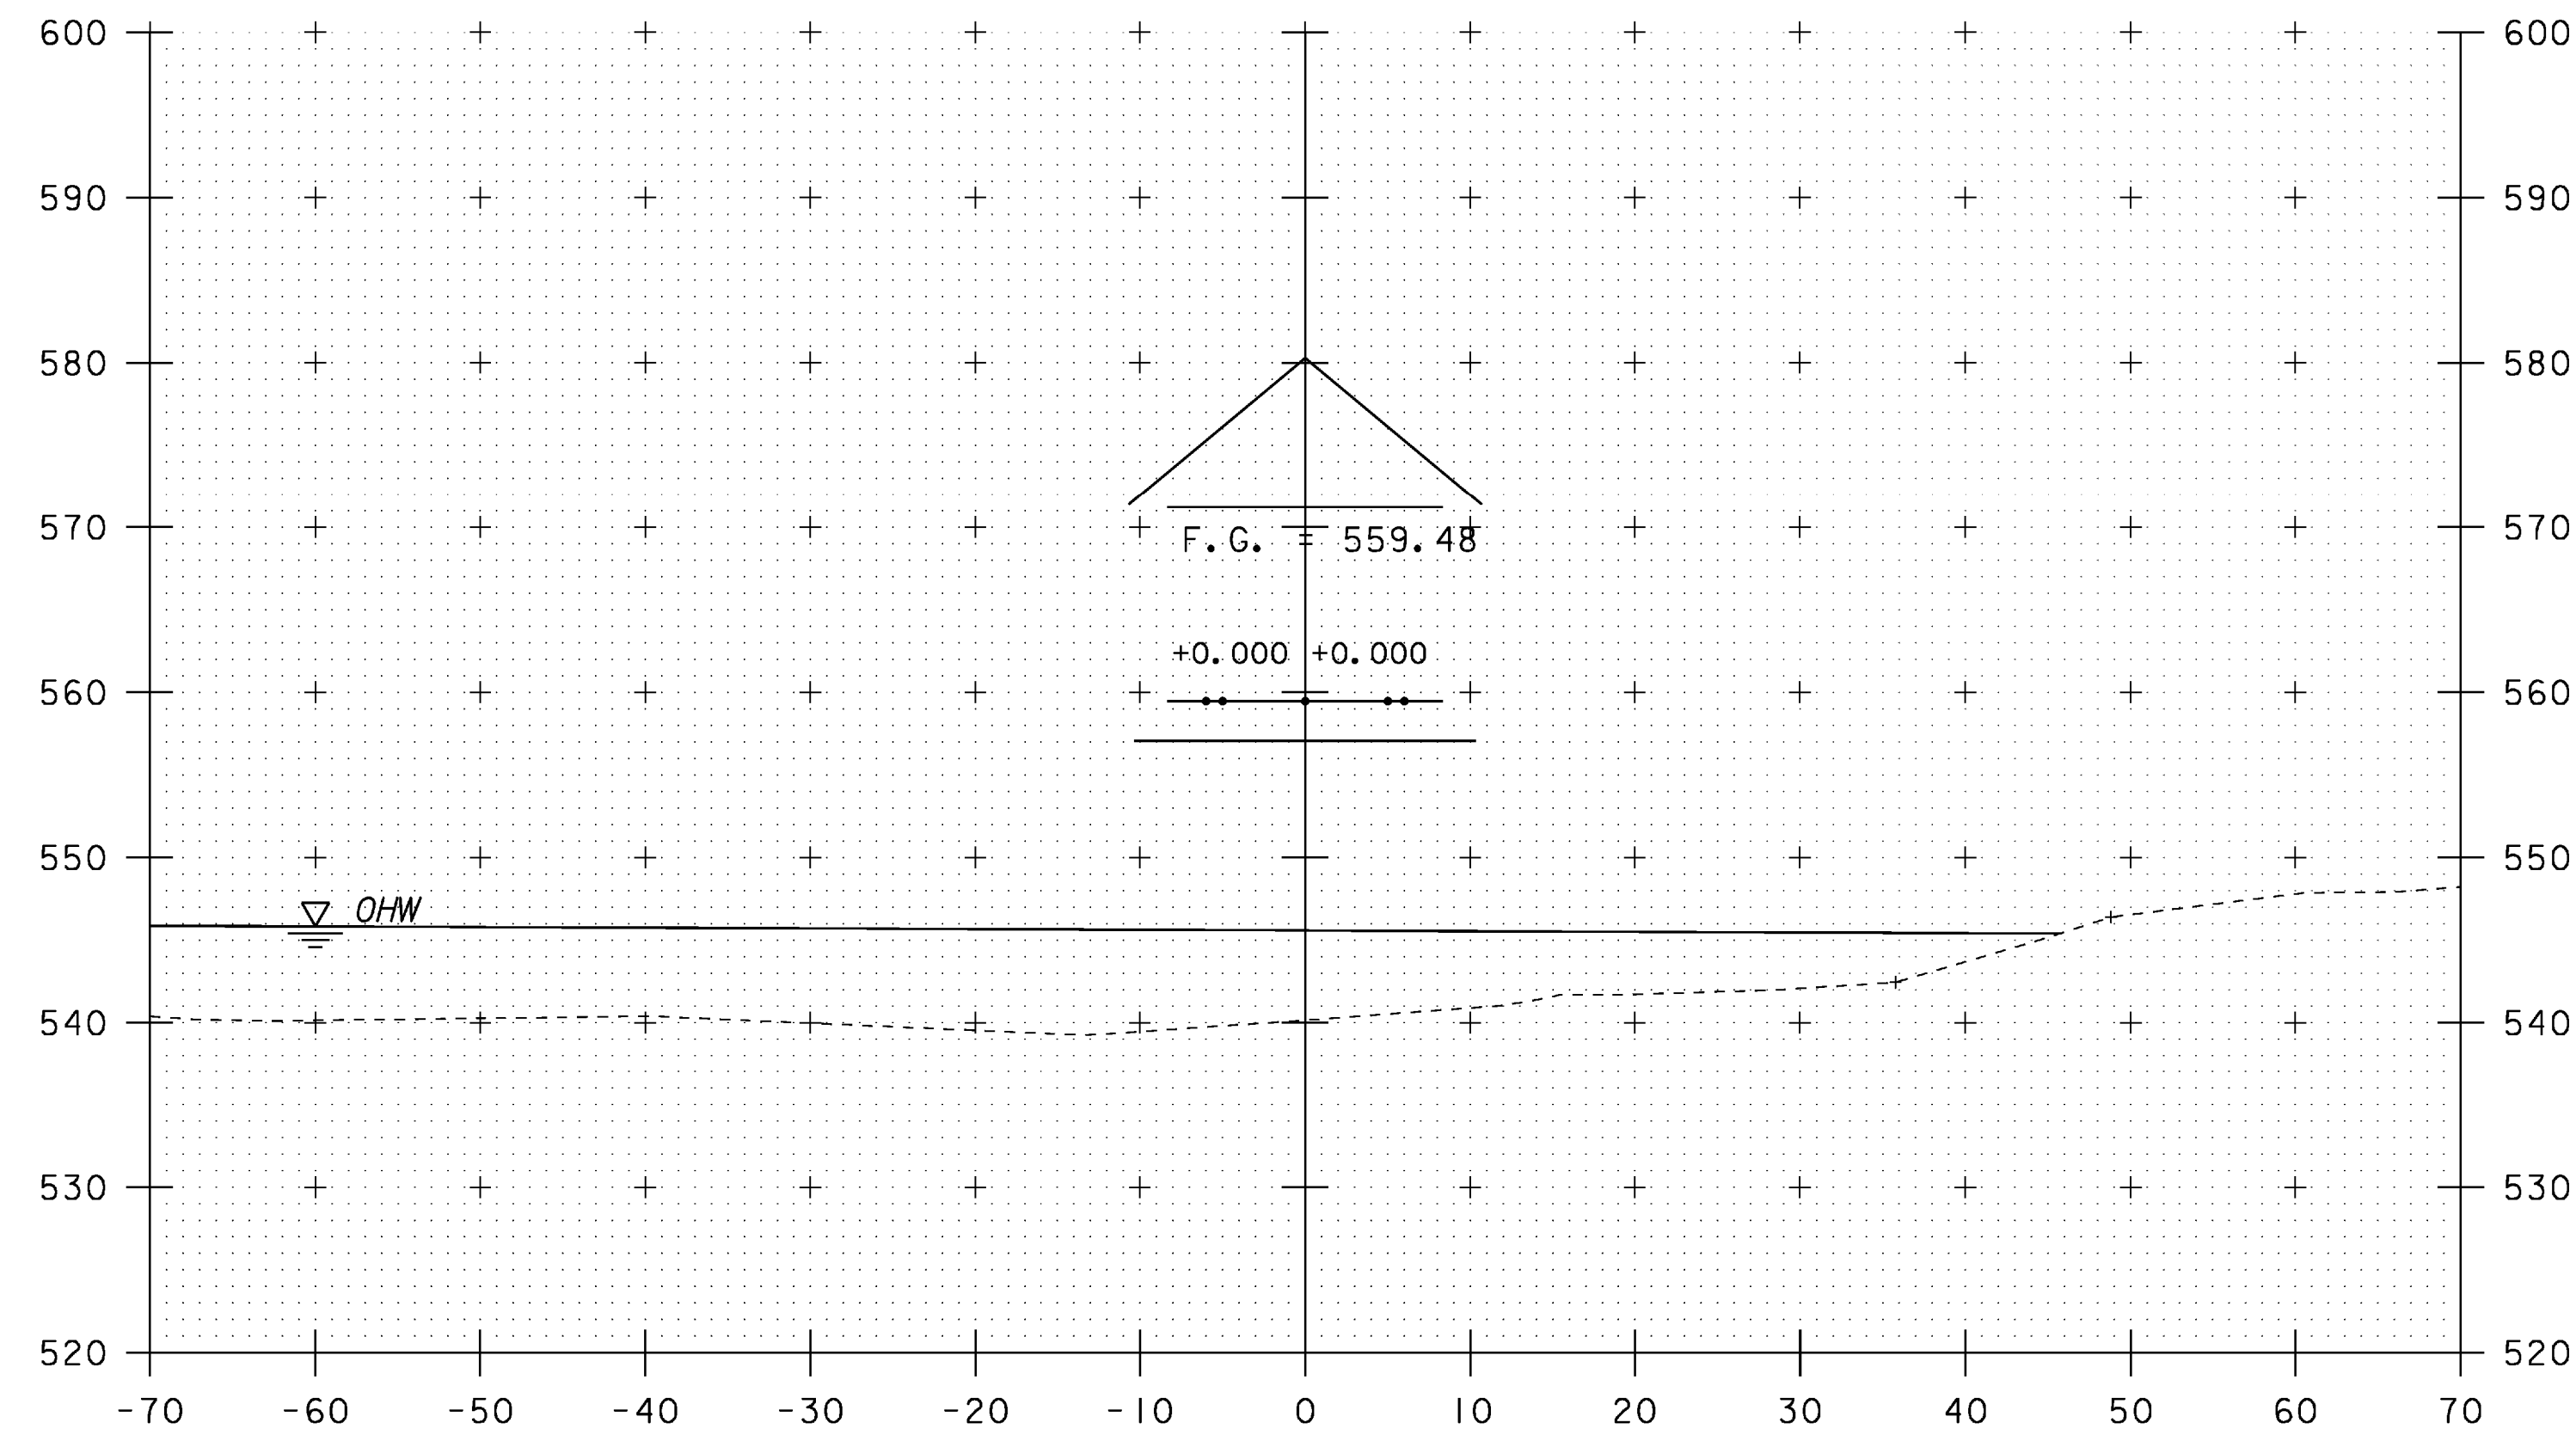

12+75

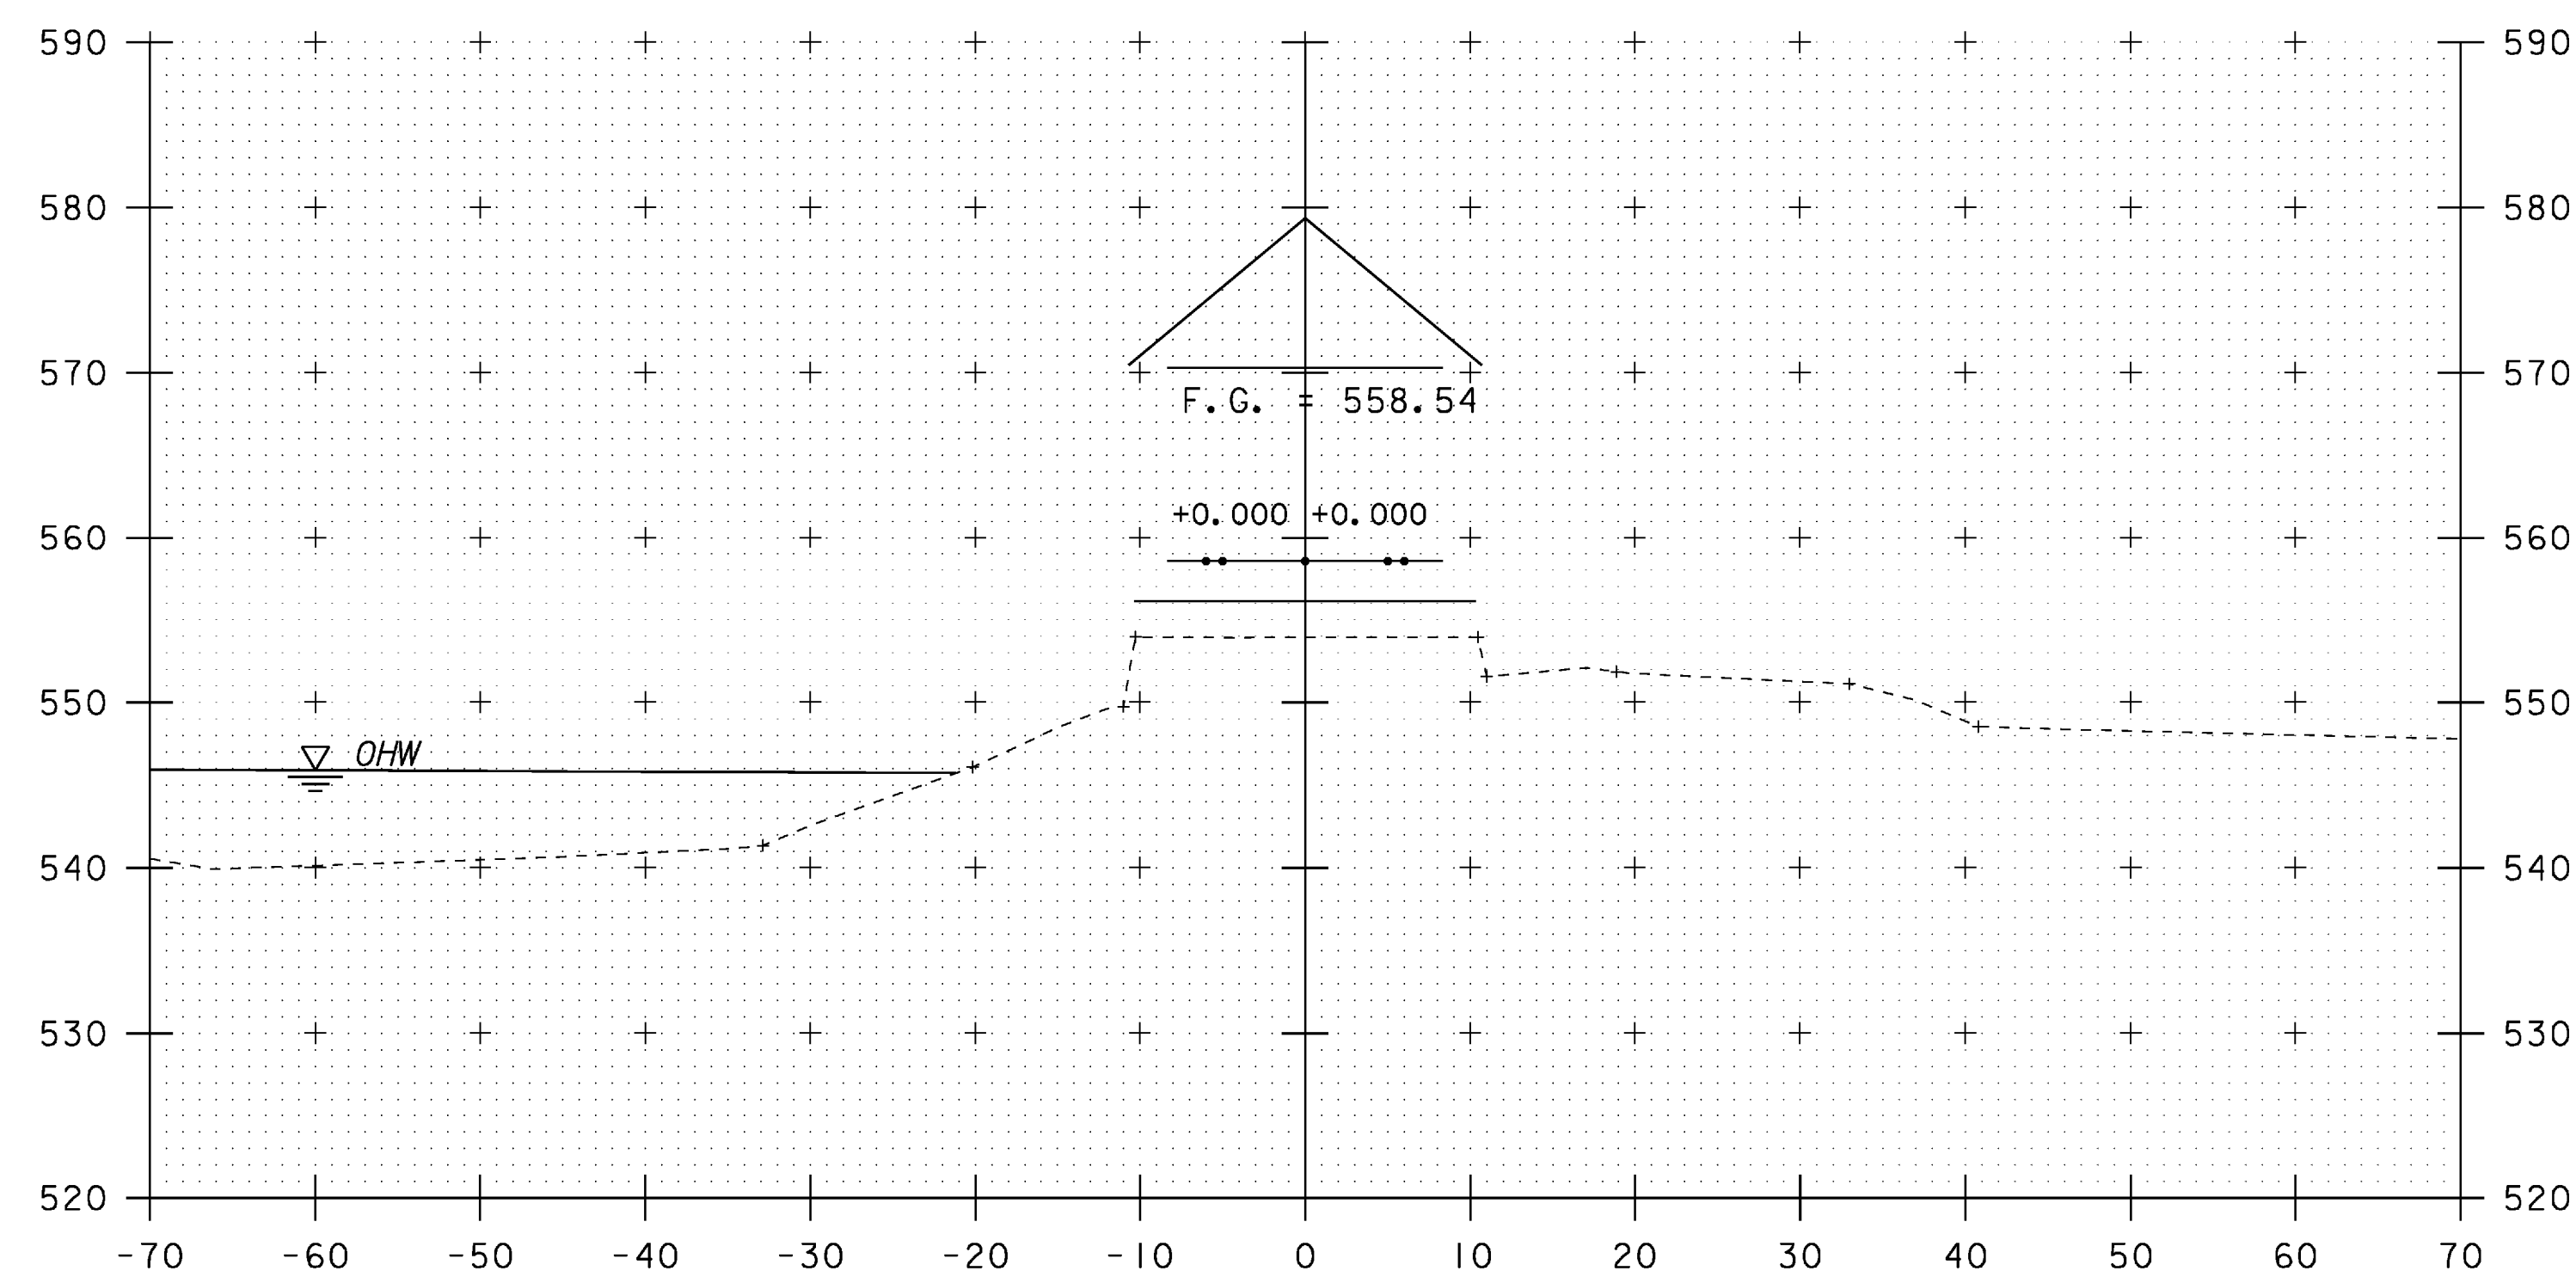

12+50

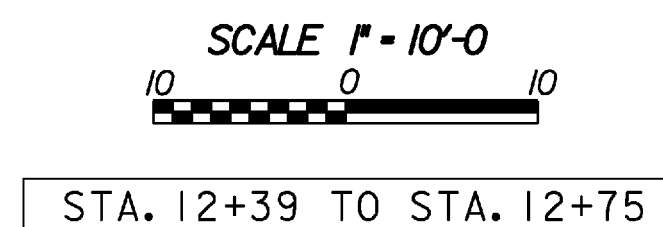

PROJECT NAME:	NEWANE	PLOT DATE:	29-APR-2009
PROJECT NUMBER:	BHF 0106 (4)S	DRAWN BY:	T. LACKEY
FILE NAME:	s96j230xs.dgn	CHECKED BY:	R. WHITCOMB
PROJECT LEADER:	R. WHITCOMB	SHEET	60 OF 67
DESIGNED BY:	T. LACKEY	MAINLINE CROSS SECTIONS 3	