



ML 13+62.18
 END BRIDGE
 END PROJECT
 BEGIN APPROACH


13+62

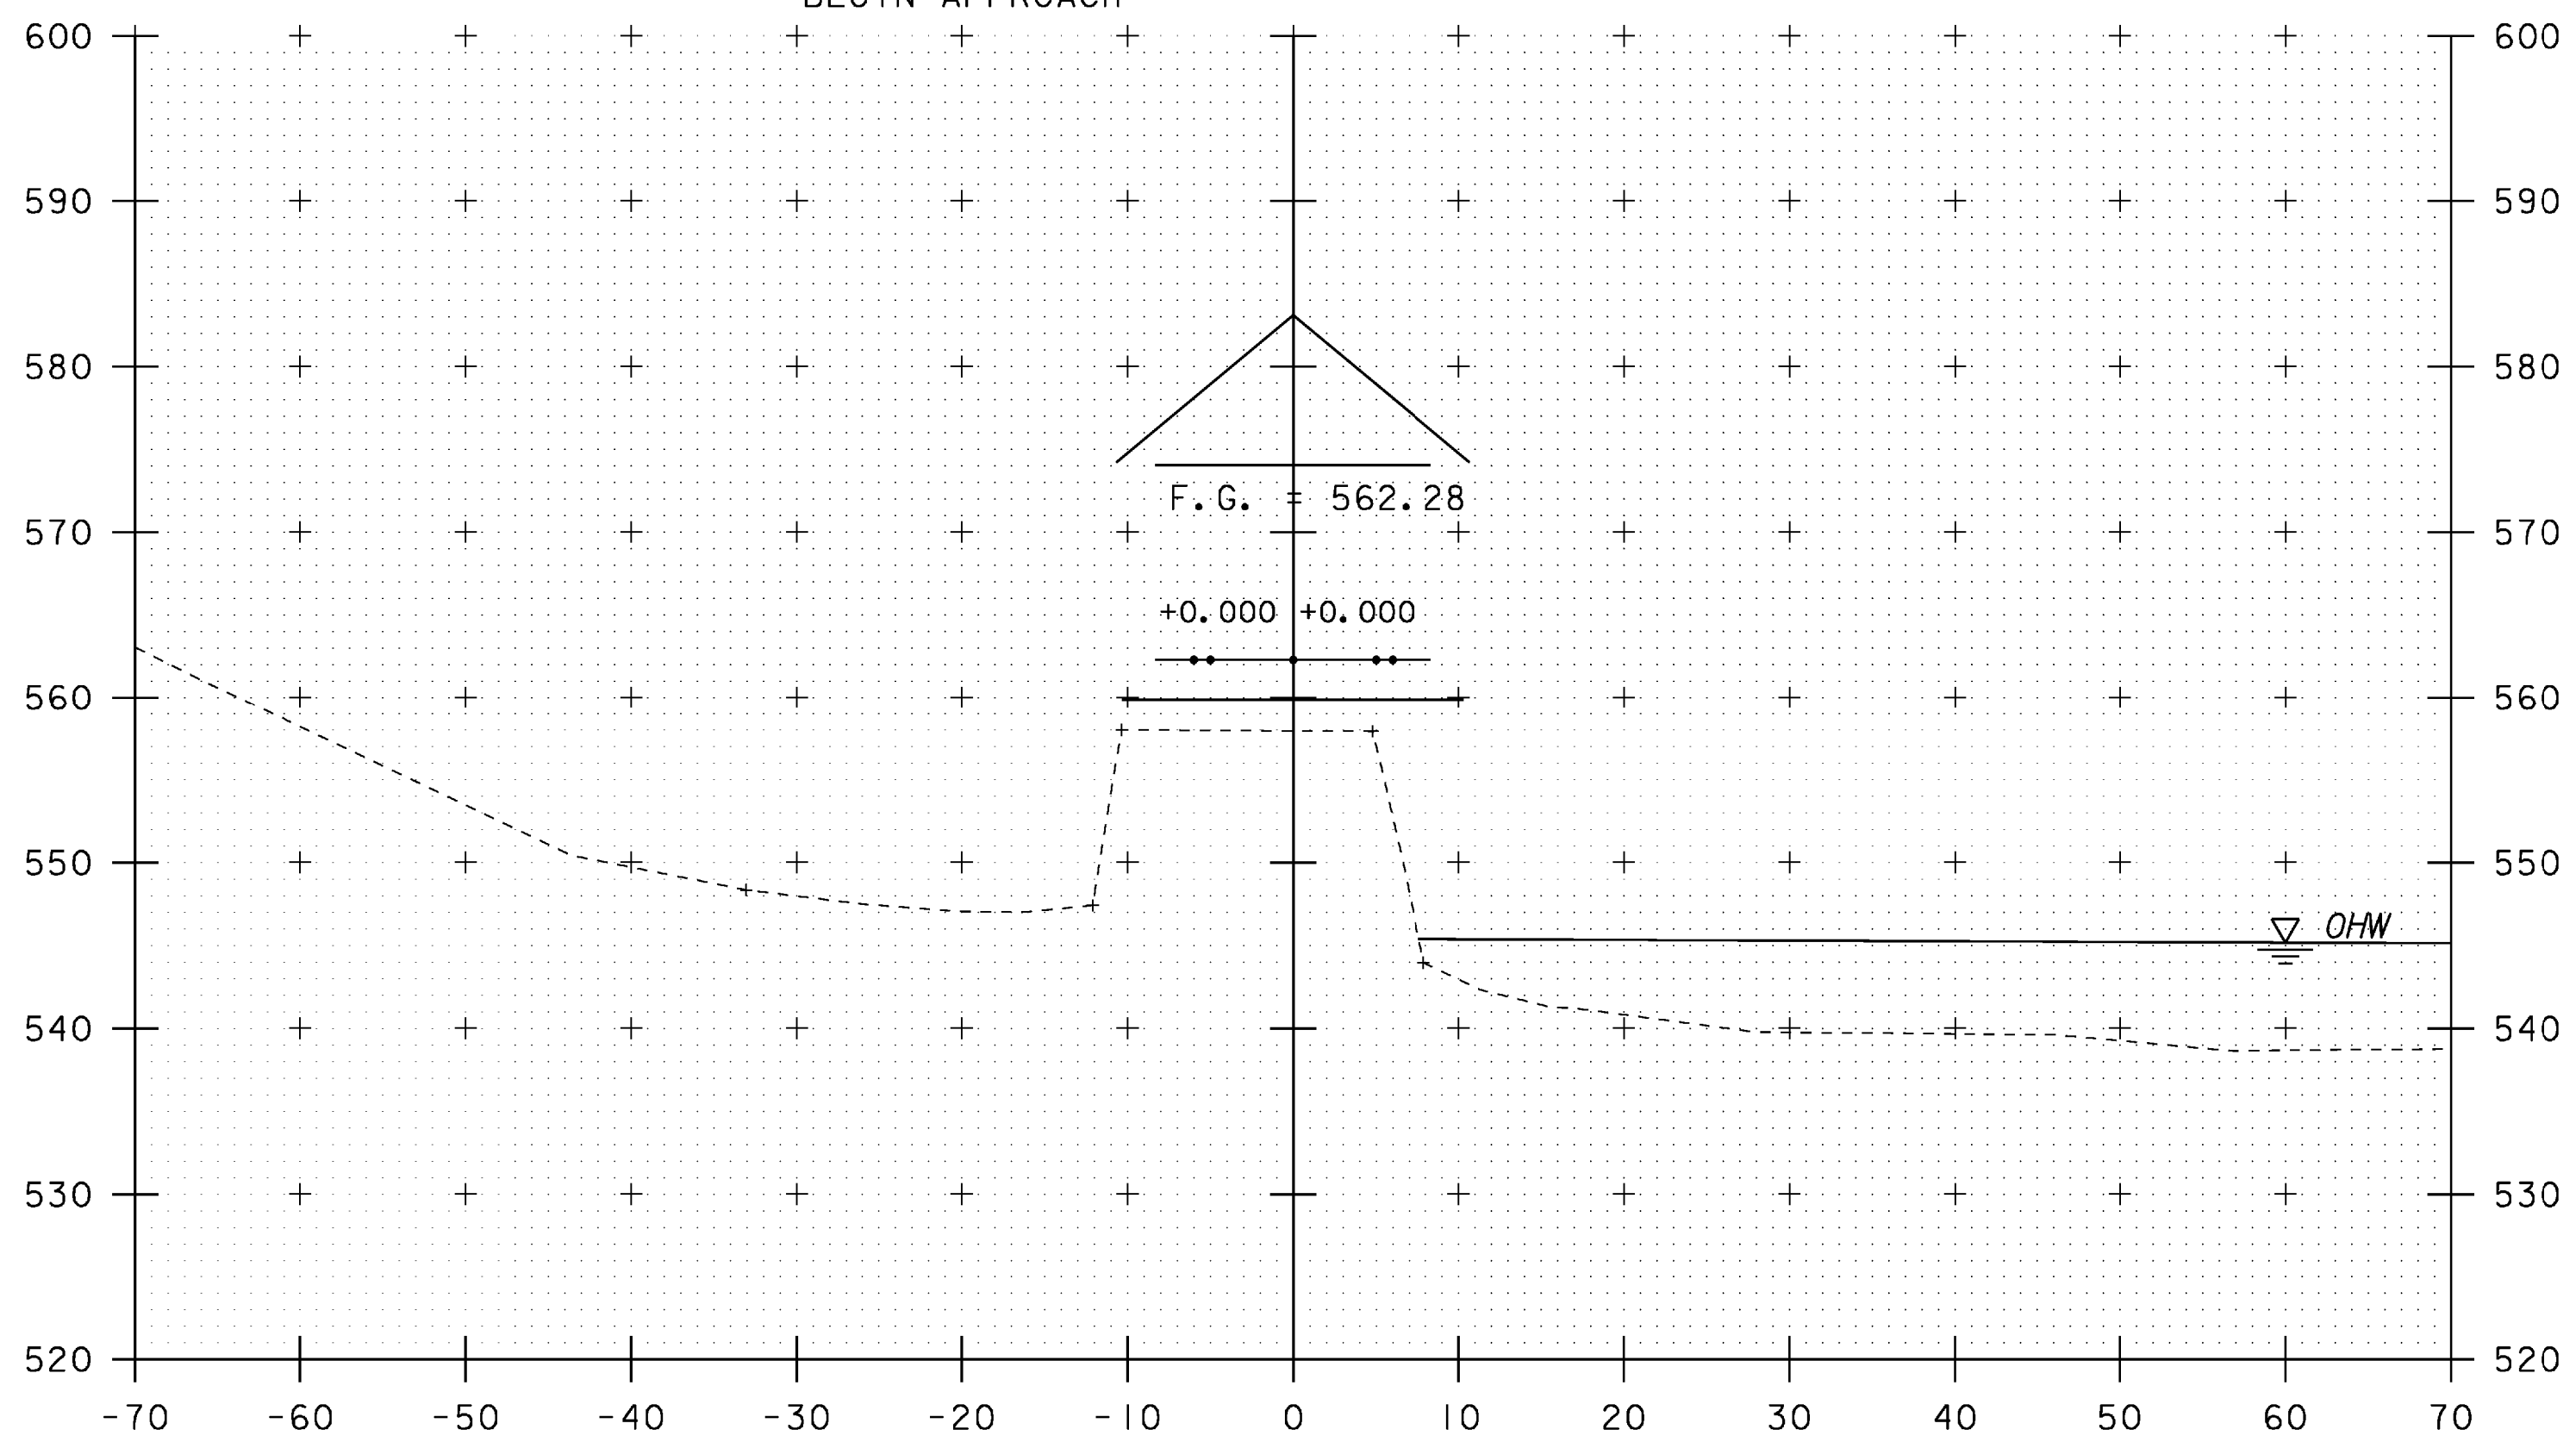


13+50

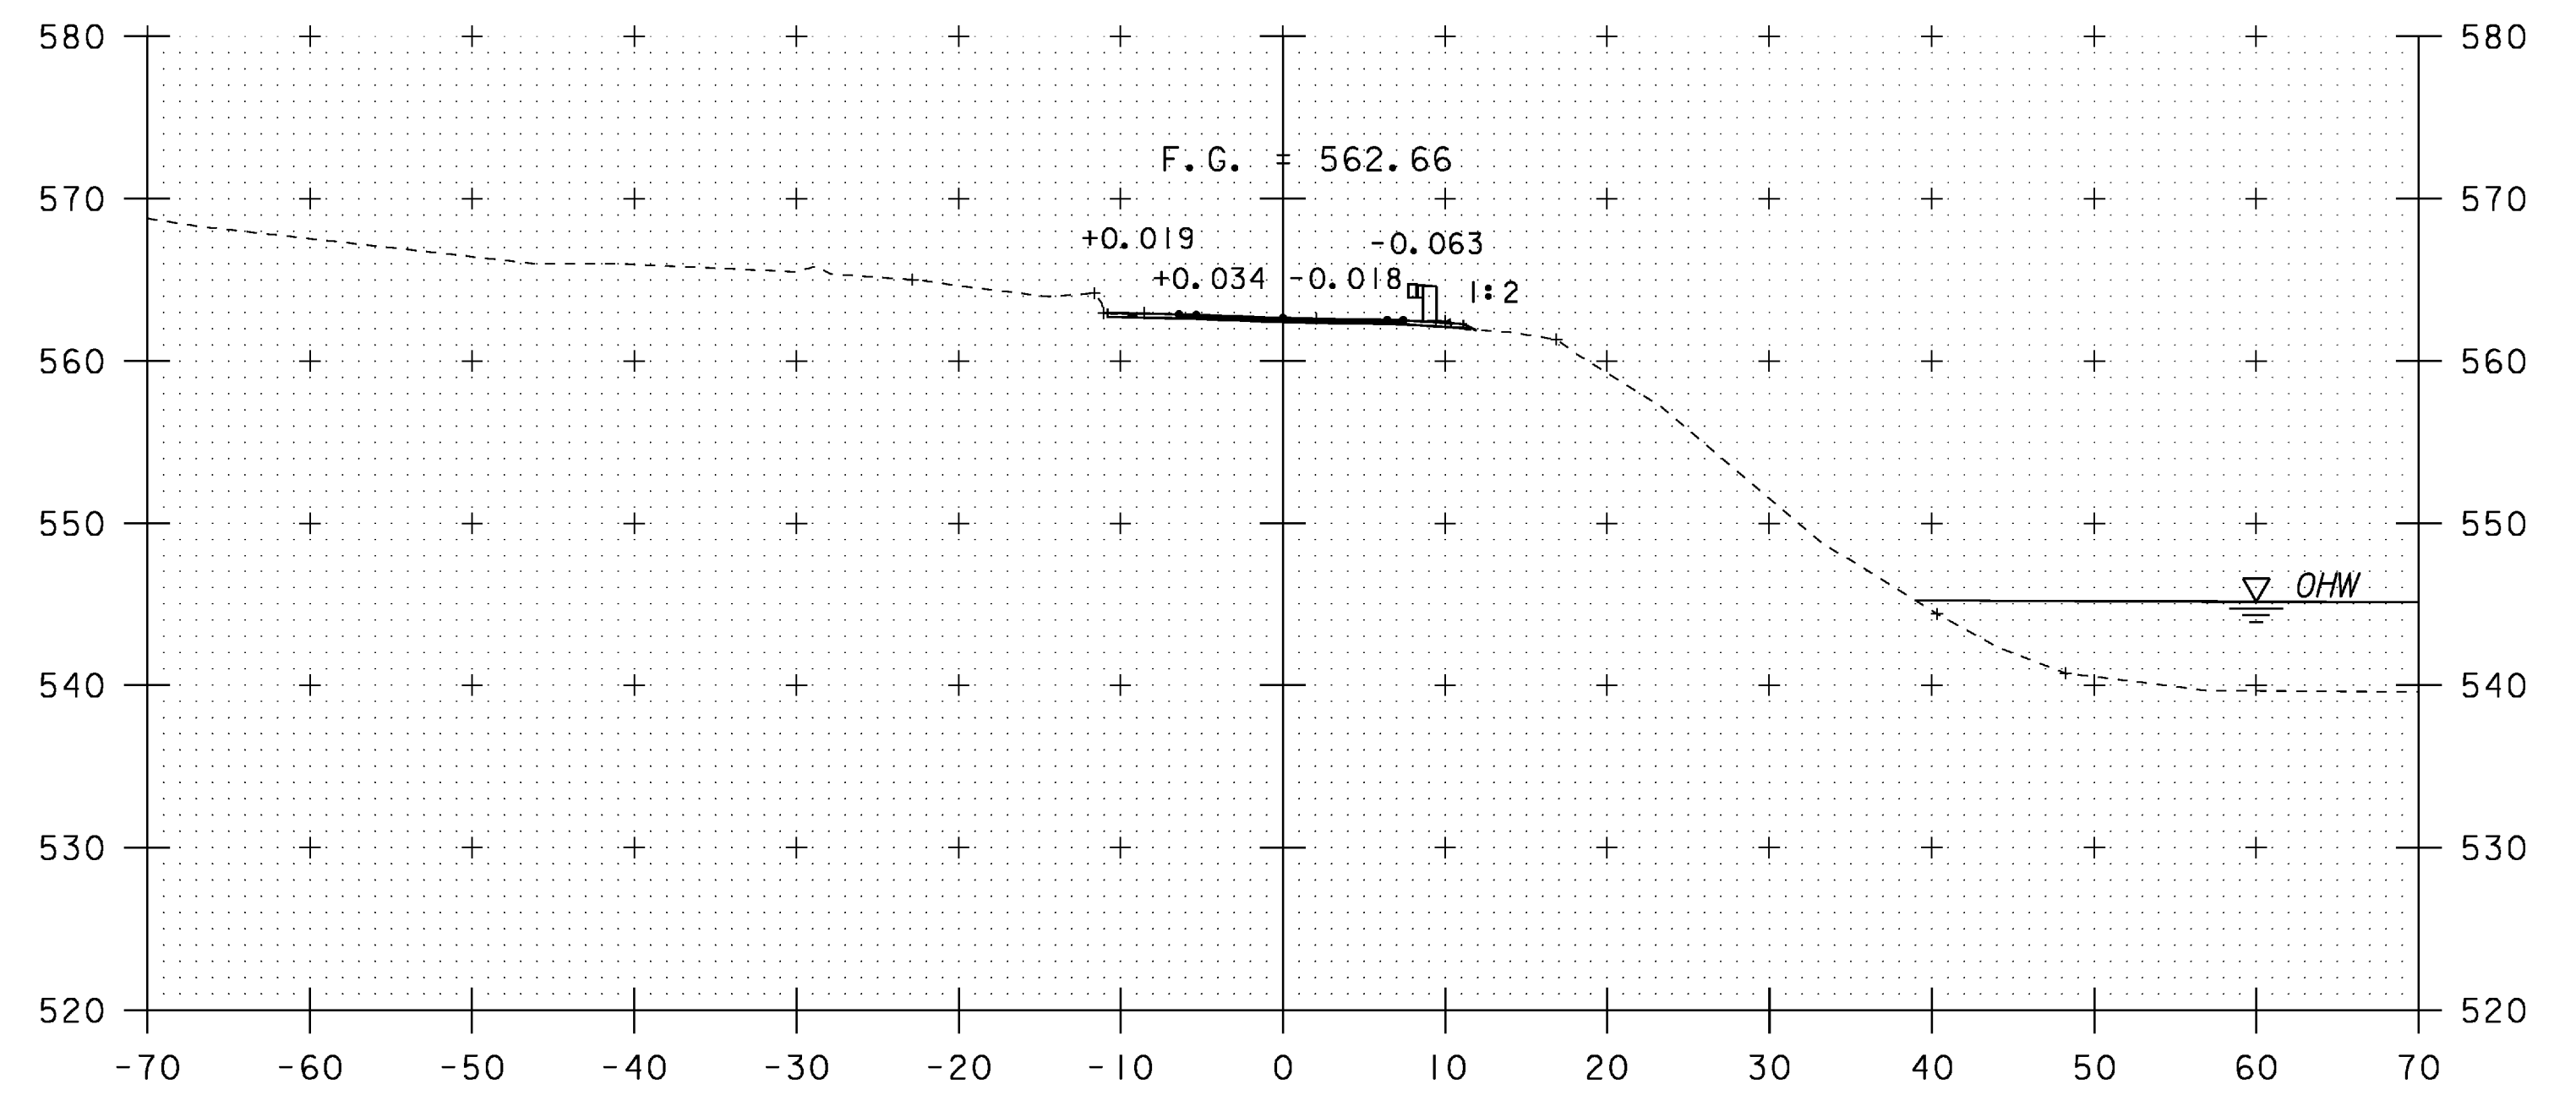

13+75

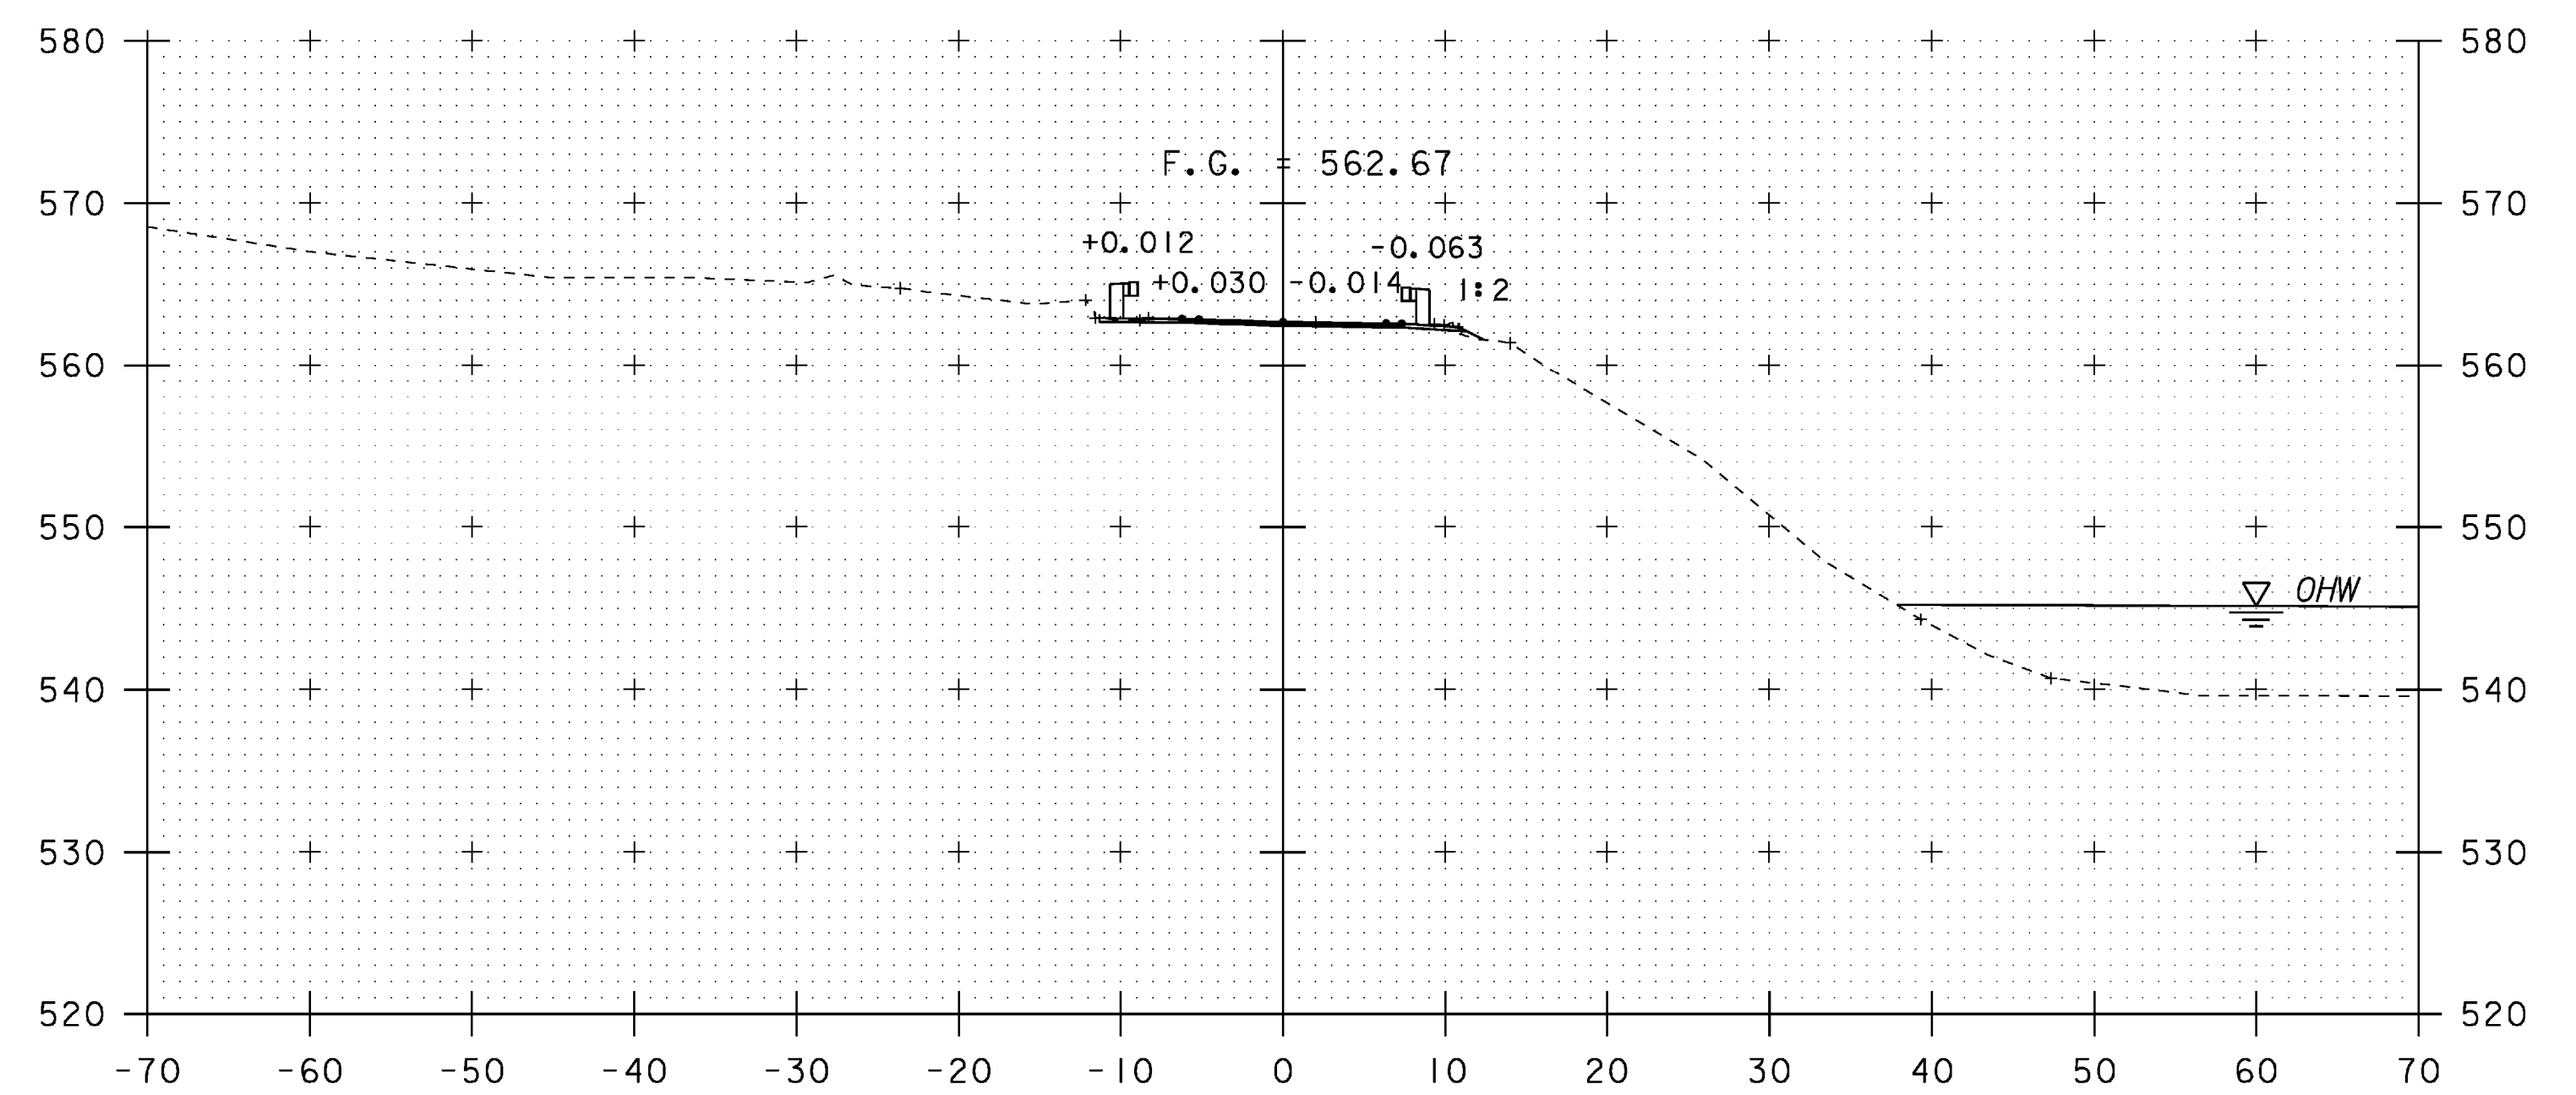

13+73

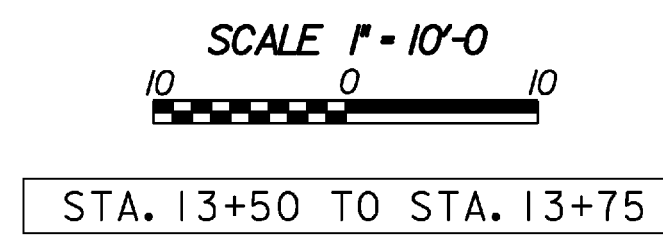

PROJECT NAME:	NEWANE	FILE NAME:	s96j230xs.dgn	PLOT DATE:	29-APR-2009
PROJECT NUMBER:	BHF 0106 (4)S	PROJECT LEADER:	R. WHITCOMB	DRAWN BY:	T. LACKEY
		DESIGNED BY:	T. LACKEY	CHECKED BY:	R. WHITCOMB
		MAINLINE CROSS SECTIONS 5		SHEET 62	OF 67