




14+00

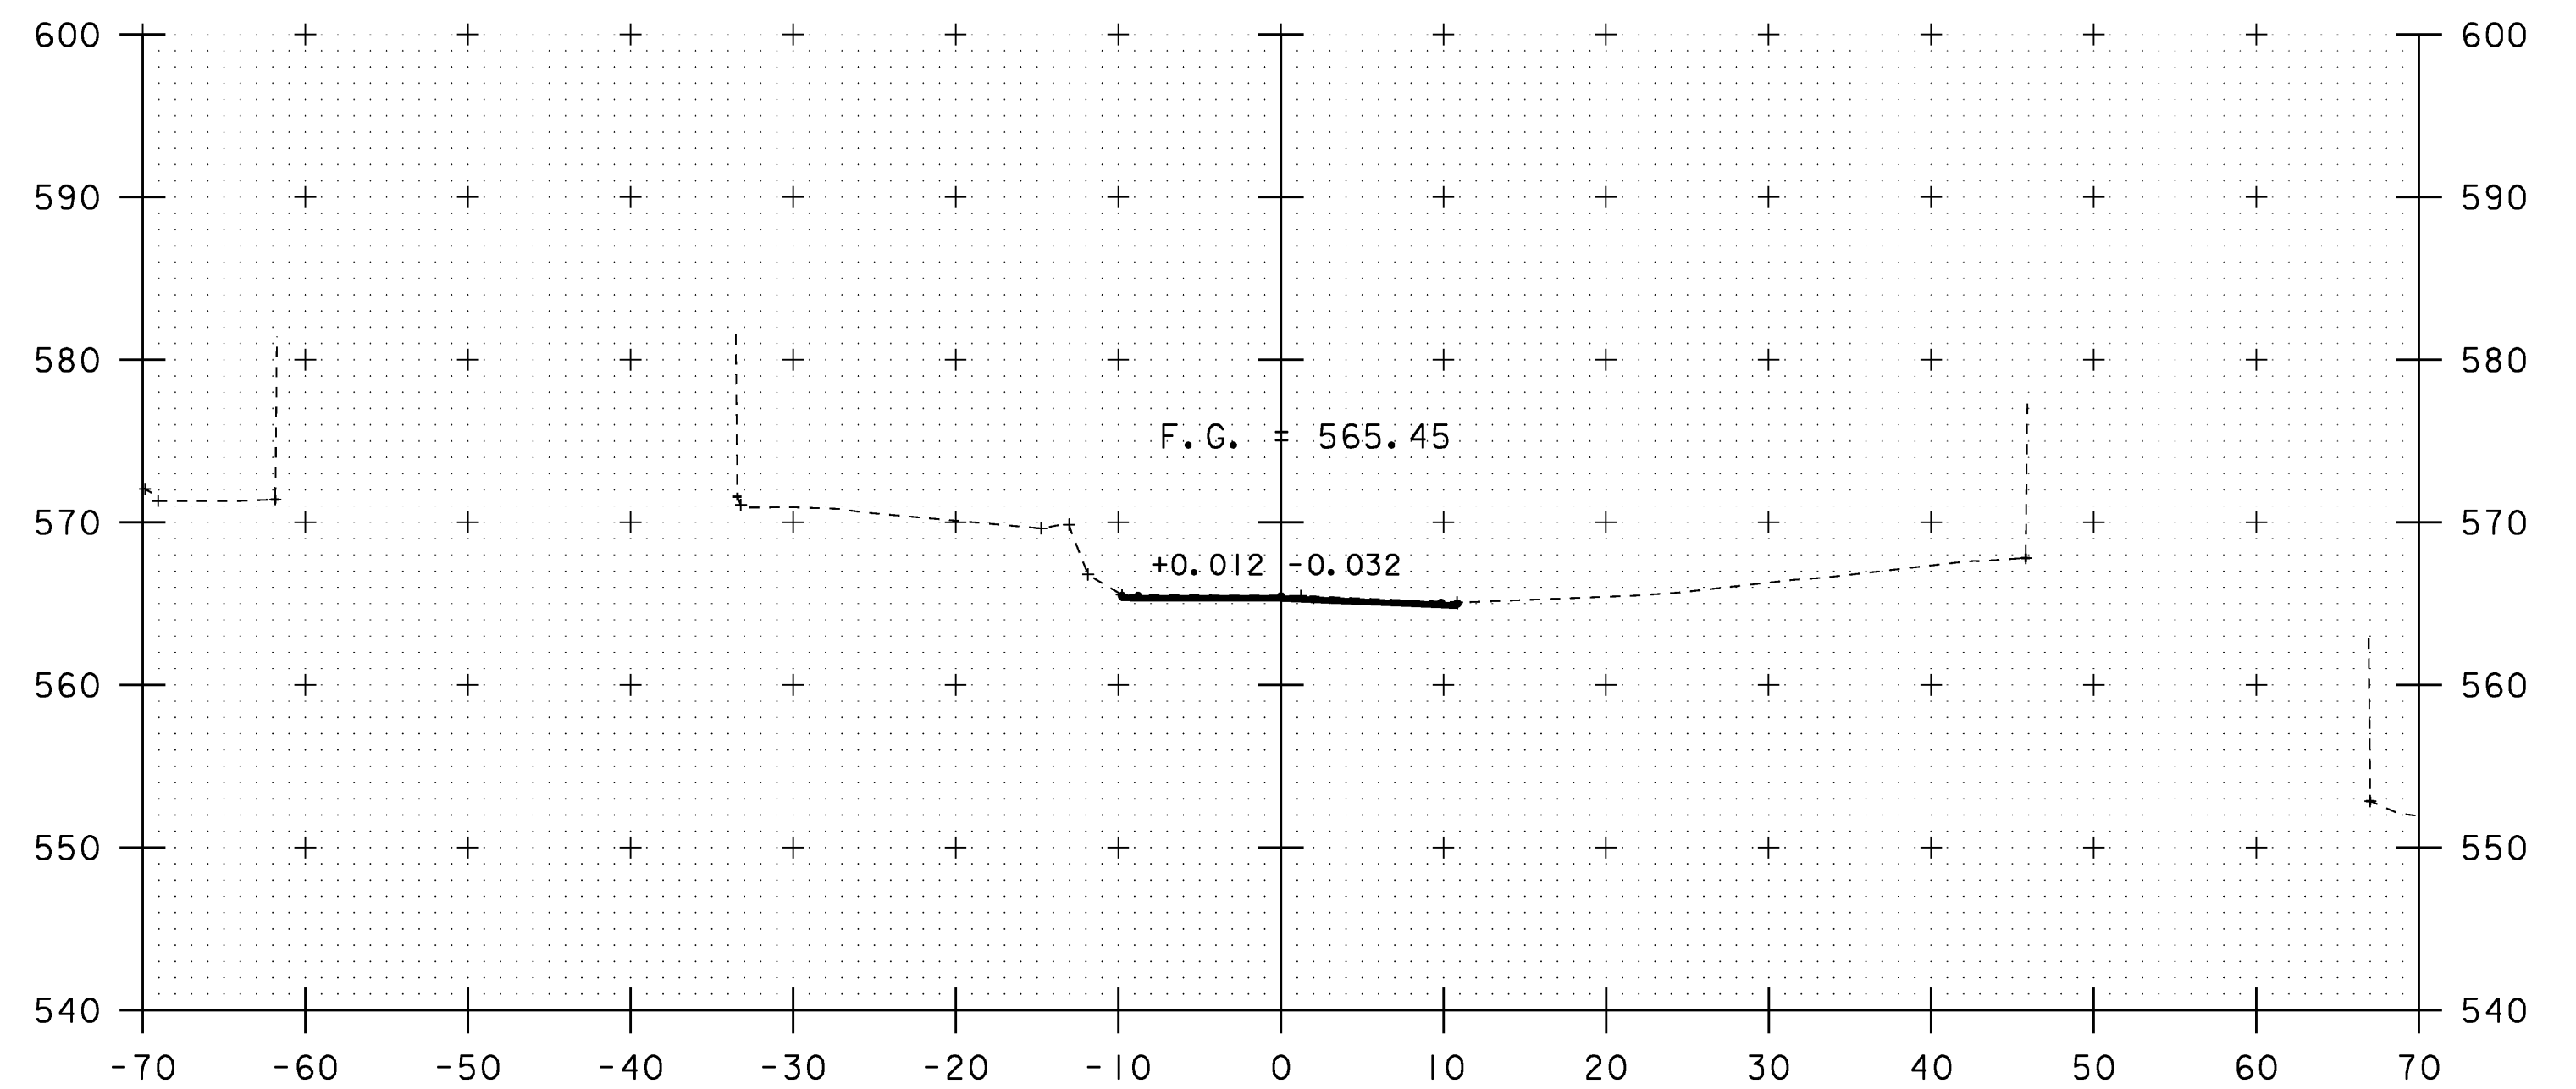


14+50

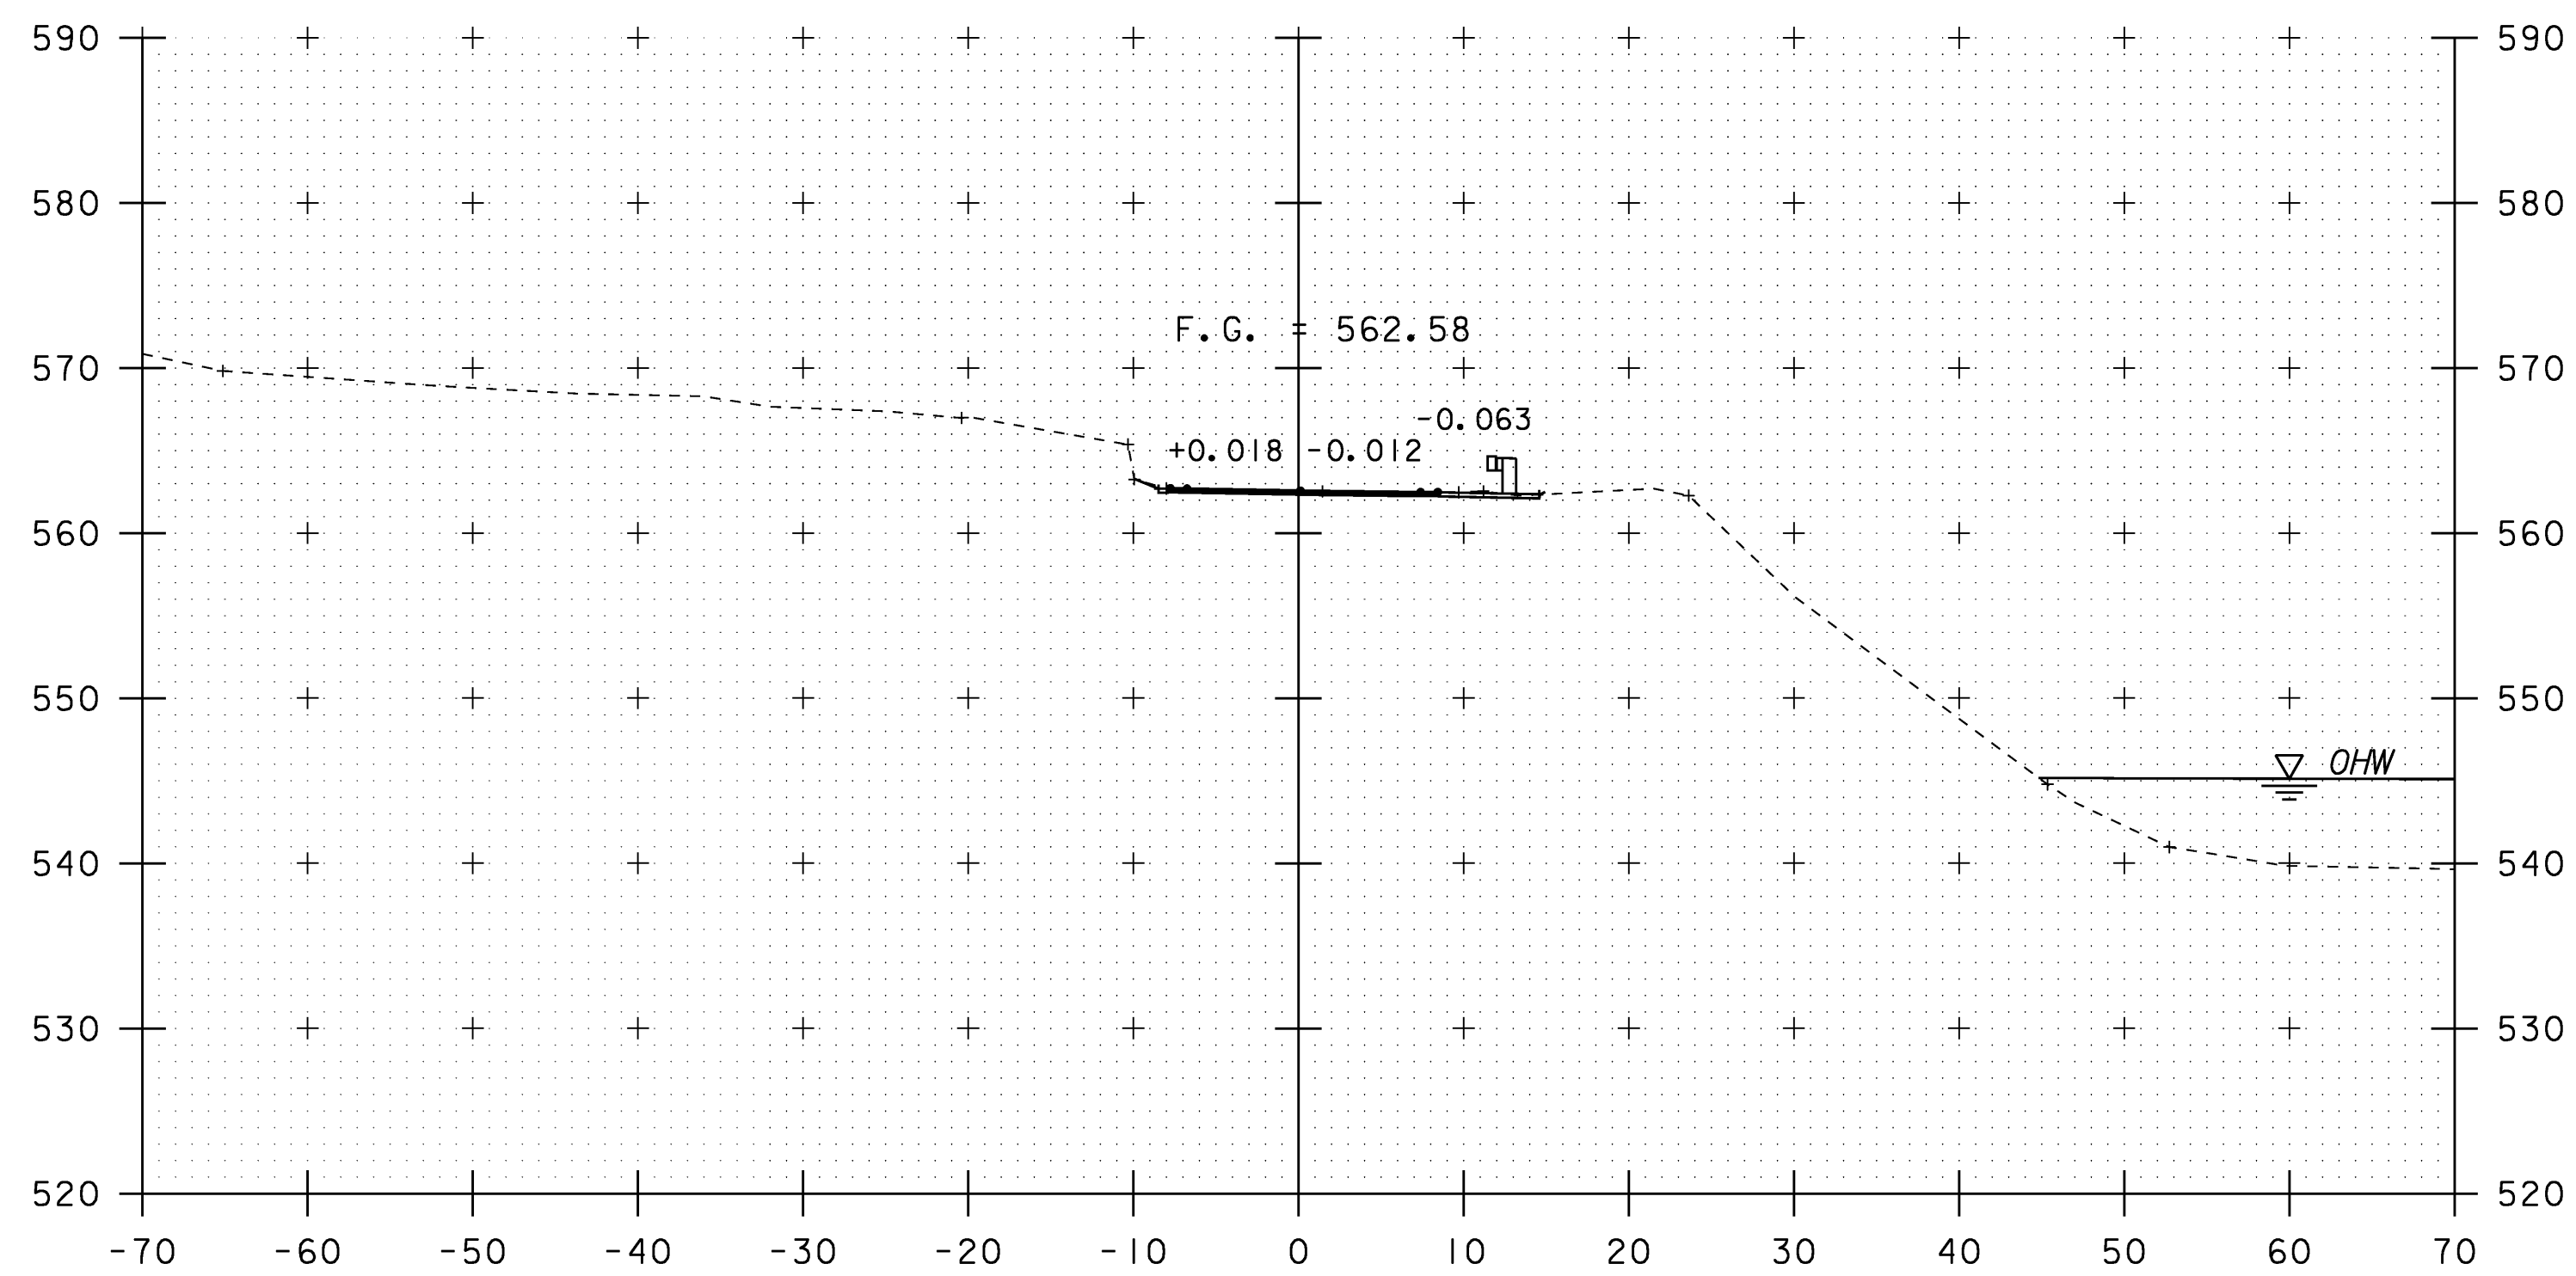

13+92

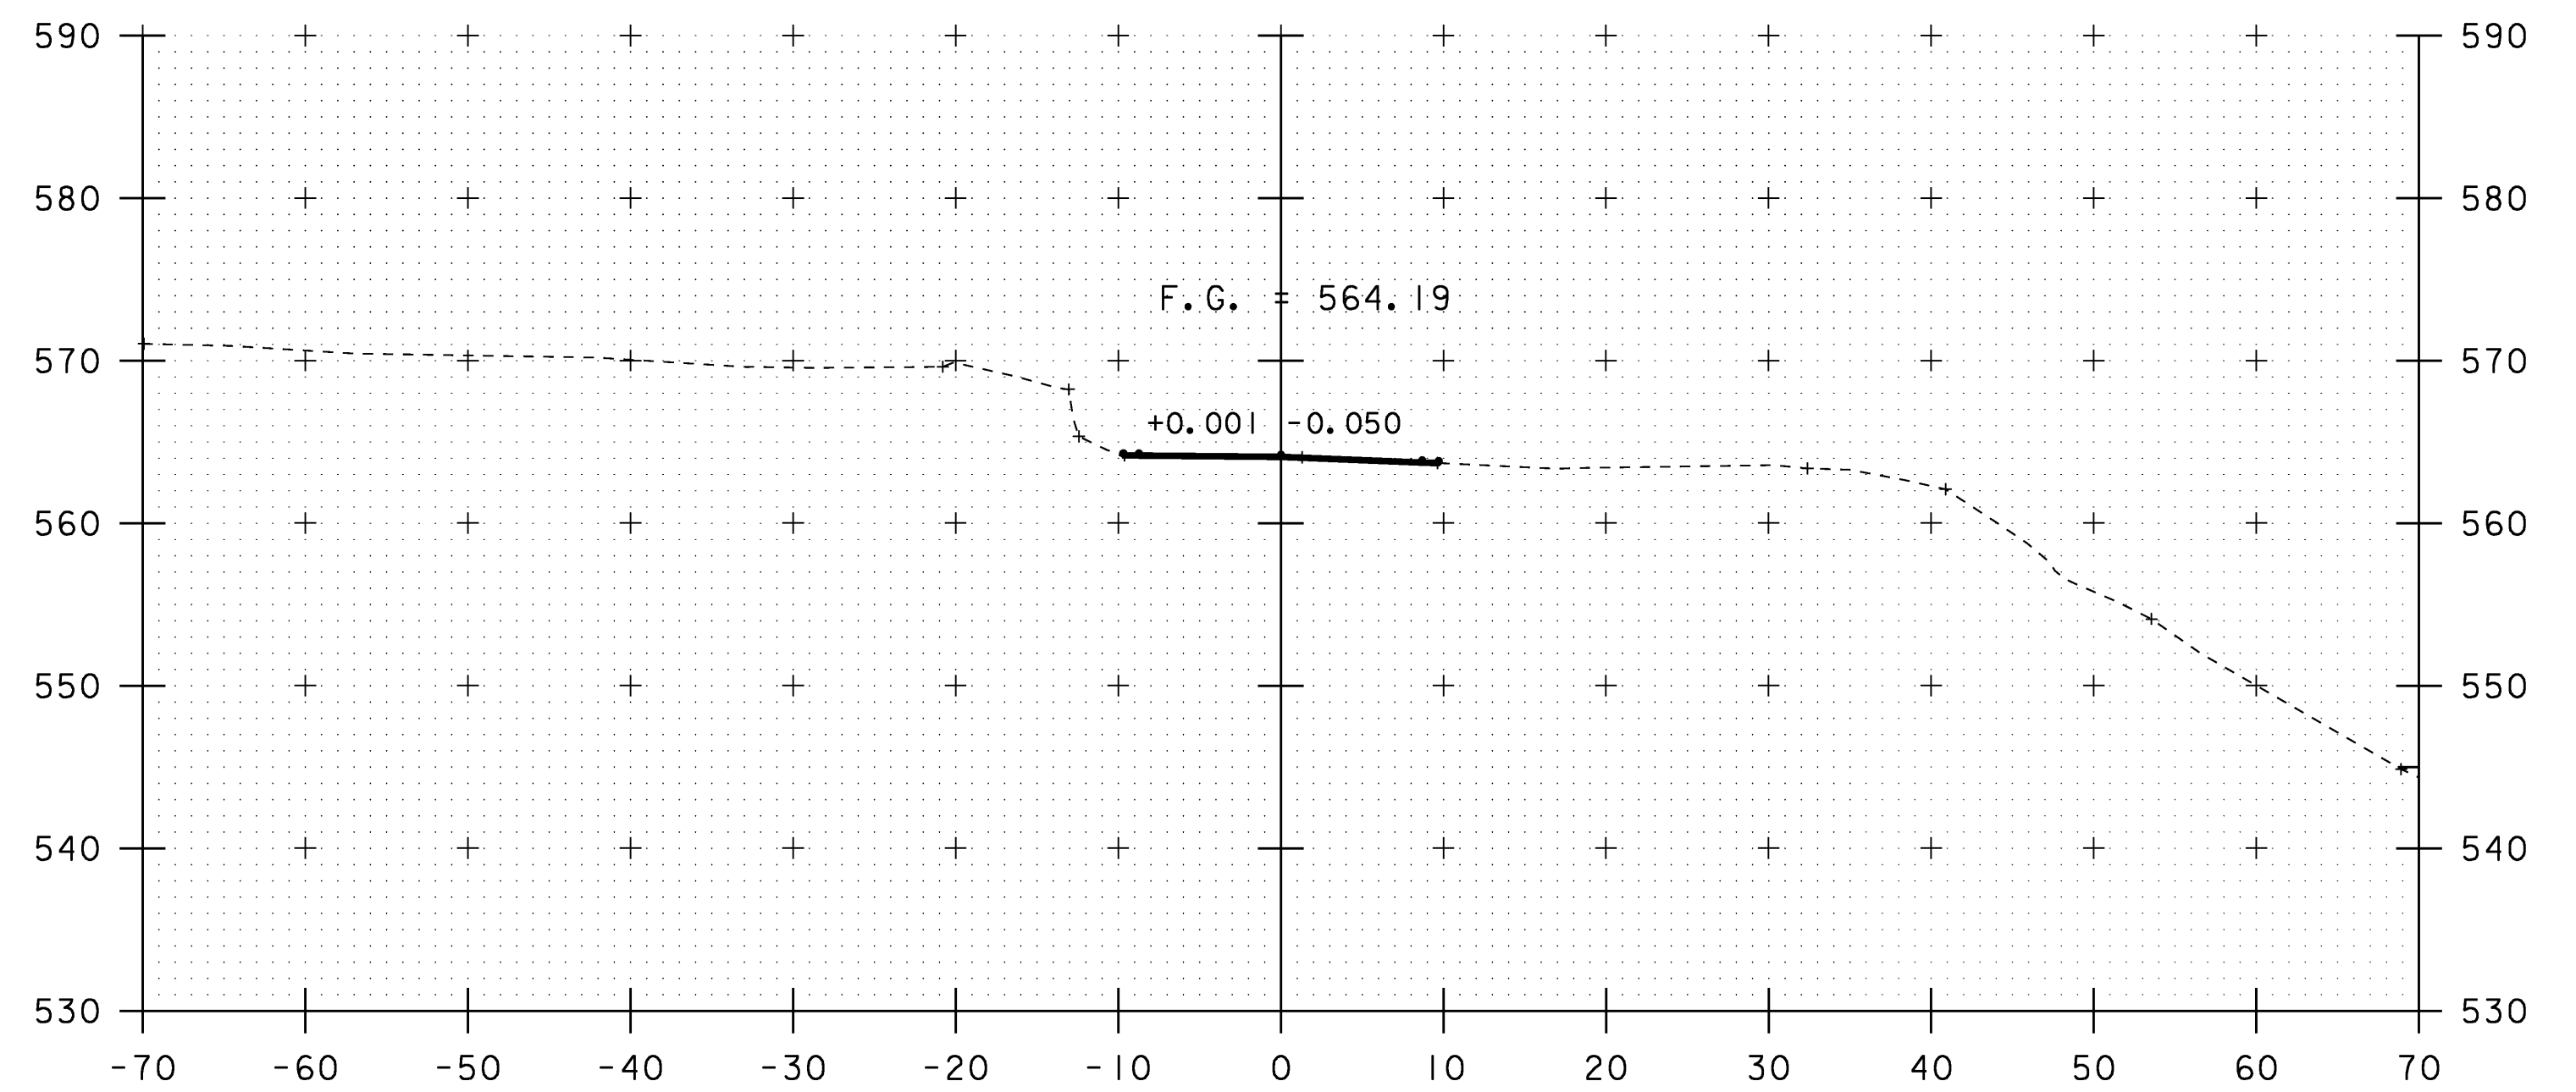

14+25

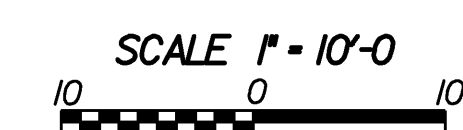

STA. 13+92 TO STA. 14+50

PROJECT NAME: NEWANE	PLOT DATE: 29-APR-2009
PROJECT NUMBER: BHF 0106 (4)S	DRAWN BY: T. LACKEY
FILE NAME: s96j230xs.dgn	CHECKED BY: R. WHITCOMB
PROJECT LEADER: R. WHITCOMB	SHEET 63 OF 67
DESIGNED BY: T. LACKEY	
MAINLINE CROSS SECTIONS 6	