
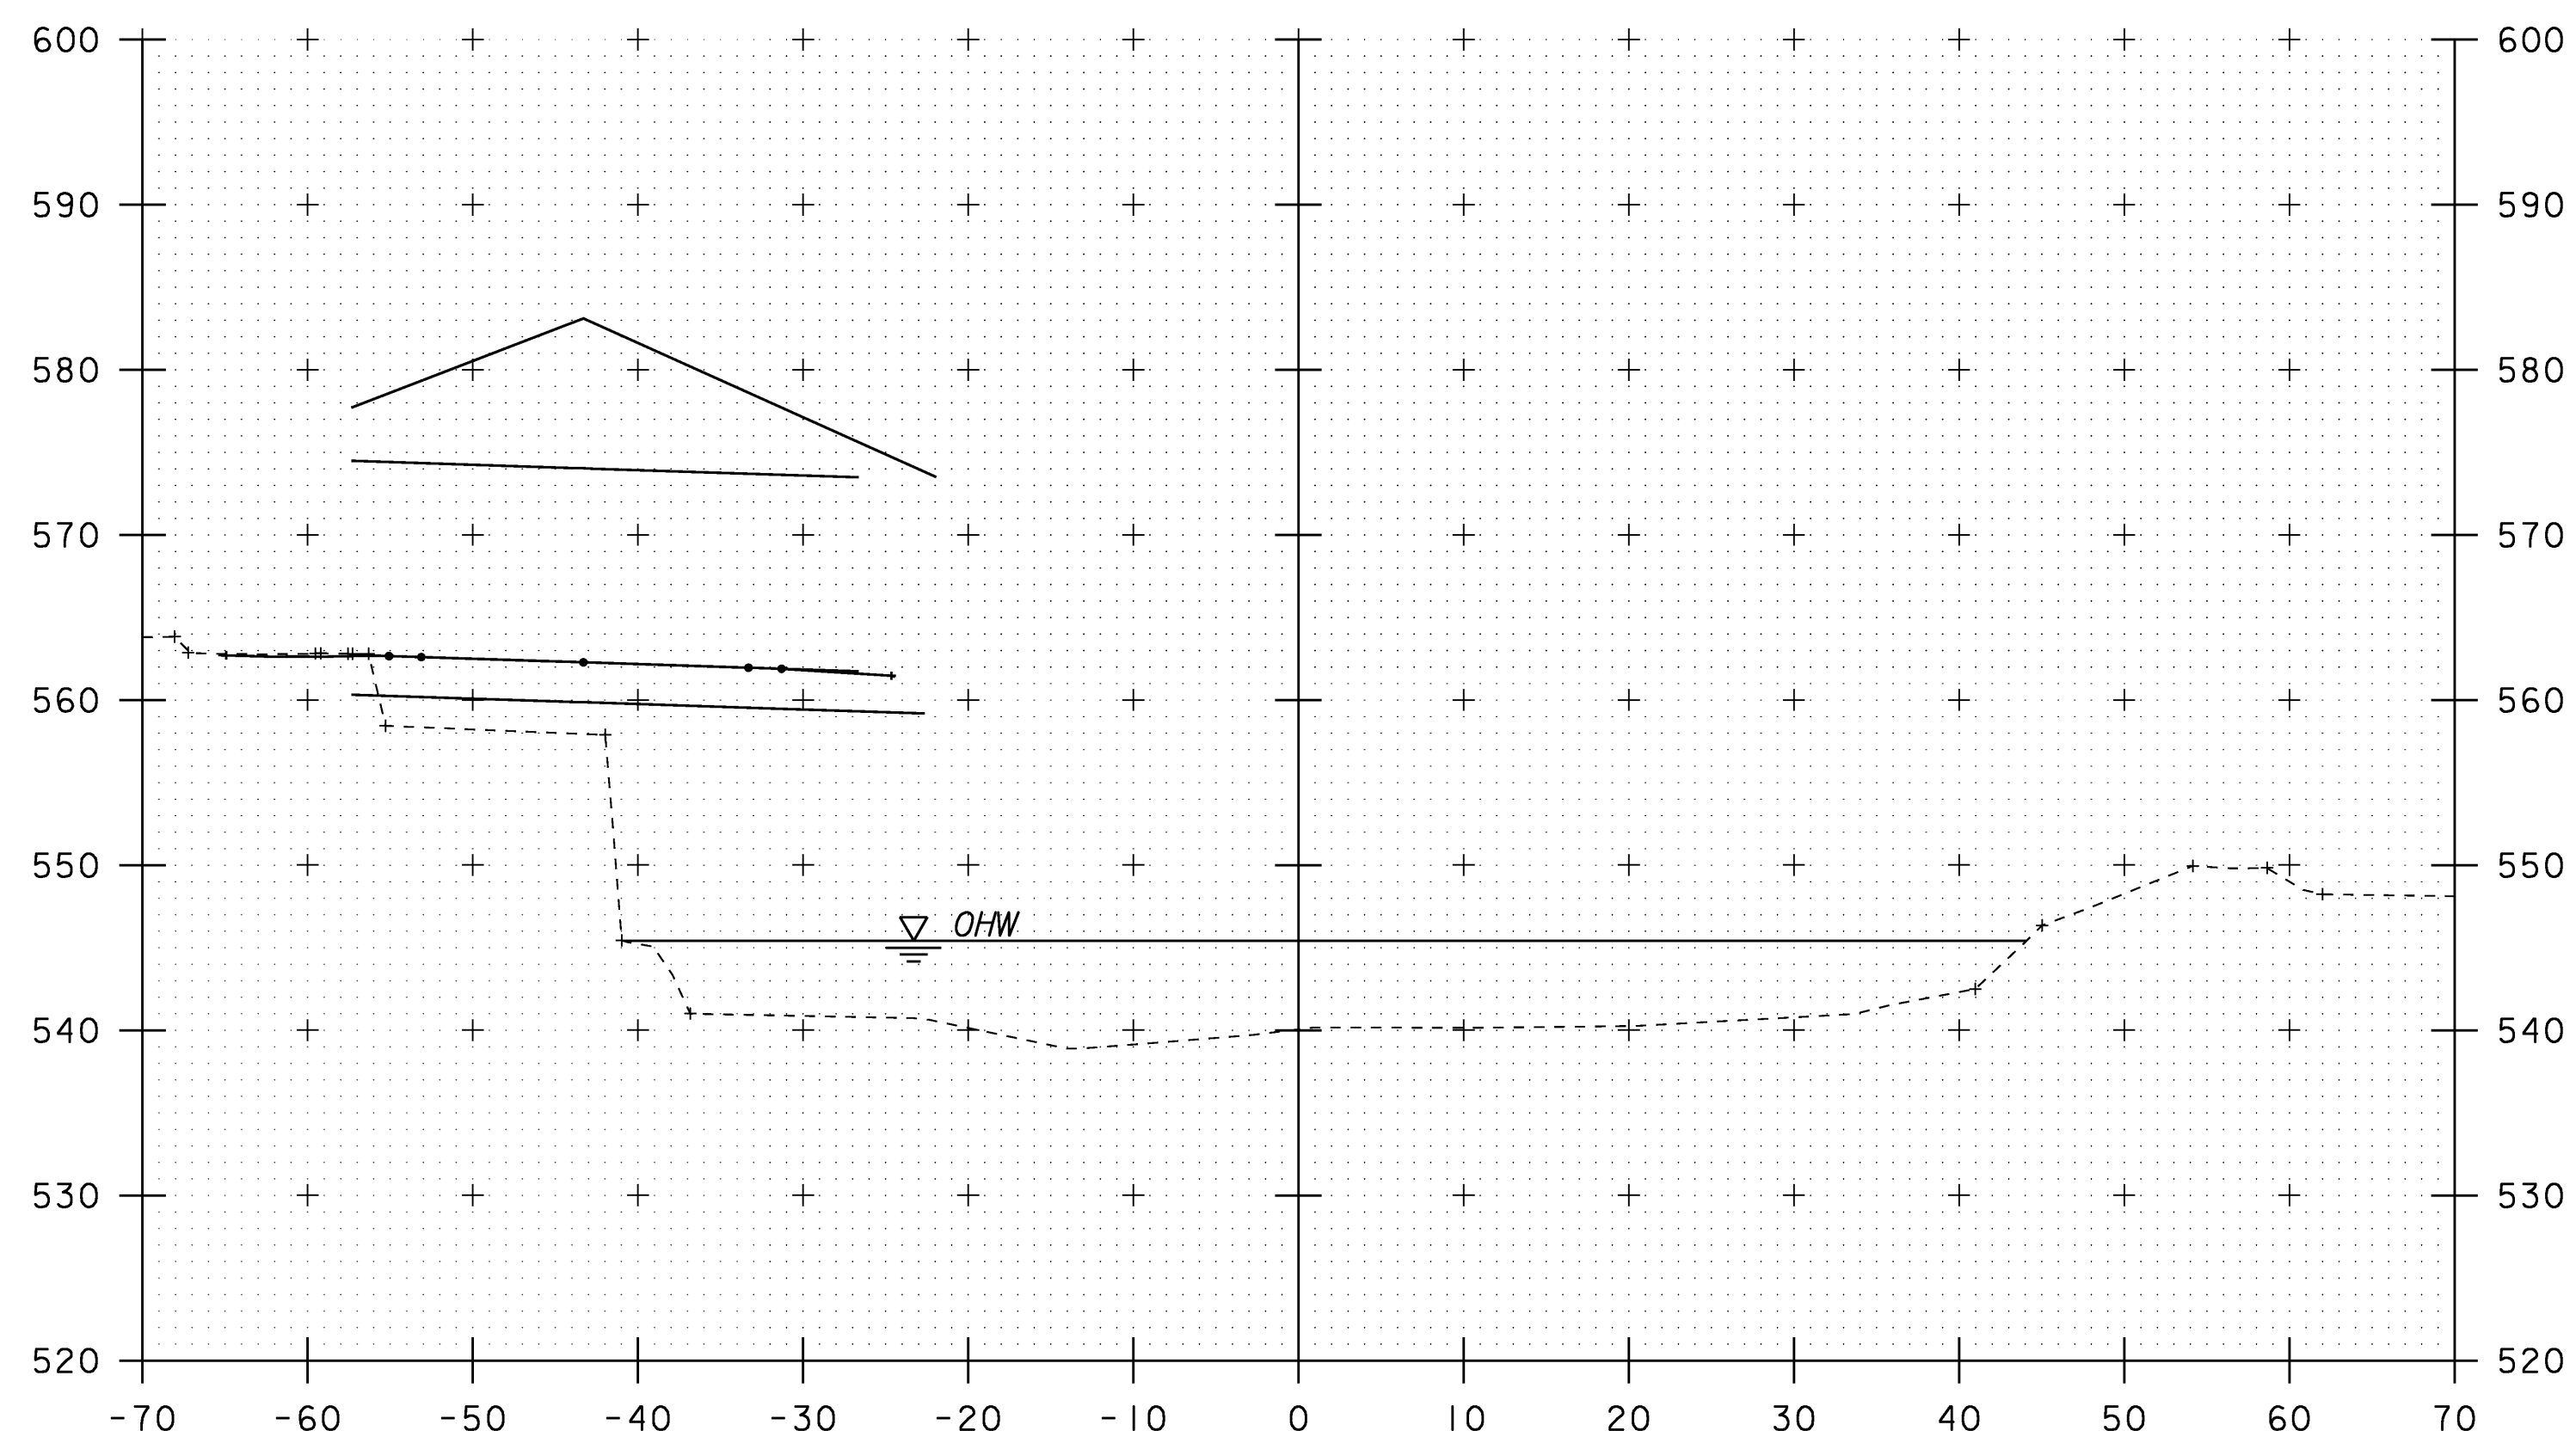


22+50

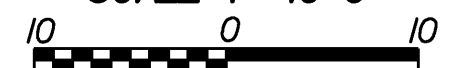

22+25

SCALE 1" = 10'-0"


STA. 22+25 TO STA. 22+50

PROJECT NAME: NEWANE	PLOT DATE: 29-APR-2009
PROJECT NUMBER: BHF 0106 (4)S	DRAWN BY: T. LACKEY
FILE NAME: s96j230xs.dgn	CHECKED BY: R. WHITCOMB
PROJECT LEADER: R. WHITCOMB	SHEET 66 OF 67
DESIGNED BY: T. LACKEY	
CHANNEL CROSS SECTIONS 2	