


1048
1041
1734

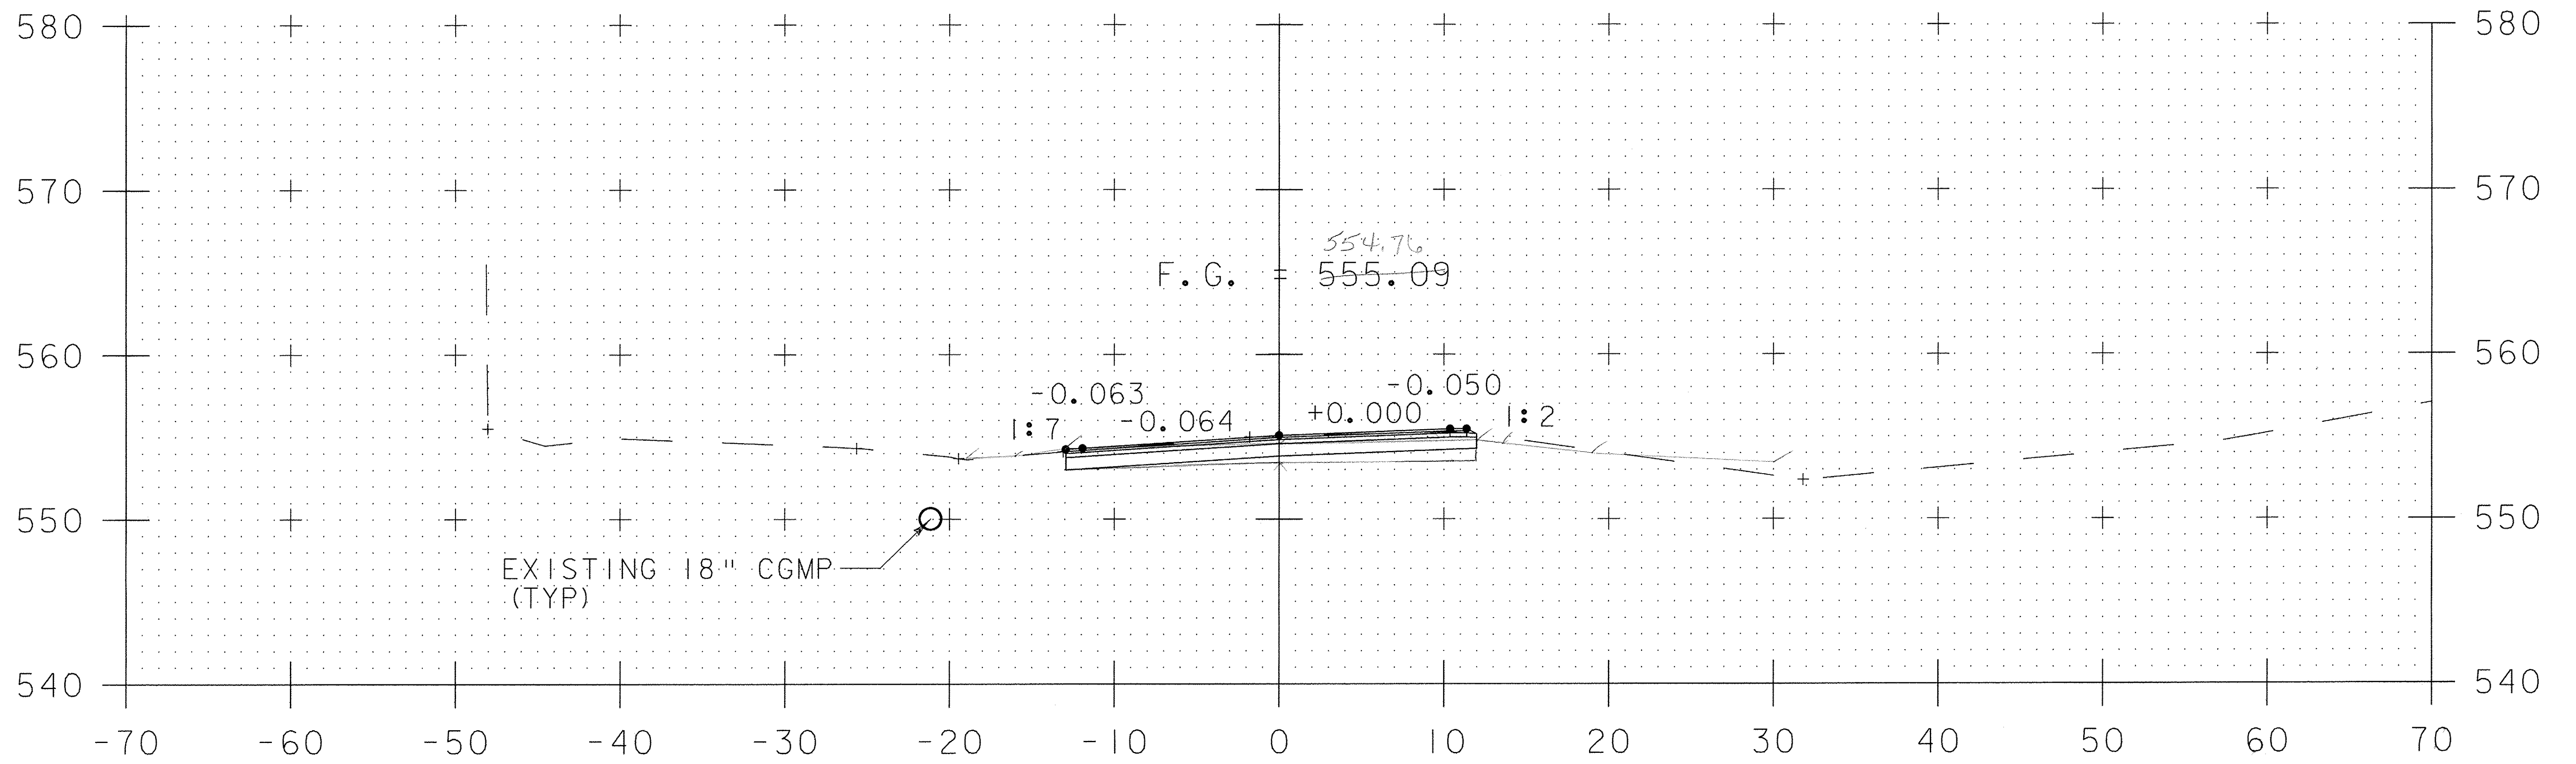

EXISTING 18" CGMP (TYP)

F.G. = 555.09

11+25

5 1/2" Pit 29'
9" SB

PROJECT NAME: NEWANE	PLOT DATE: 14-OCT-2010
PROJECT NUMBER: BHF 0106 (4)S	DRAWN BY: C. MOONEY
FILE NAME: s96j230conXsect.dgn	DESIGNED BY: T. LACKEY
DESIGNED BY: T. LACKEY	CHECKED BY: T. LACKEY
MAINLINE CROSS SECTIONS STA. 11+25	SHEET 5 OF 14