


1046

1039 : 400  
0.385 F.A. 1046  
20-17

161

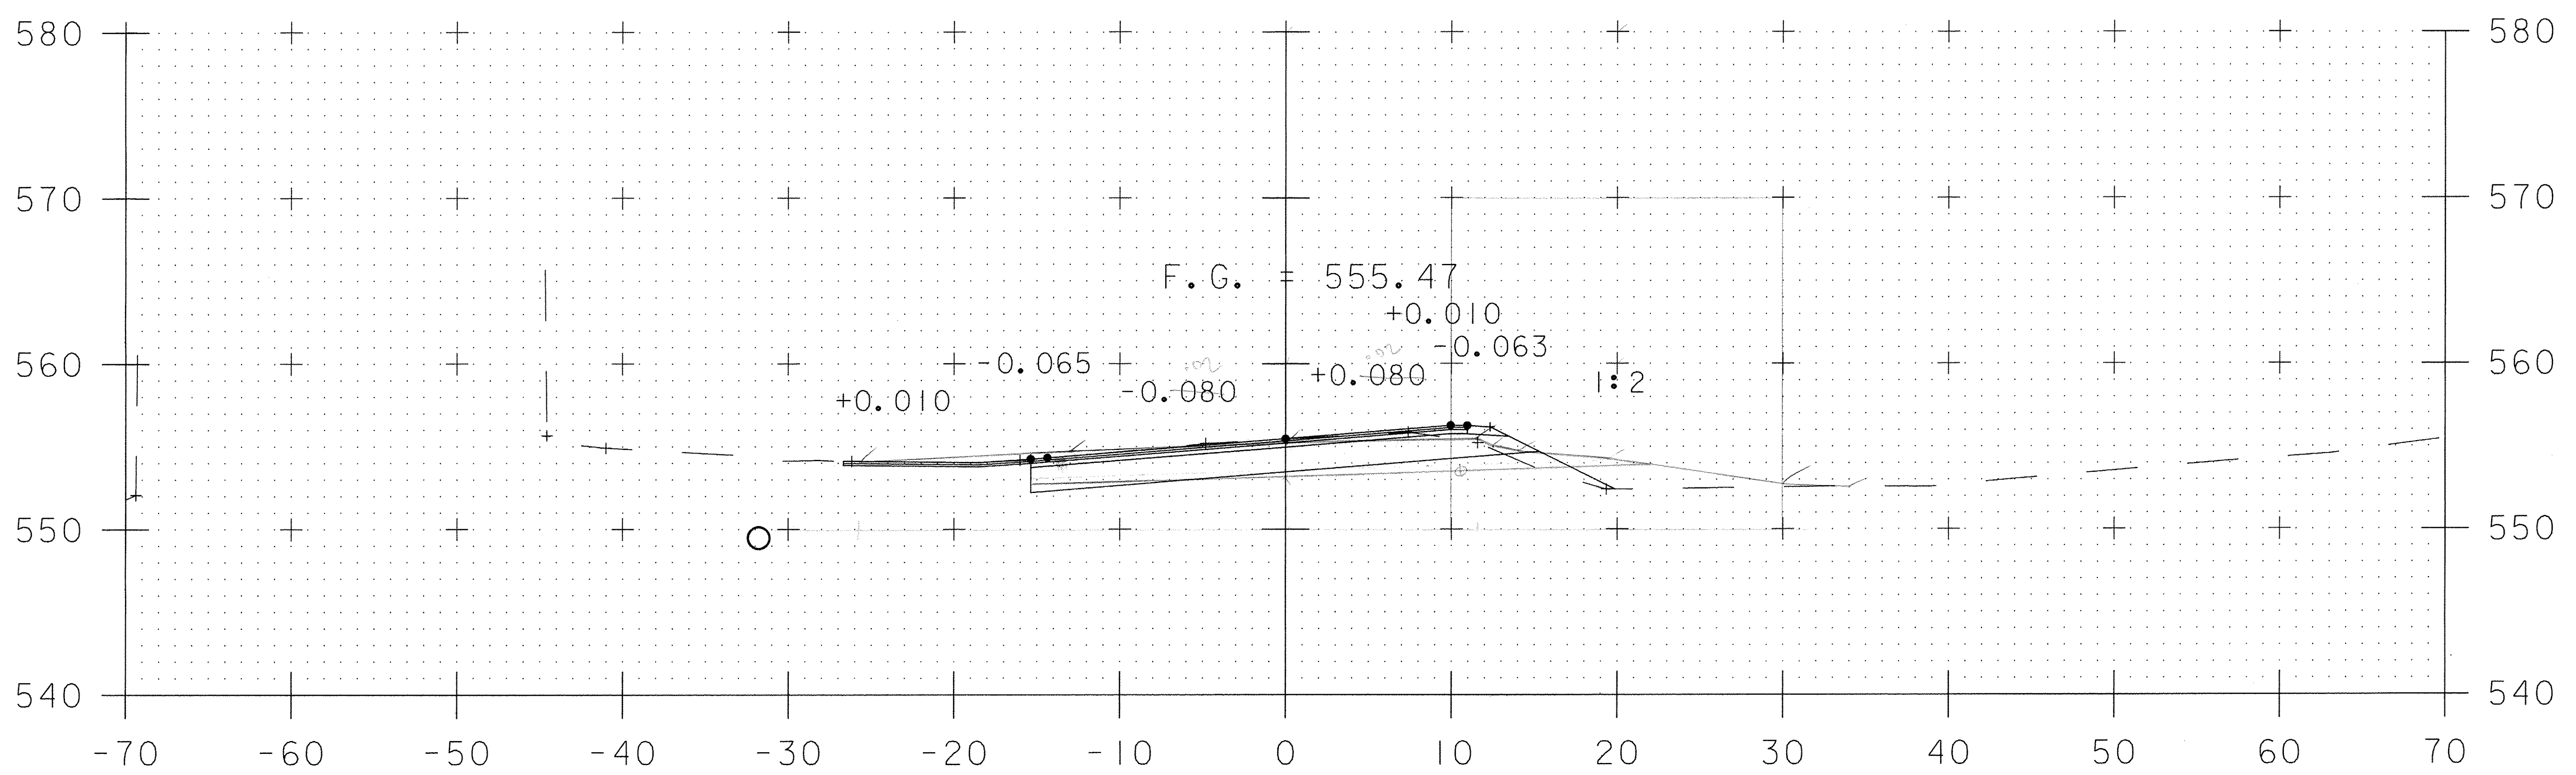

11+50

ML 11+50  
BEGIN SAND

5 1/2" PA  
18" CB  
62'

PROJECT NAME: NEWANE	
PROJECT NUMBER: BHF 0106 (4)S	
FILE NAME: s96j230conXsect.dgn	PLOT DATE: 14-OCT-2010
PROJECT LEADER: C. CARLSON	DRAWN BY: C. MOONEY
DESIGNED BY: T. LACKEY	CHECKED BY: T. LACKEY
MAINLINE CROSS SECTIONS STA. 11+50	SHEET 6 OF 14