


2.79
2.84
2.915

CB Depth
11+50 18"
11+75 18" + 15" = 33"
11+67 $\frac{17}{25}(15) + 18 = 23.2"$

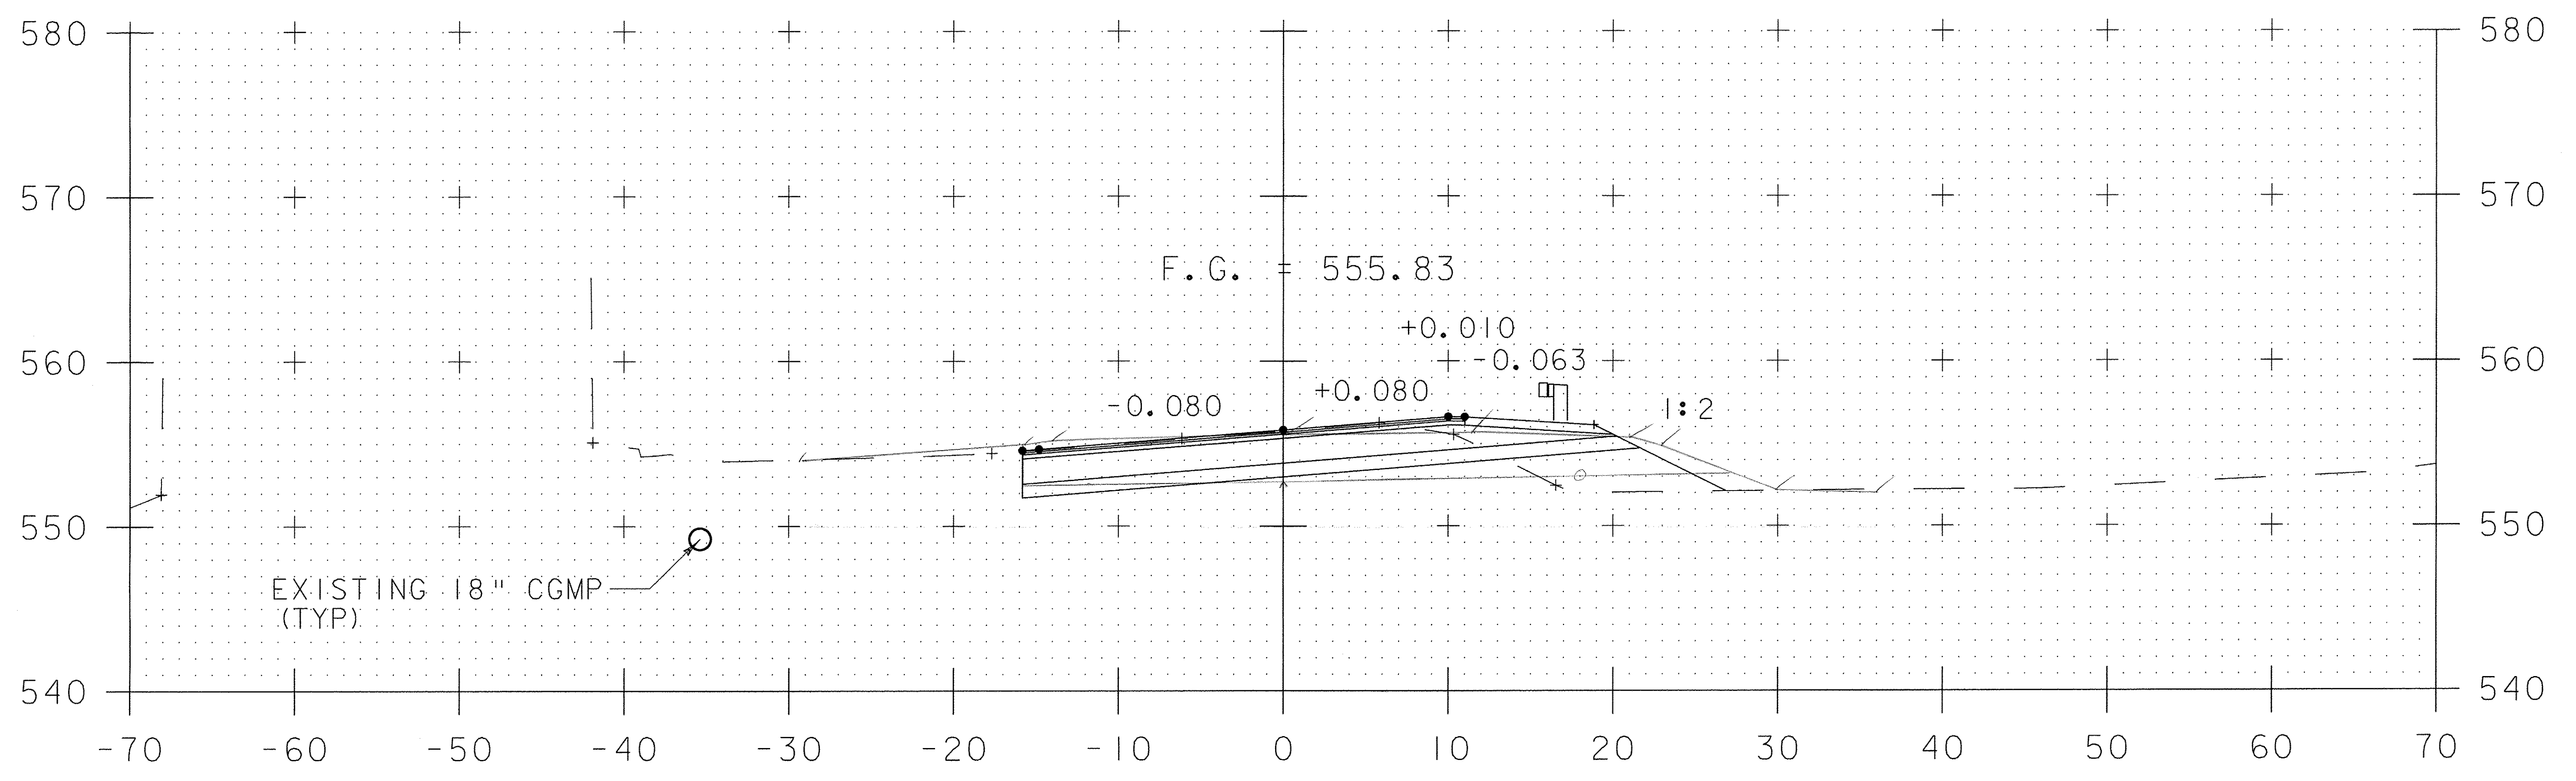

11+67

5 1/2" PA
23.2" CB
108

PROJECT NAME: NEWANE	
PROJECT NUMBER: BHF 0106 (4)S	
FILE NAME: s96j230conXsec+.dgn	PLOT DATE: 14-OCT-2010
PROJECT LEADER: C. CARLSON	DRAWN BY: C. MOONEY
DESIGNED BY: T. LACKEY	CHECKED BY: T. LACKEY
MAINLINE CROSS SECTIONS STA. 11+67	SHEET 7 OF 14