


287
3/2 2010

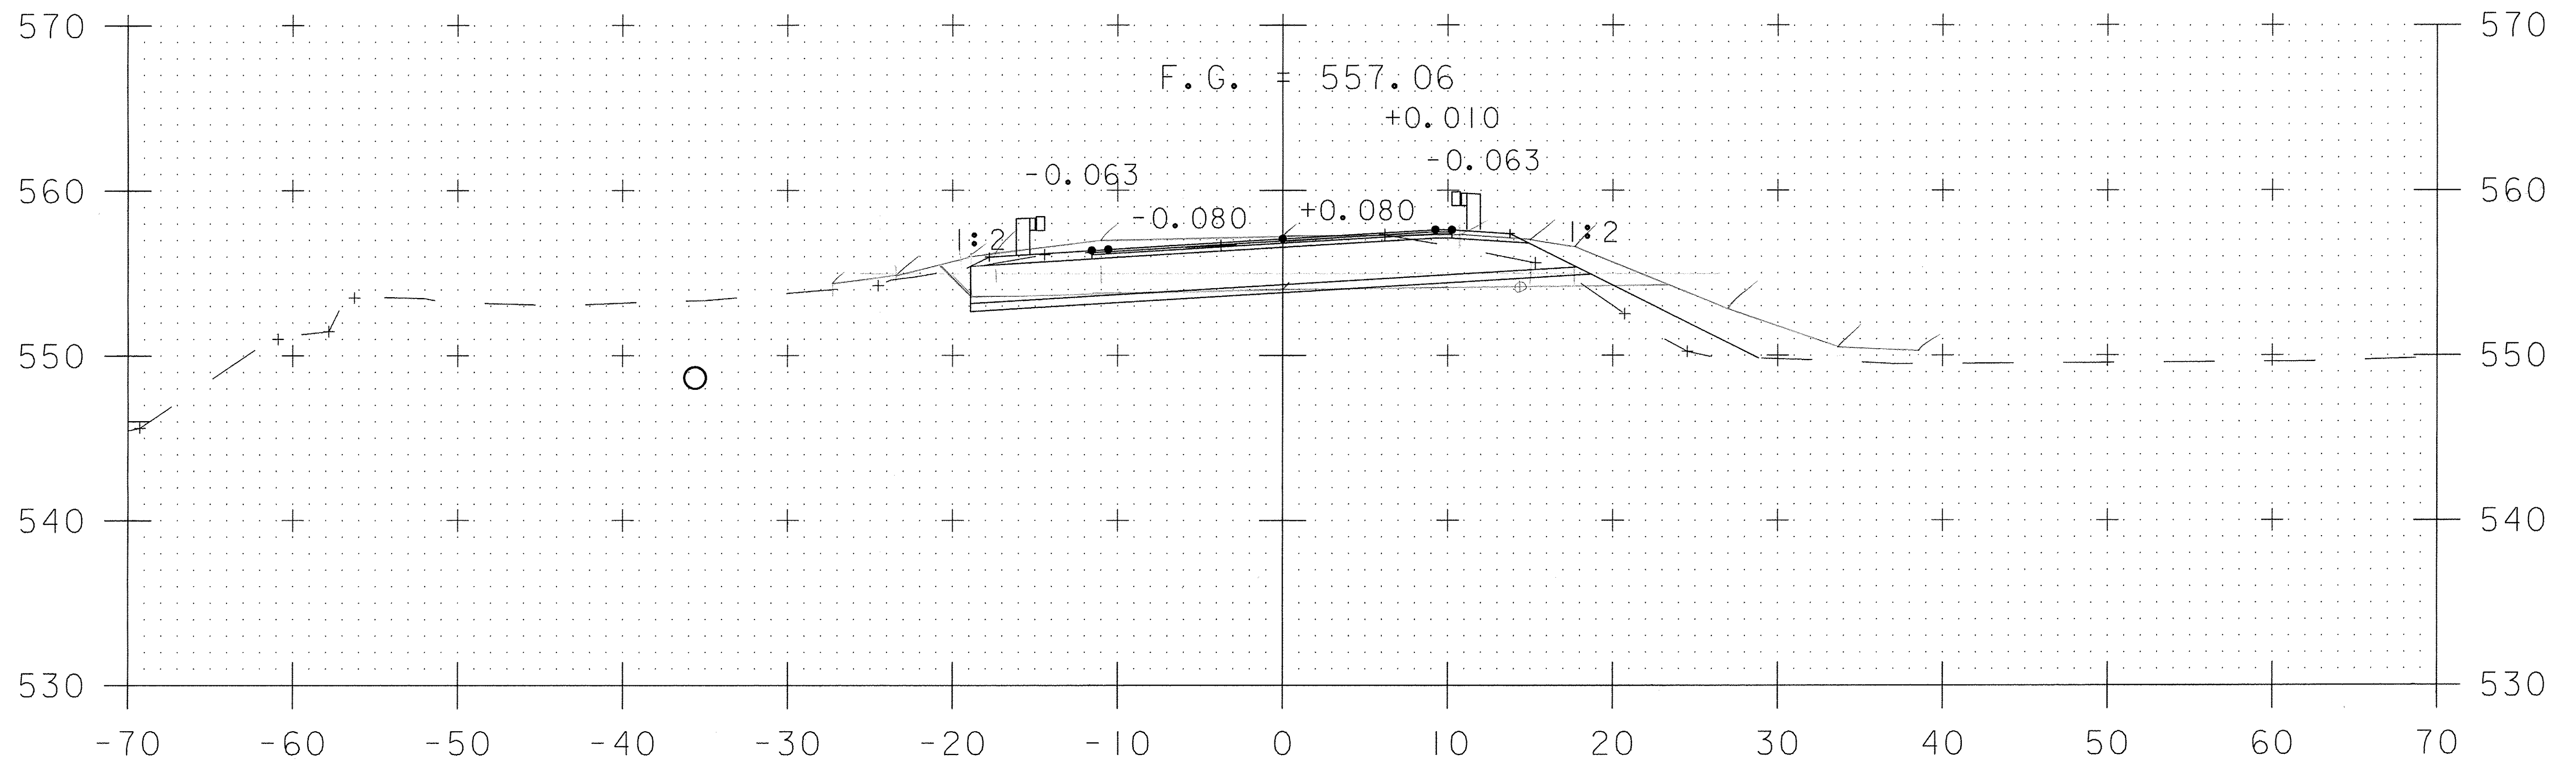

12+10

33" SB
5 1/2" Pd. 121'

PROJECT NAME:	NEWANE
PROJECT NUMBER:	BHF 0106 (4)S
FILE NAME:	s96j230conXsect.dgn
PROJECT LEADER:	C. CARLSON
DESIGNED BY:	T. LACKEY
MAINLINE CROSS SECTIONS:	STA. 12+10
PLOT DATE:	14-OCT-2010
DRAWN BY:	C. MOONEY
CHECKED BY:	T. LACKEY
SHEET:	10 OF 14