


Total depth  
 11+90 13 1/2"  
 12+42 18"  
 $\frac{25}{22} (43-28) + 22 \frac{1}{2} = 40"$

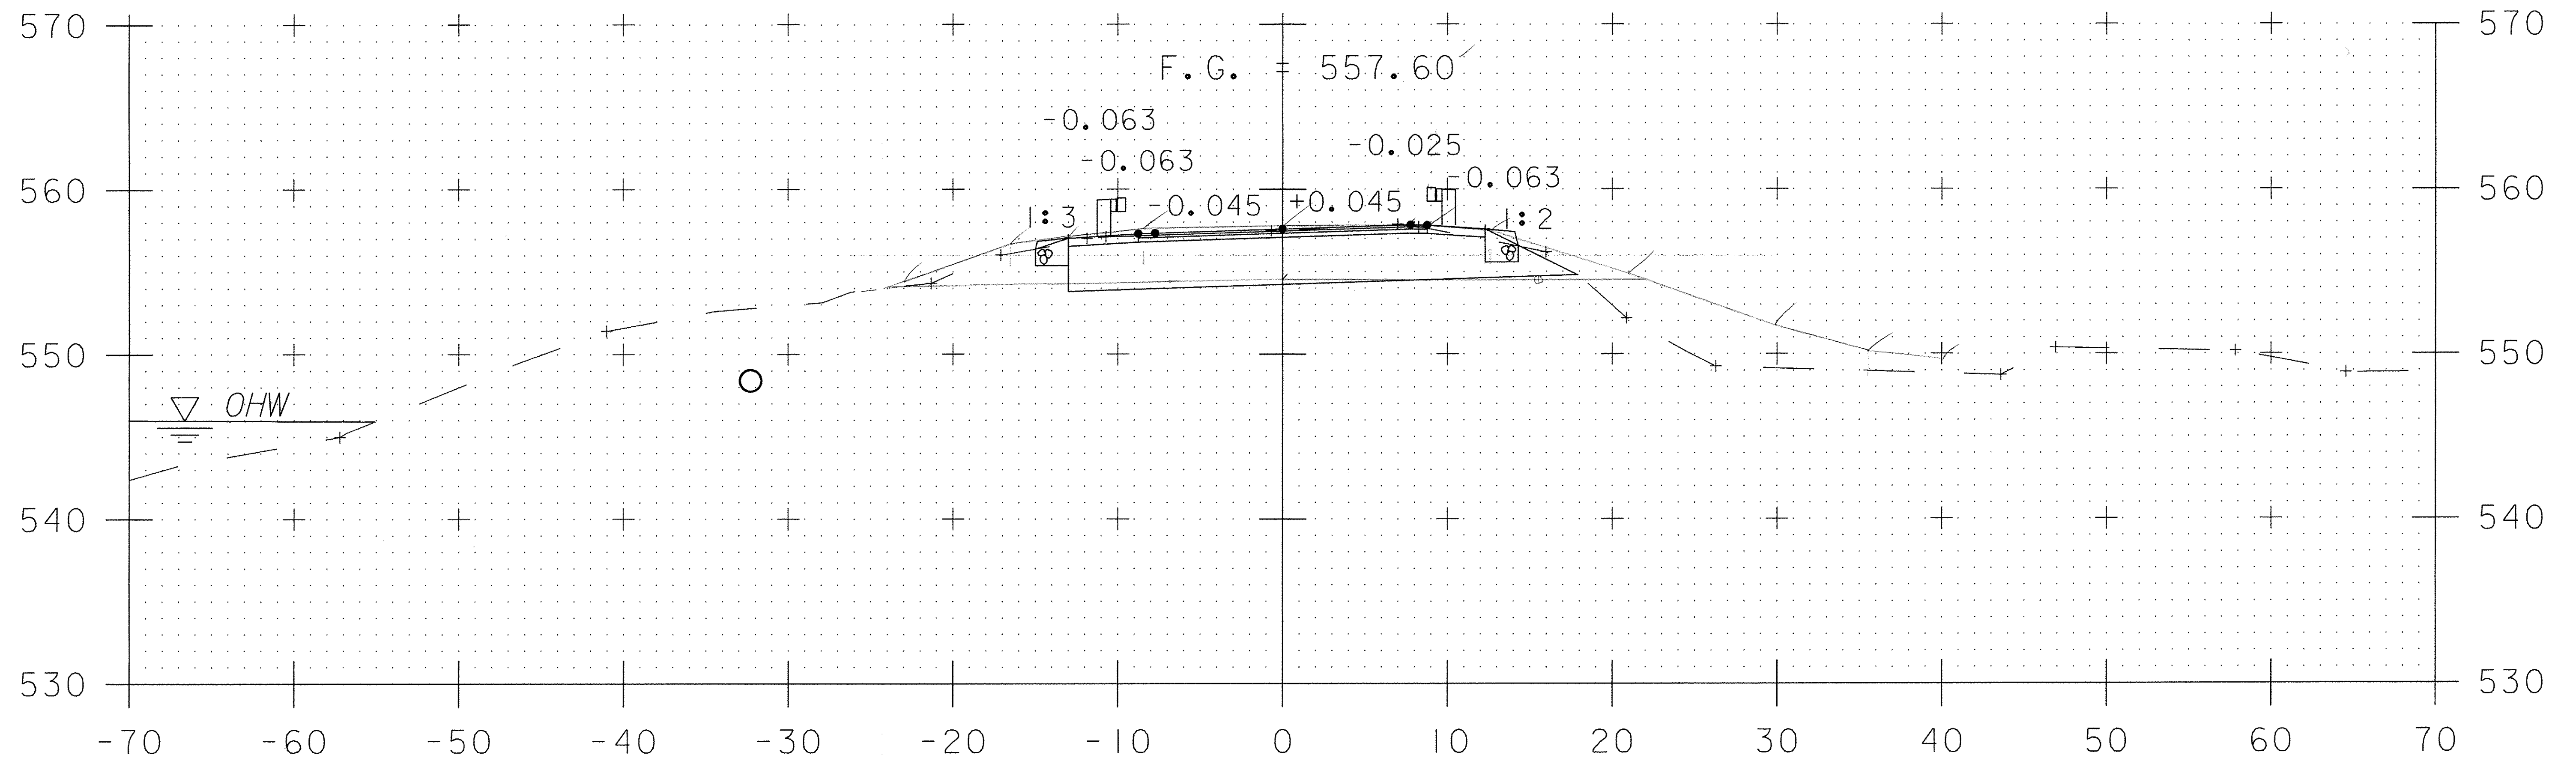

12+25

ML 12+22.5  
 END SAND

PROJECT NAME: NEWANE	
PROJECT NUMBER: BHF 0106 (4)S	
FILE NAME: s96j230conXsect.dgn	PLOT DATE: 14-OCT-2010
PROJECT LEADER: C. CARLSON	DRAWN BY: C. MOONEY
DESIGNED BY: T. LACKEY	CHECKED BY: T. LACKEY
MAINLINE CROSS SECTIONS STA. 12+25	SHEET 11 OF 14