


157  
127

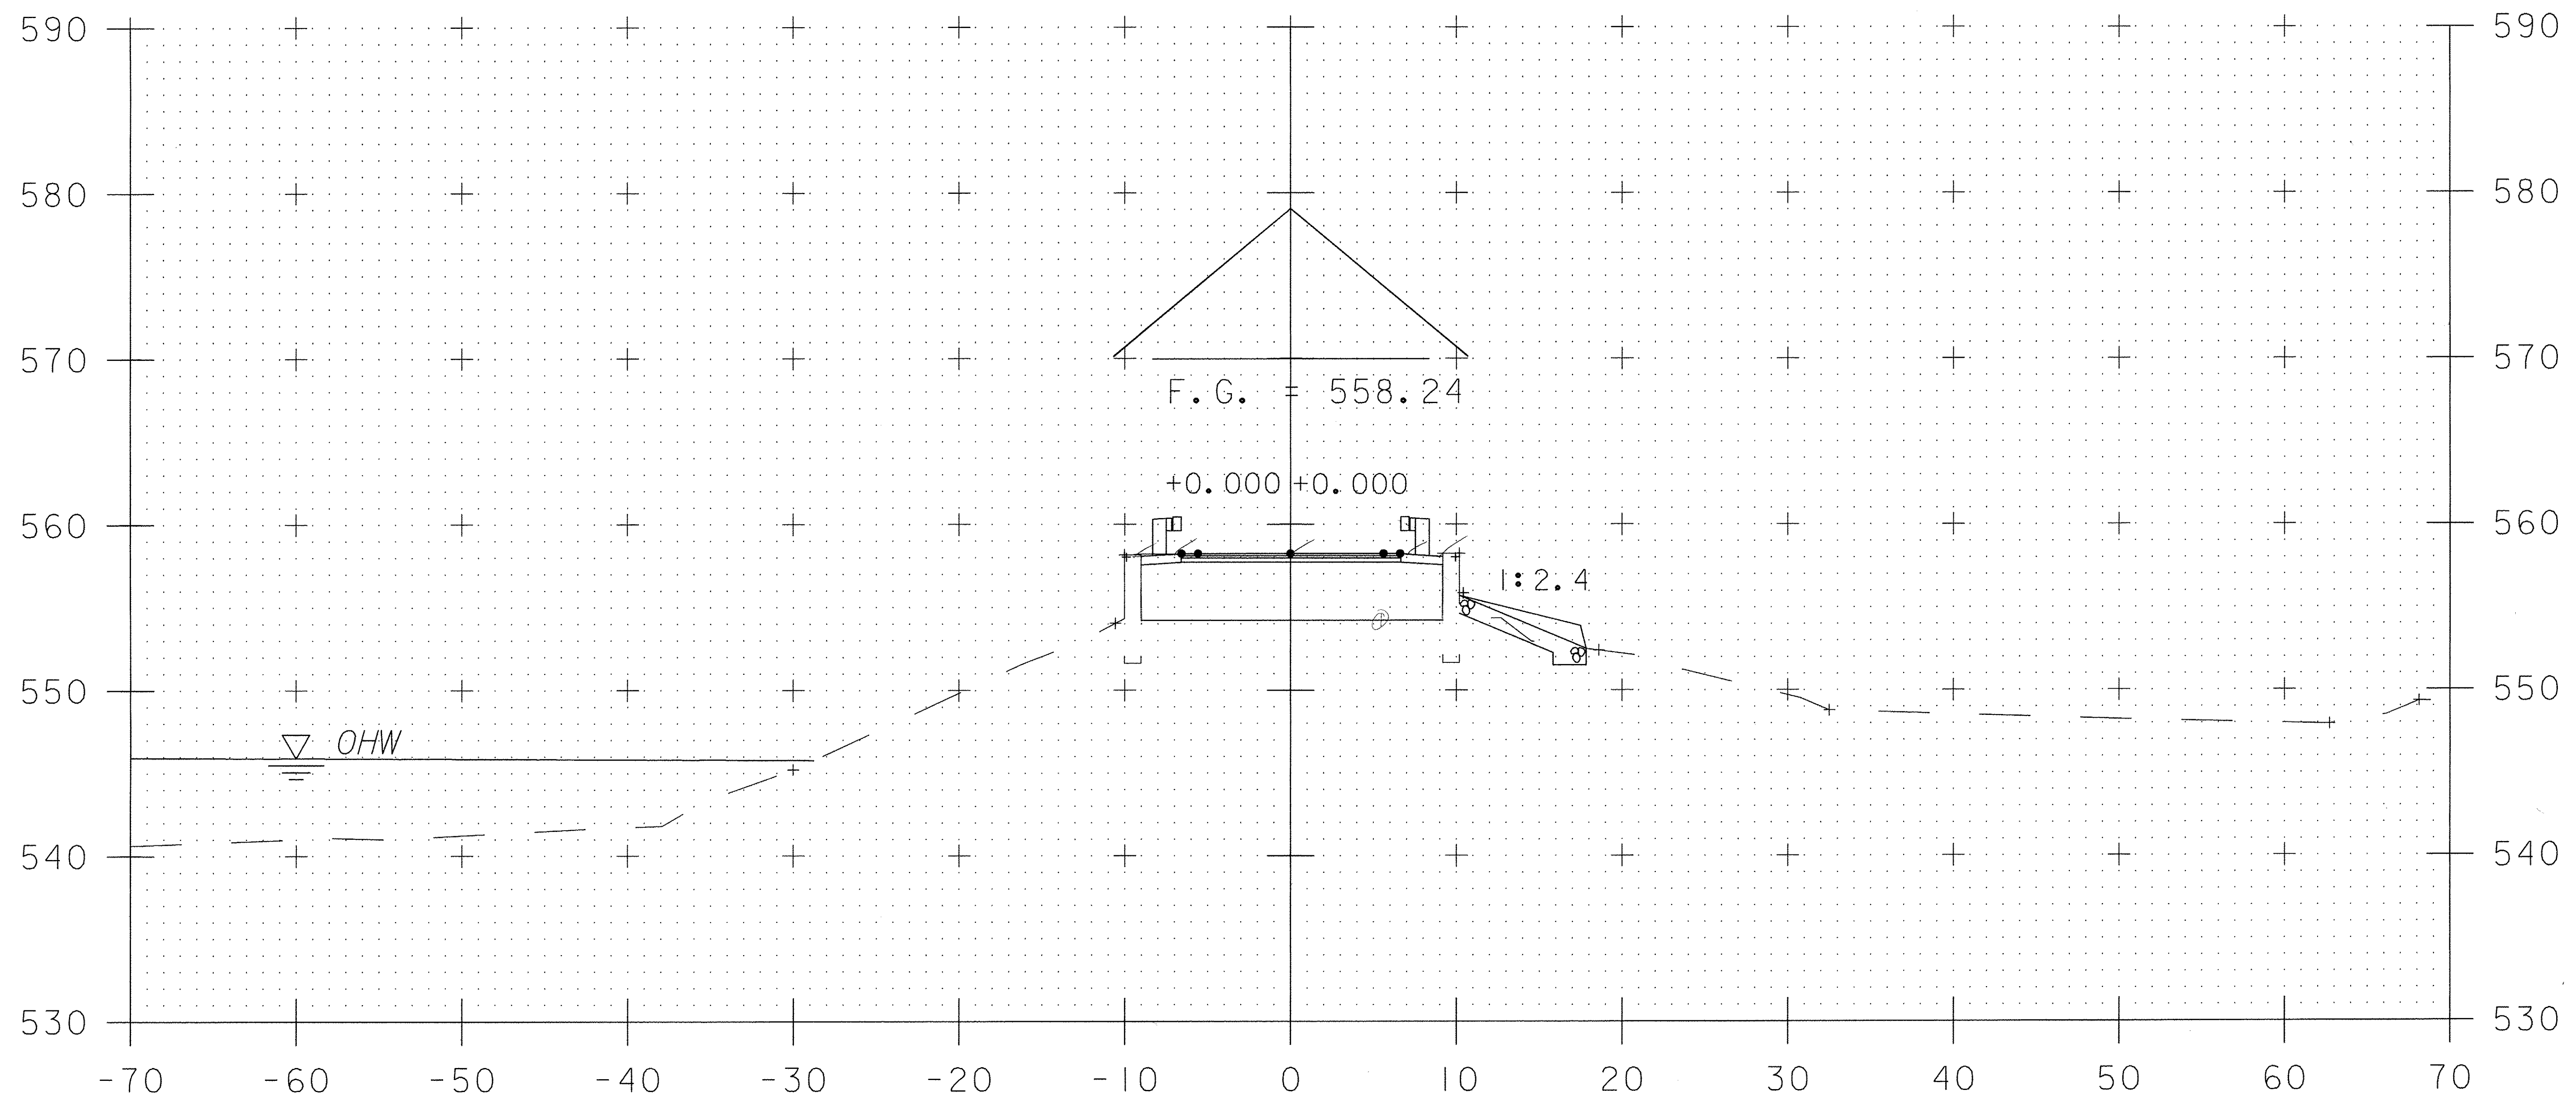

ML 12+42.02  
BEGIN BRIDGE

12+42

720'

PROJECT NAME: NEWANE	
PROJECT NUMBER: BHF 0106 (4)S	
FILE NAME: s96j230conXsect.dgn	PLOT DATE: 14-OCT-2010
PROJECT LEADER: C. CARLSON	DRAWN BY: C. MOONEY
DESIGNED BY: T. LACKEY	CHECKED BY: T. LACKEY
MAINLINE CROSS SECTIONS STA. 12+42	SHEET 14 OF 14