


**FINISH / FINITION: PENTA TREATED after gluing and fabrication**

Pentachlorophenol, Heavy Oil Hydrocarbon Solvent, Type A  
AWPA: Use Category UC4B, Commodity Specification 6F

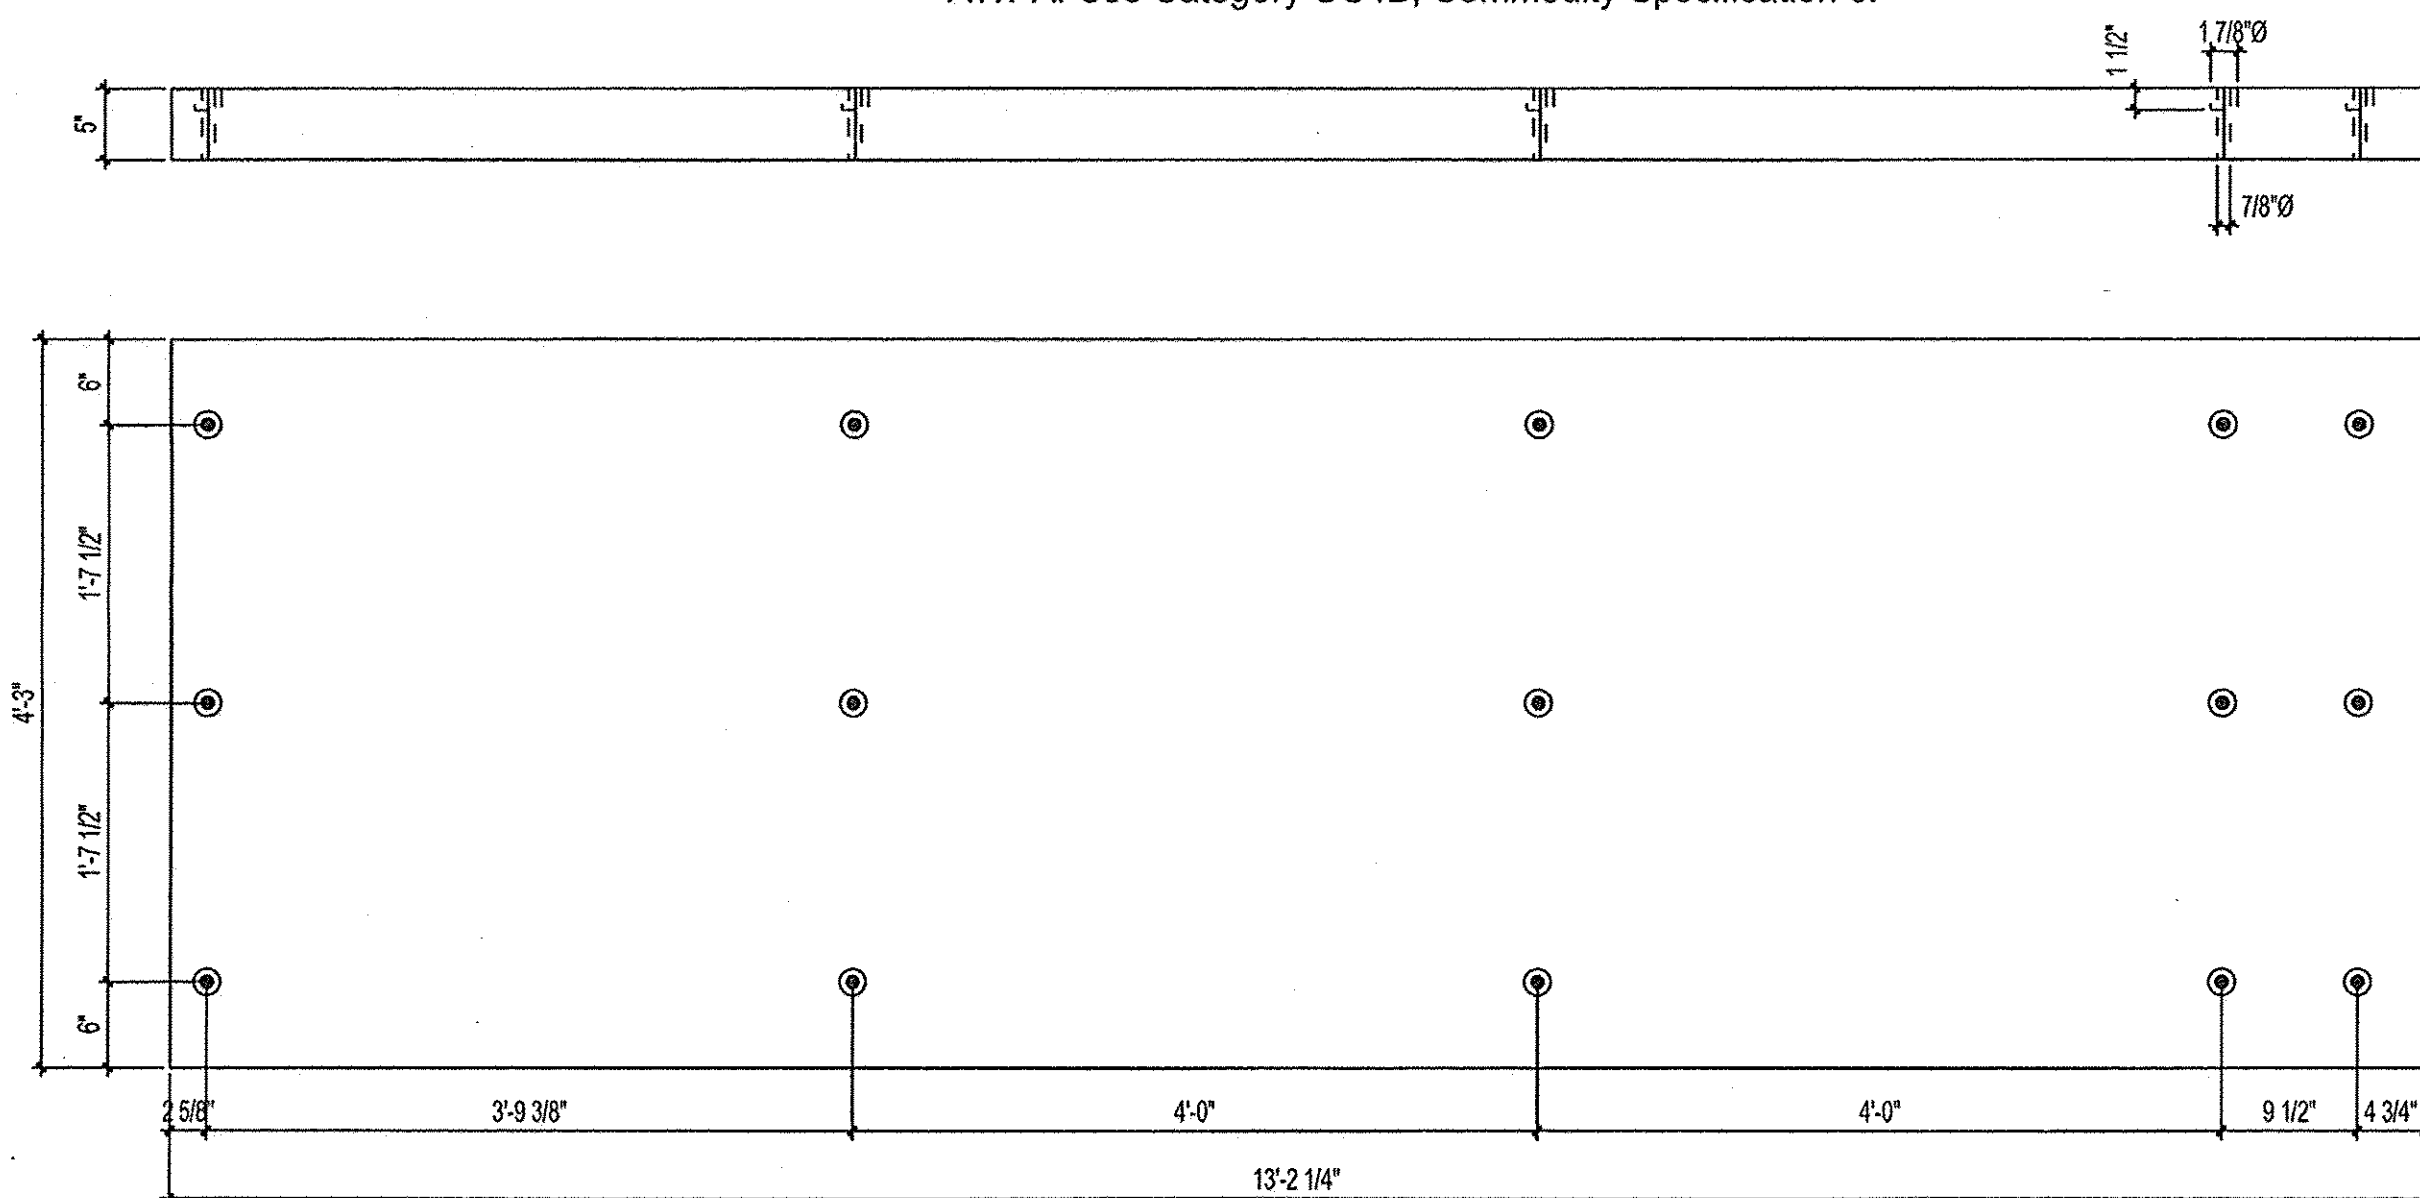

**RECEIVED**  
 OK'D BY: *J.M.* OK'D BY: *J.M.*  
**AUG 17 2009**  
 RESUBMIT: \_\_\_\_\_ APPROVED:   
 BY: *J.M.* DATE: *08/10/09*

ISSUED FOR RE-APPROVAL - AUG 14, 2009  
 ISSUED FOR APPROVAL - JULY 24, 2009

**Prod:# 1**

<b>Deck Panel</b>		Qté/Qty: 2	Echelle/Scale: 1:16	TROU/HOLE 13'16"9 21mmØ S.I.C./U.N.O.	DATE: 24.07.2009	REV.#	DATE: _____	REVISION	PAR BY:
Nom du projet/Project name: NEWFANE BRIDGE		FABRICATION dd/mm/yyyy	Stress Grade: Comb 47	X-section: 5"14'-3"	Dc: R.D.	Goodfellow inc,			
Numero du projet/Project number: 2009-176-U / G-44764			App. Grade: Industrial	Longueur/Lenght: 13'-2 1/4"	Check: J.M.	225, Goodfellow Street DELSON, QUEBEC, J5B 1V5 Tel: 450-635-8511 Fax: 450-635-8304 www.goodfellowinc.com			
Nom du client/Customer name:			Materiel/Material: Glulam - Southern Pine						