


FINISH / FINITION: PENTA TREATED after gluing and fabrication

Pentachlorophenol, Heavy Oil Hydrocarbon Solvent, Type A
 AWWPA: Use Category UC4B, Commodity Specification 6F

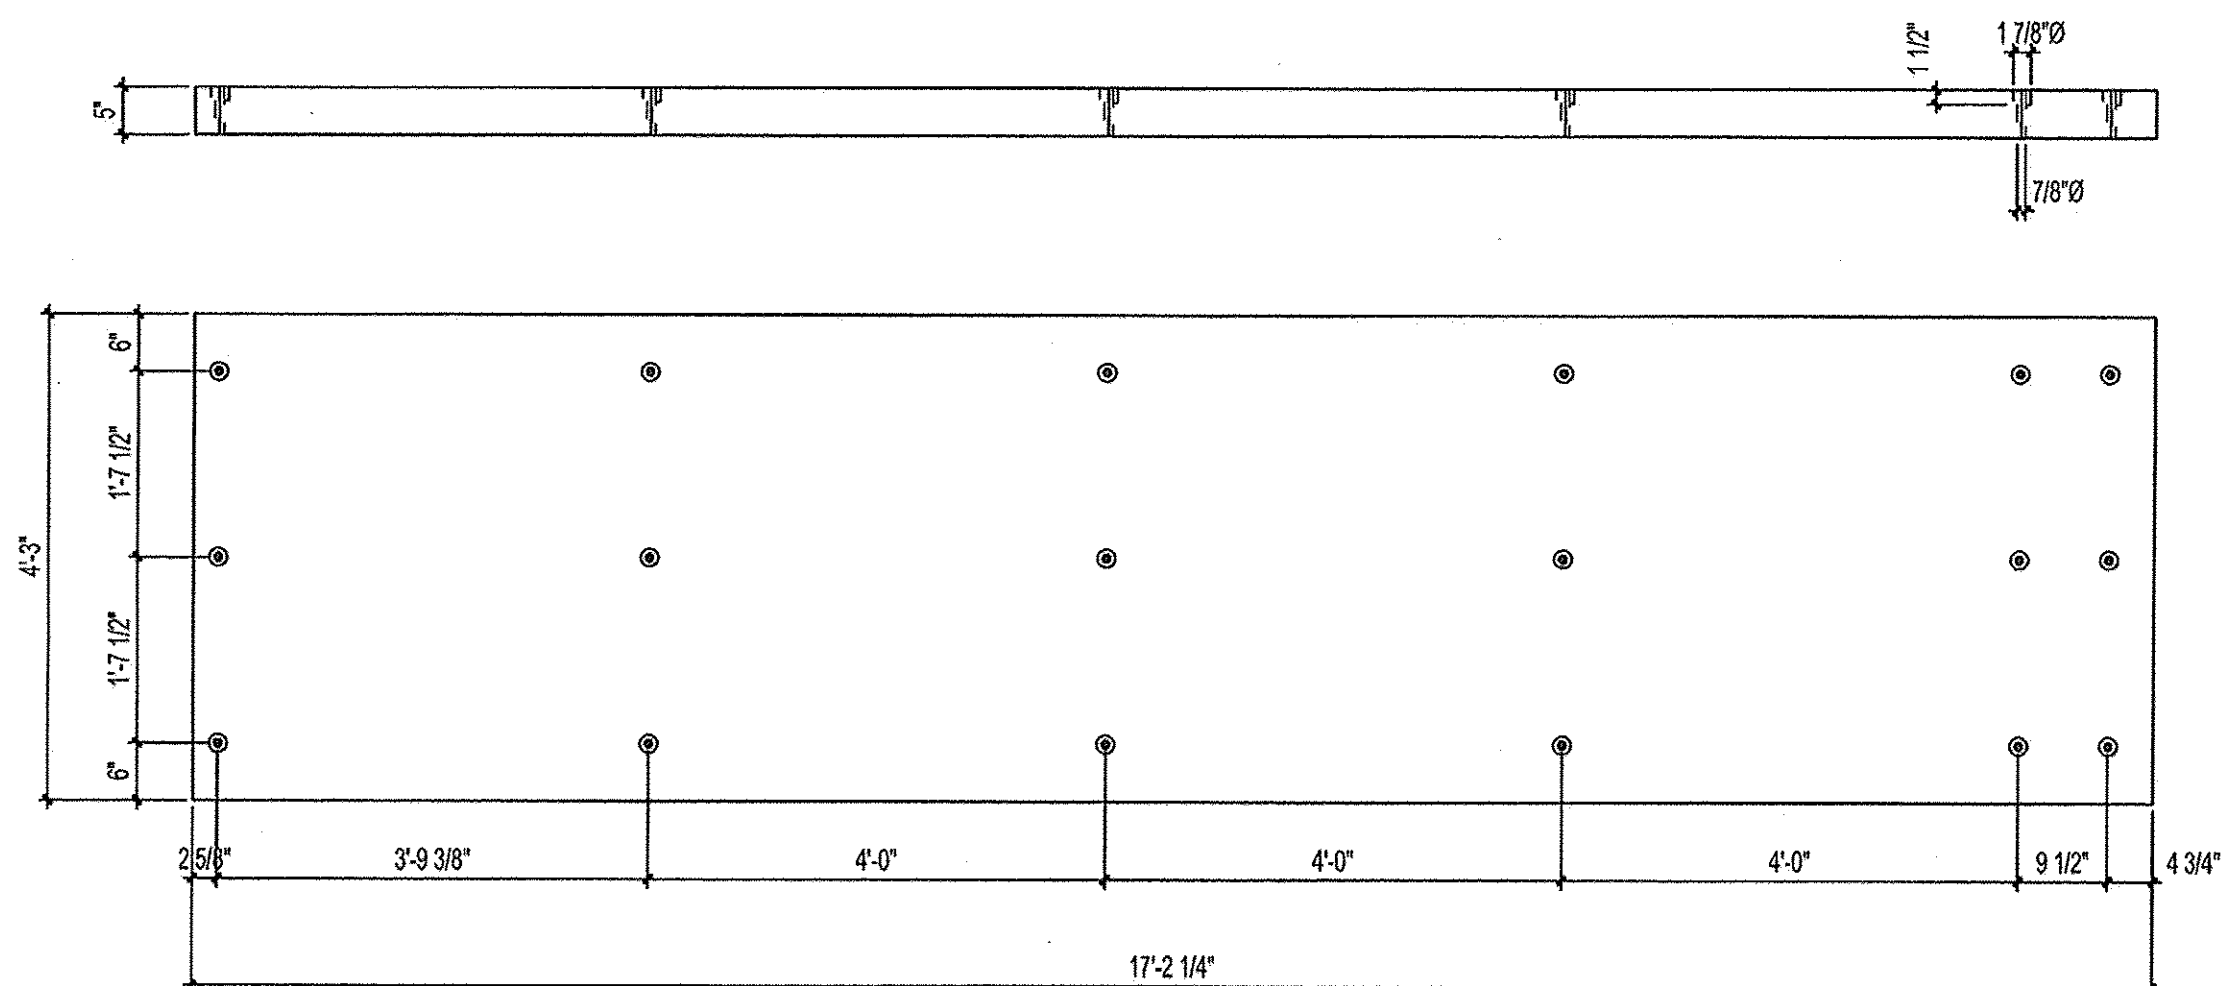

RECEIVED
 OK'D BY: [Signature] OK'D BY: [Signature]
 AUG 17 2009
 BY: [Signature] DATE: 08/10/09

ISSUED FOR RE-APPROVAL - AUG 14, 2009
 ISSUED FOR APPROVAL - JULY 24, 2009

Prod:# 2

| | | | | | | |
|---|-------------|------------------------|---|--|--------------------------------------|-----------------------|
| Deck Panel | | Qté/Qty: 2 | Echelle/Scale: 1:24 | TRON/HOLE 13/16"Ø 21mmØ S.I.C./U.N.O. | DATE: 24.07.2009 | Goodfellow inc, |
| Nom du projet/Project name: NEWFANE BRIDGE | FABRICATION | Stress Grade: Comb 47 | X-section: 5"14'-3" | By: R.D. | 225, Goodfellow Street | |
| Numero du projet/Project number: 2009-176-U / G-44764 | dd/mm/yyyy | App. Grade: Industrial | Longueur/Length: 17'-2 1/4" | Checked: J.M. | DELSON, QUEBEC, J5B 1V5 | |
| Nom du client/Customer name: | | | Material/Material: Glulam - Southern Pine | By: [Signature] | Tel.: 450-635-6511 Fax: 450-635-8304 | www.goodfellowinc.com |