


FINISH / FINITION: PENTA TREATED after gluing and fabrication

Pentachlorophenol, Heavy Oil Hydrocarbon Solvent, Type A
AWPA: Use Category UC4B, Commodity Specification 6F

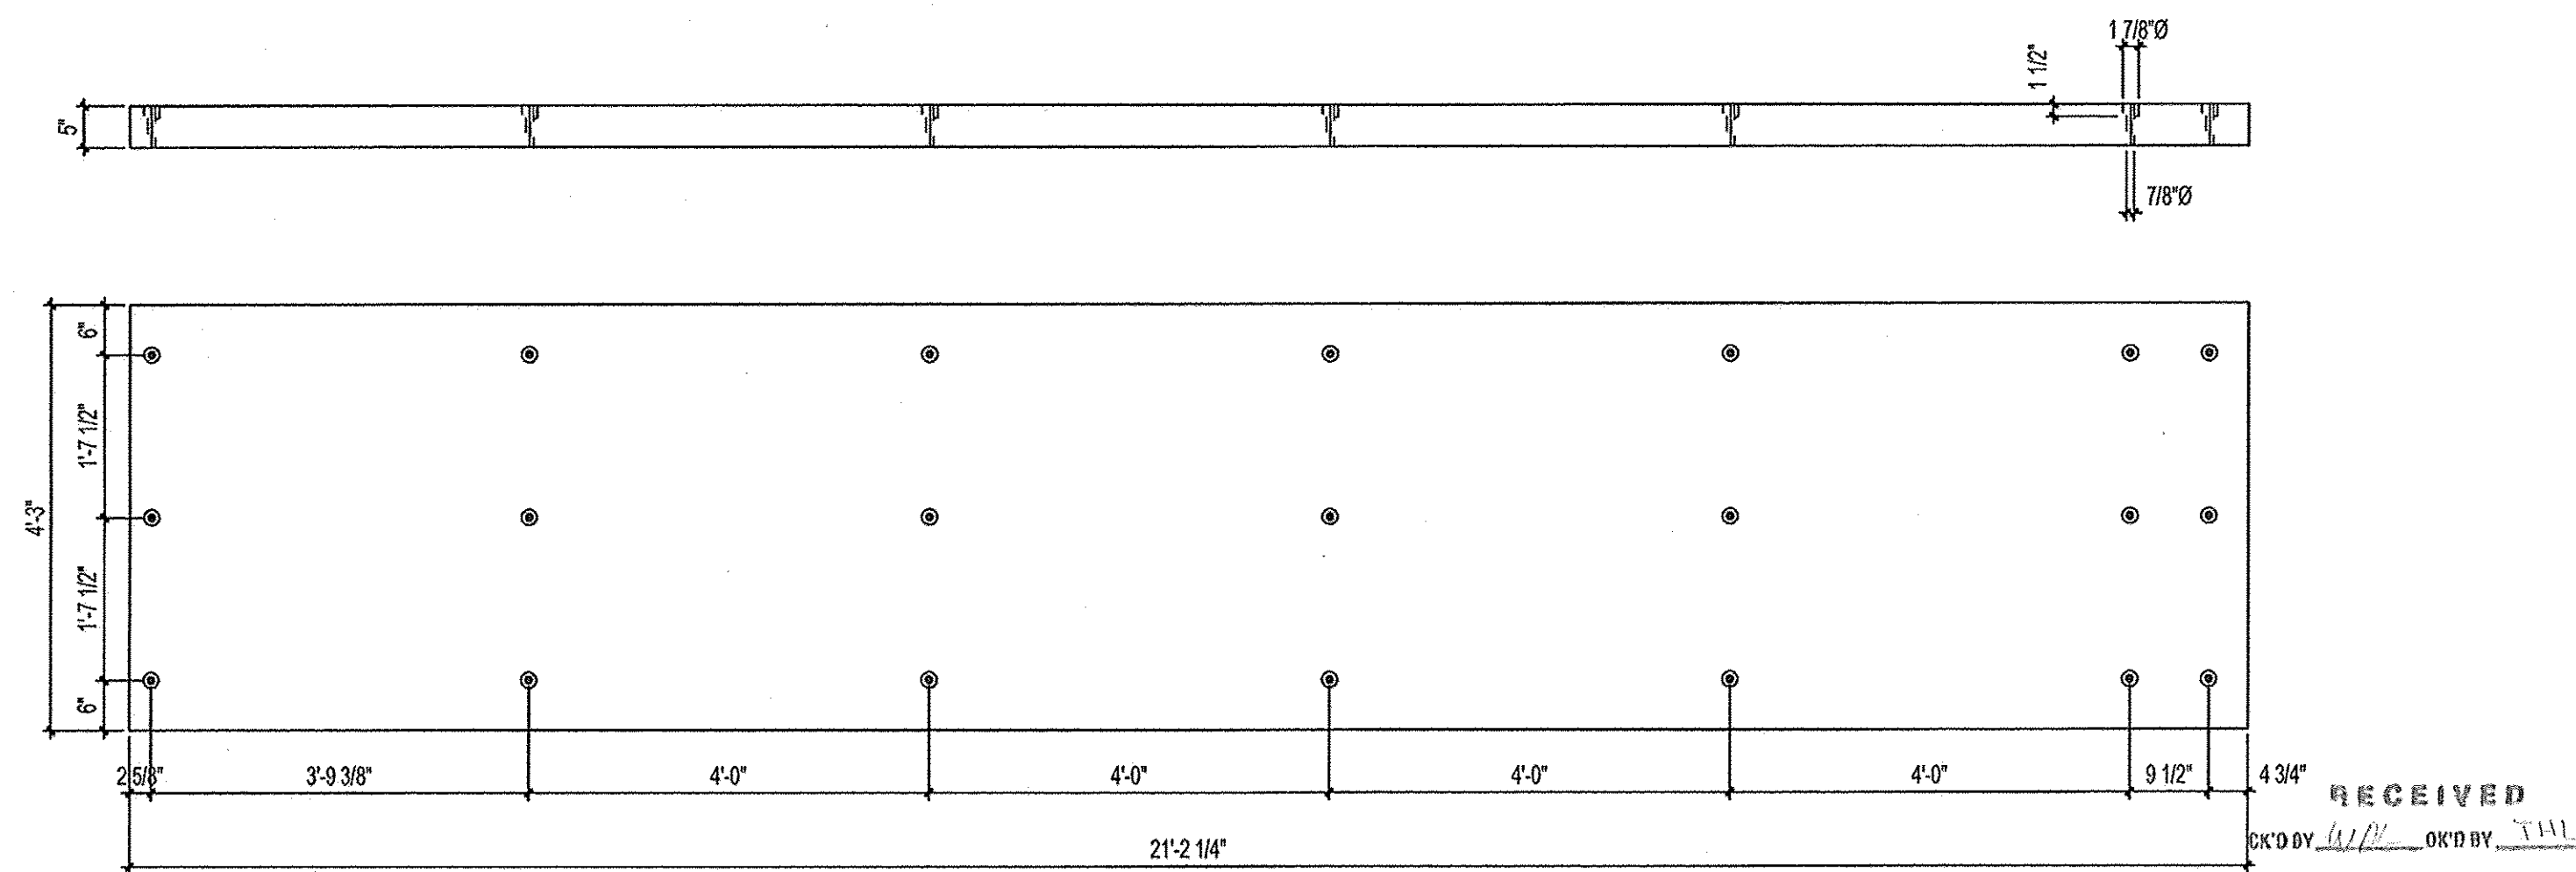

RECEIVED

AUG 17 2009

ISSUED FOR RE-APPROVAL - AUG 14, 2009
ISSUED FOR APPROVAL - JULY 24, 2009

Prod:# 3

Deck Panel		Qté/Qty: 2	Echelle/Scale: 1:24	DATE: 24.07.2009	Goodfellow inc,
Nom du projet/Project name: NEWFANE BRIDGE	FABRICATION	Stress Grade: Comb 47	X-section: 5"14'-3"	By: R.D.	225, Goodfellow Street
Numero du projet/Project number: 2009-176-U / G-44764	dd/mm/yyyy	App. Grade: Industrial	Longueur/Length: 21'-2 1/4"	Check: J.M.	DELSON, QUEBEC, J6B 1V5
Nom du client/Customer name:		Materiel/Material: Glulam - Southern Pine			Tel.: 450-635-8511 Fax: 450-635-8304