


FINISH / FINITION: PENTA TREATED after gluing and fabrication

Pentachlorophenol, Heavy Oil Hydrocarbon Solvent, Type A
 AWWPA: Use Category UC4B, Commodity Specification 6F

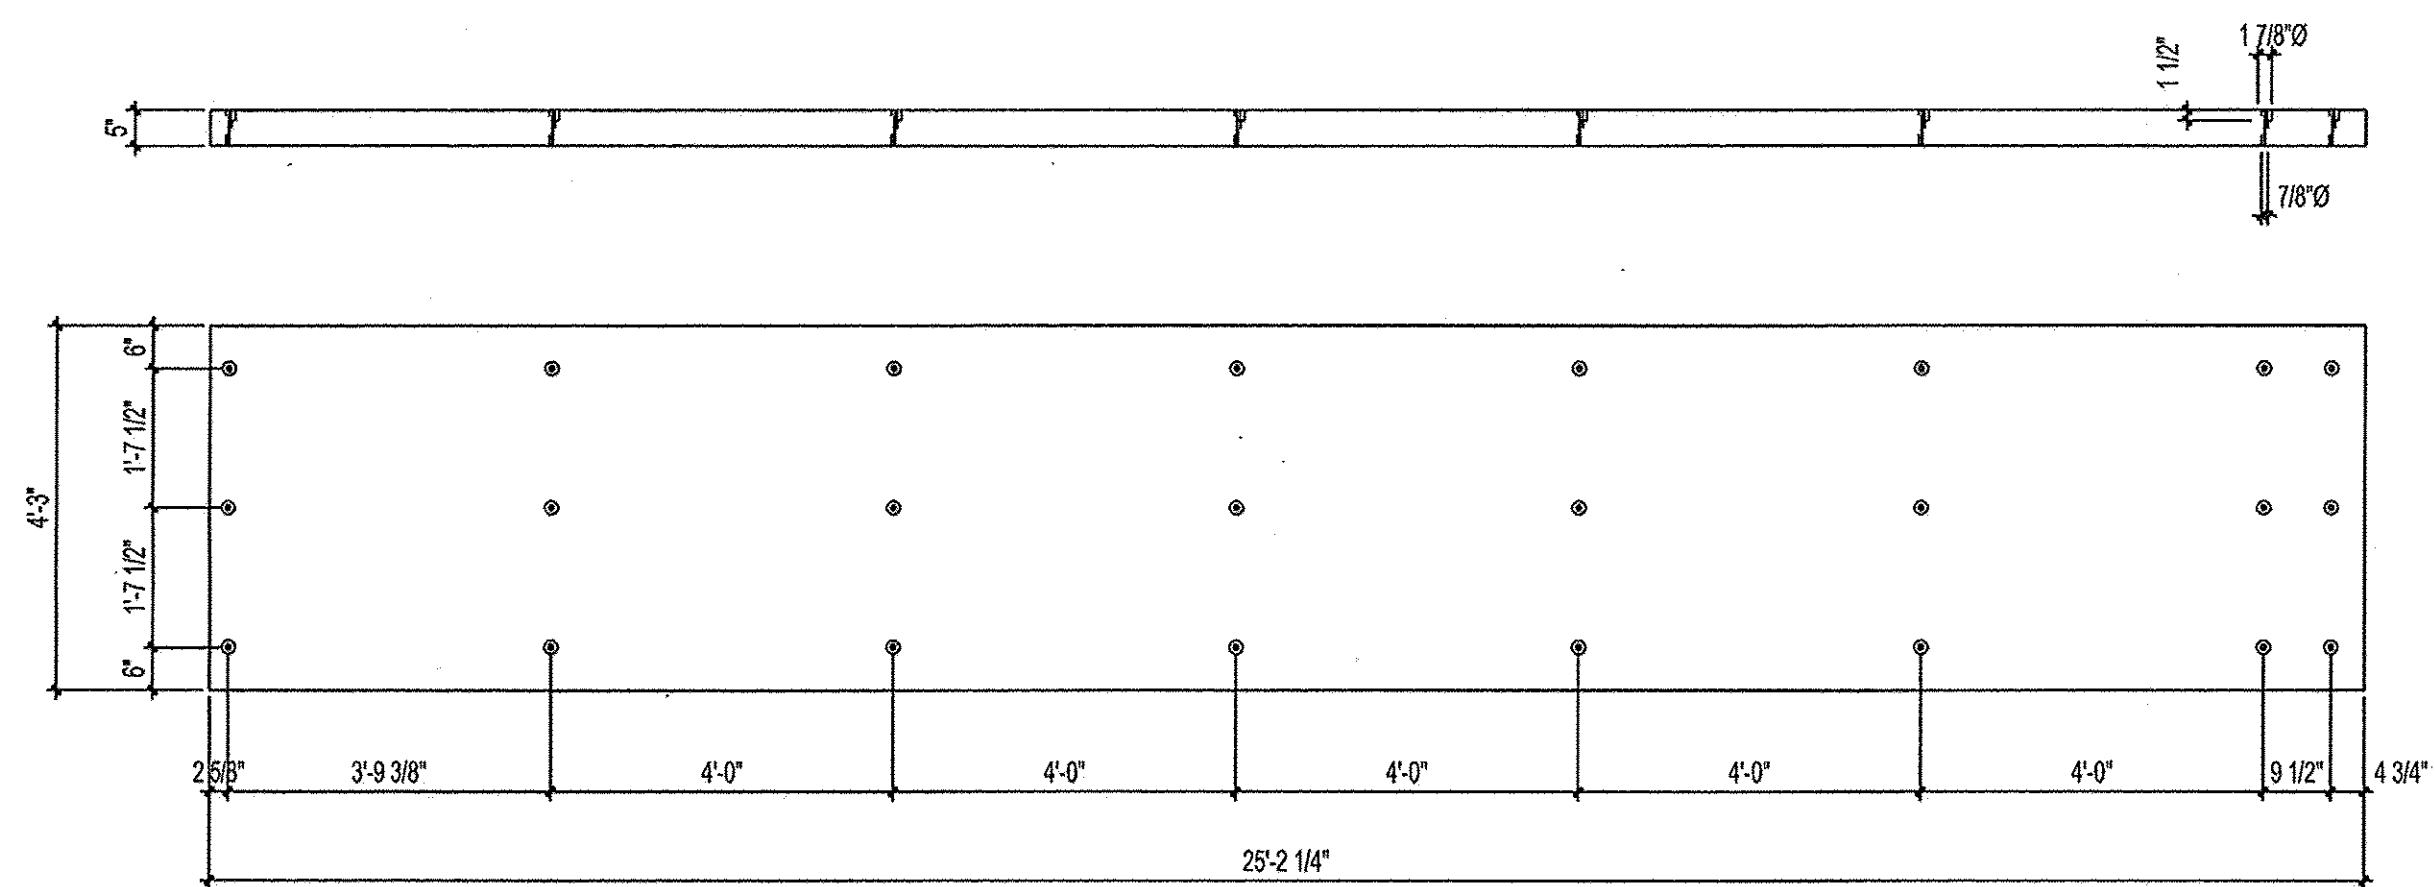

RECEIVED
 CKD BY: *[Signature]* OKD BY: *[Signature]*
 AUG 17 2009
 RE/SUE/HT: _____ APPROVED:
 BY: *[Signature]* DATE: *08/17/09*

ISSUED FOR RE-APPROVAL - AUG 14, 2009
 ISSUED FOR APPROVAL - JULY 24, 2009

Prod:# 4

Deck Panel		Qté/Qty: 2	Echelle/Scale: 1:32	DATE: 24.07.2009	Goodfellow inc,
Nom du projet/Project name: NEWFANE BRIDGE	FABRICATION	Stress Grade: Comb 47	X-section: 5"1/4"-3"	By: R.D.	225, Goodfellow Street
Numero du projet/Project number: 2009-176-U / G-44764	dd/mm/yyyy	App. Grade: Industrial	Longueur/Length: 28'-2 1/4"	Checked: J.M.	DELSON, QUEBEC, J5B 1V5
Nom du client/Customer name:			Materiel/Material: Glulam - Southern Pine	Office:	Tel.: 450-635-8511 Fax: 450-635-8304
					www.goodfellowinc.com

(UNPRIMER/PRINTED: 0.1483.0008)

TROU/HOLE	DATE	REVISION	PAR BY:
19/18"Ø			
21mmØ			
S.L.C./U.N.O.			