


FINISH / FINITION: PENTA TREATED after gluing and fabrication

Pentachlorophenol, Heavy Oil Hydrocarbon Solvent, Type A
AWPA: Use Category UC4B, Commodity Specification 6F

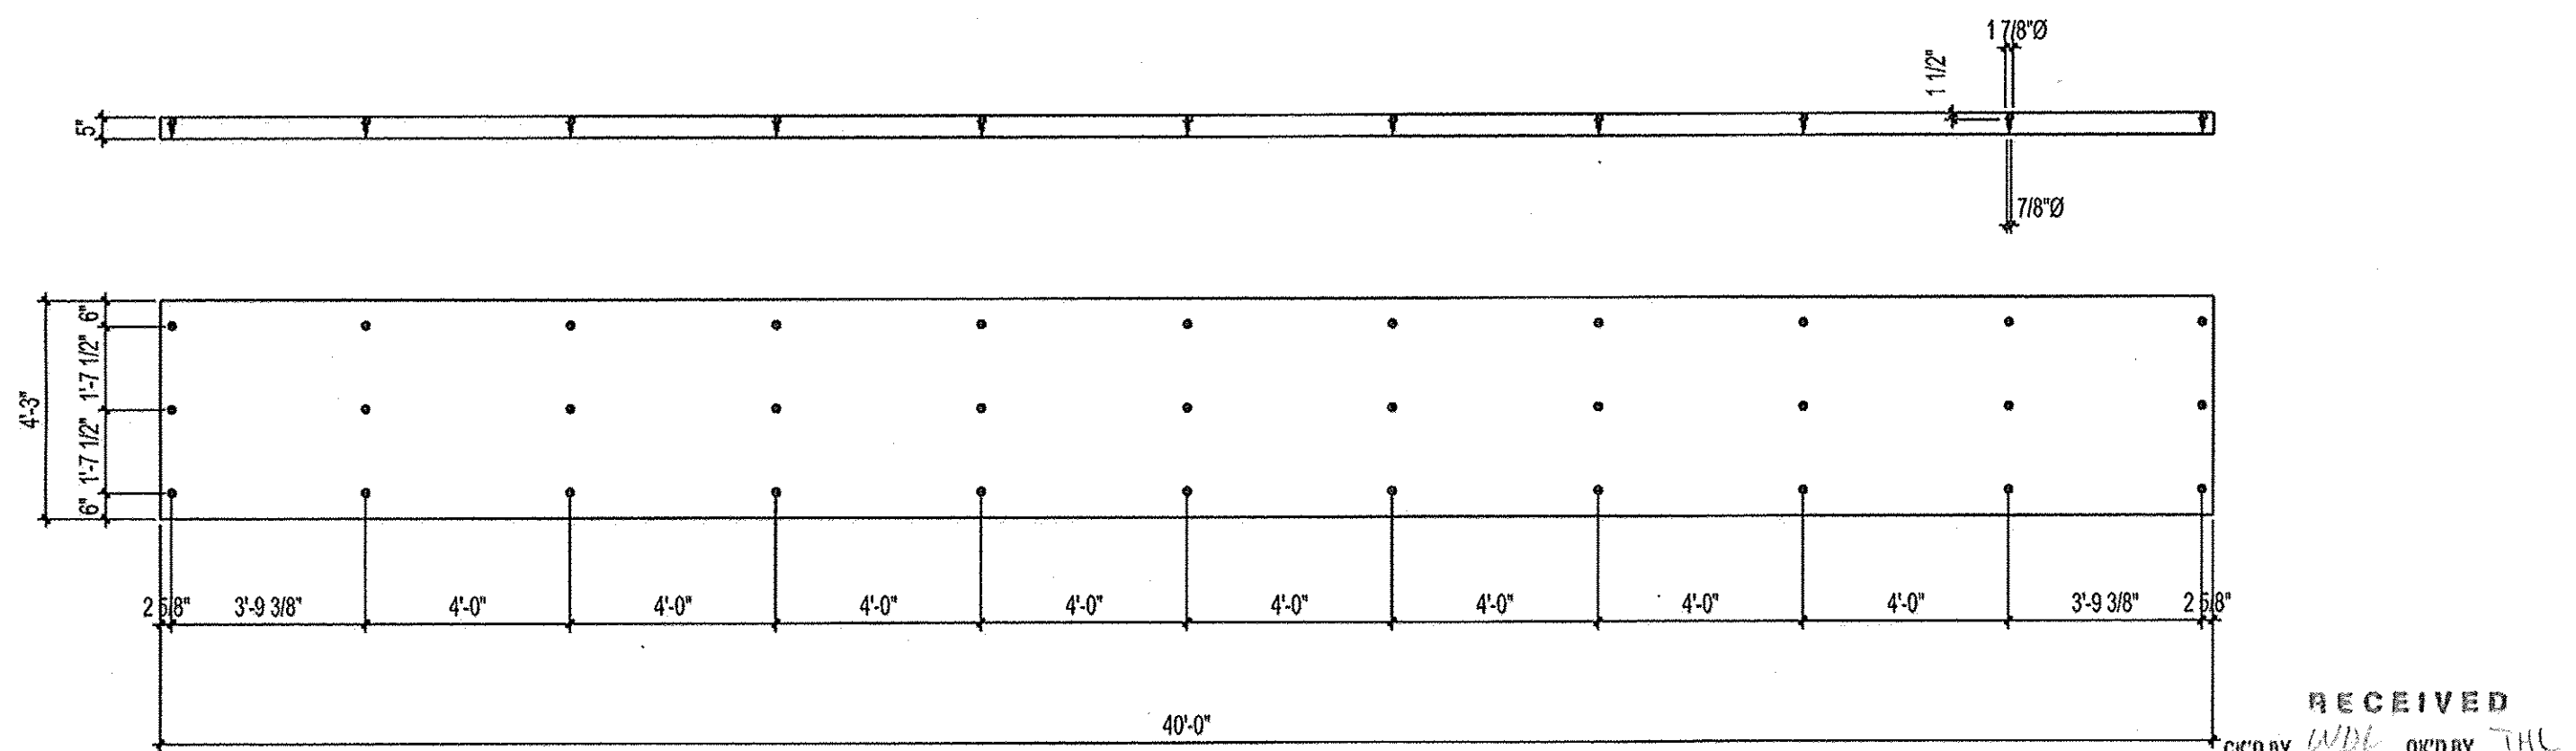

RECEIVED
 OK'D BY: *WDL* OK'D BY: *JHL*
 AUG 17 2009
 REQUESTED APPROVED ✓
 BY: *JHL* DATE: *08/17/09*

ISSUED FOR RE-APPROVAL - AUG 14, 2009
 ISSUED FOR APPROVAL - JULY 24, 2009

Prod:# 5

Deck Panel		Qté/Qty: 8	Echelle/Scale: 1:48	DATE: 24.07.2009	Goodfellow inc,
Nom du projet/Project name: NEWFANE BRIDGE	FABRICATION	Stress Grade: Comb 47	X-section: 5"4'-3"	By: R.D.	225, Goodfellow Street
Numero du projet/Project number: 2009-176-U / G-44764	dd/mm/yyyy	App. Grade: Industrial	Longueur/Length: 40'-0"	Grade: J.M.	DELSON, QUEBEC, J6B 1V5
Nom du client/Customer name:		Materiel/Material: Glulam - Southern Pine		Grade:	Tel.: 450-835-8911 Fax: 450-835-8304

IMPROBET/PRINTED: 0 14.08.2009