
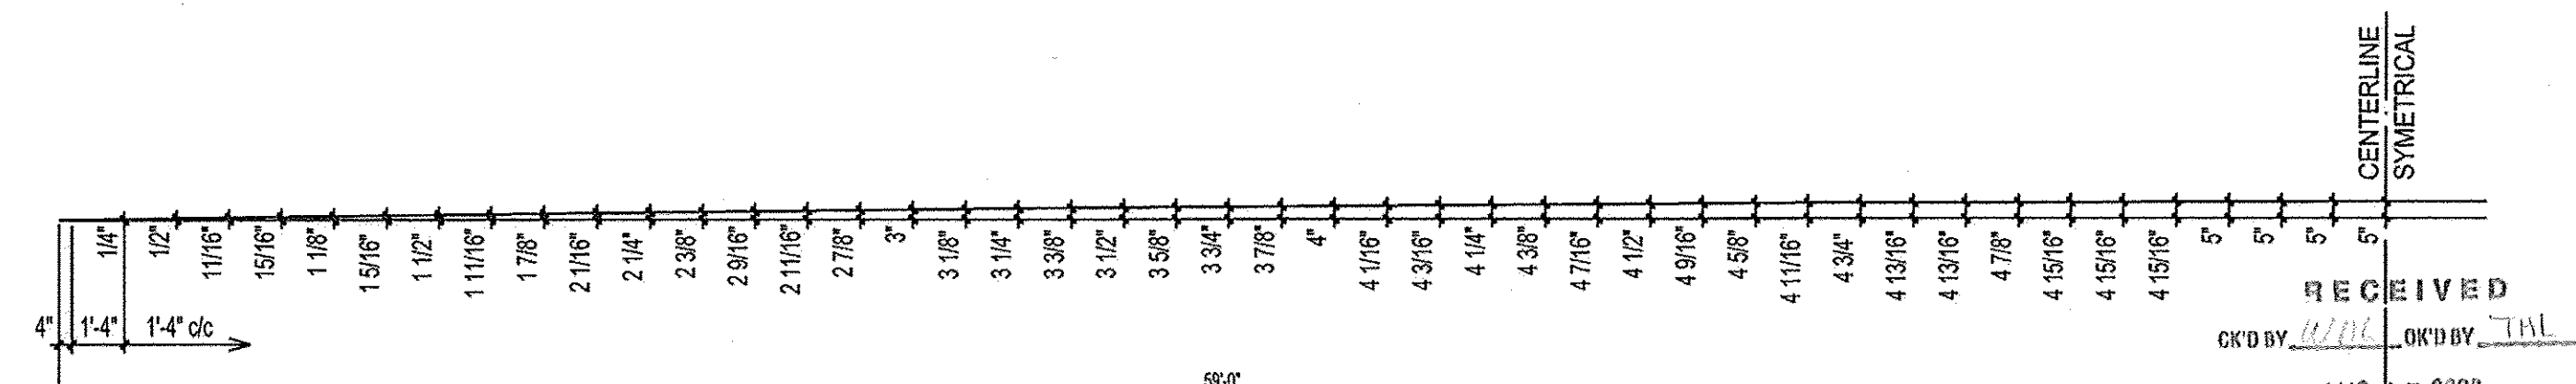


**FINISH / FINITION: PENTA TREATED after gluing and fabrication**

Pentachlorophenol, Heavy Oil Hydrocarbon Solvent, Type A  
AWPA: Use Category UC4B, Commodity Specification 6F

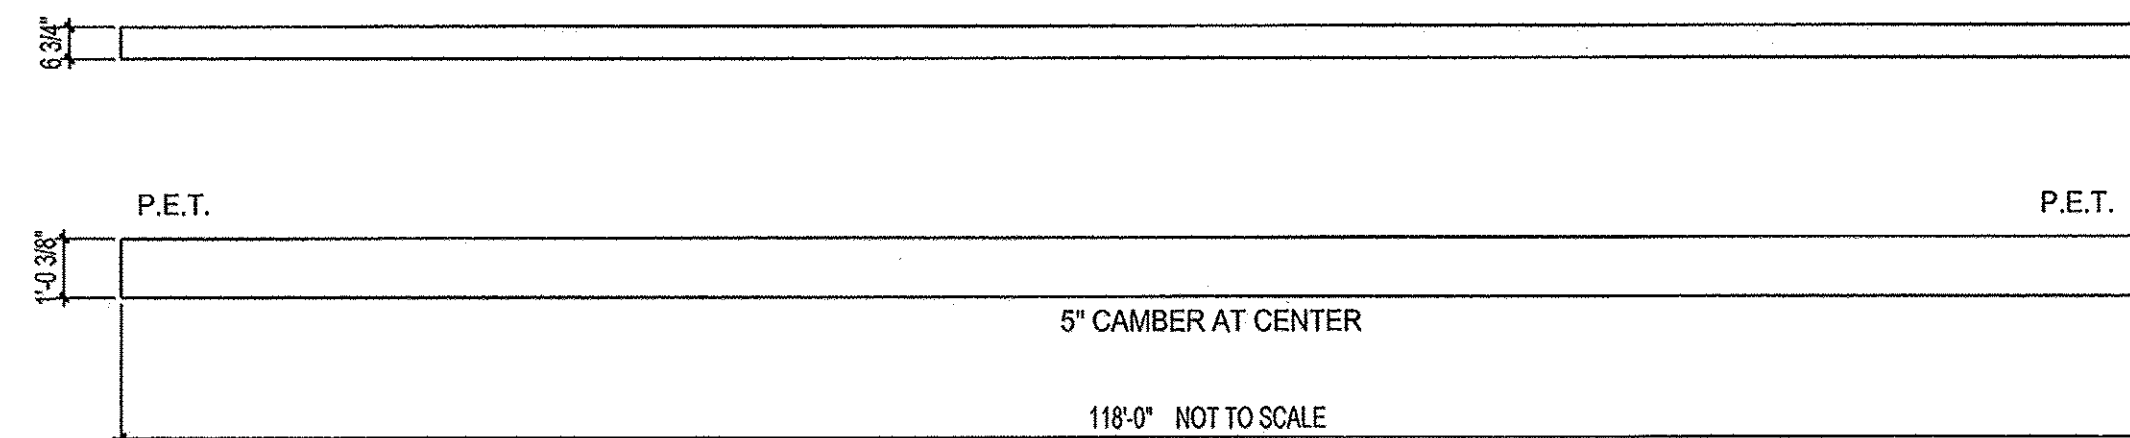

JIG SETUP FOR 5" CAMBER  
HALF SPAN SHOWN - SYM @ CL

ISSUED FOR RE-APPROVAL - AUG 14, 2009  
ISSUED FOR APPROVAL - JULY 24, 2009

RECEIVED  
AUG 7 2009  
BY TUL DATE 08/20/09

**Prod:# 6**

<b>Lower Bottom Chord</b>		Qté/Qty: 4	Echelle/Scale: 1:48	Goodfellow inc,	
Nom du projet/Project name: NEWFANE BRIDGE	FABRICATION	Stress Grade: 16F-V2	X-section: 6 3/4"X1'-0 3/8"	DATE: 24.07.2009	By: R.D.
Numero du projet/Project number: 2009-176-U / G-44764	dd/mm/yyyy	App. Grade: Industrial	Longueur/Length: 118'-0"	Checked: J.M.	225, Goodfellow Street
Nom du client/Customer name:		Materiel/Material: Glulam - Southern Pine			DELSON, QUEBEC, J8B 1V5
					Tel: 450-635-6911 Fax: 450-635-6304
					www.goodfellowinc.com