


FINISH / FINITION: PENTA TREATED after gluing and fabrication

Pentachlorophenol, Heavy Oil Hydrocarbon Solvent, Type A
AWPA: Use Category UC4B, Commodity Specification 6F

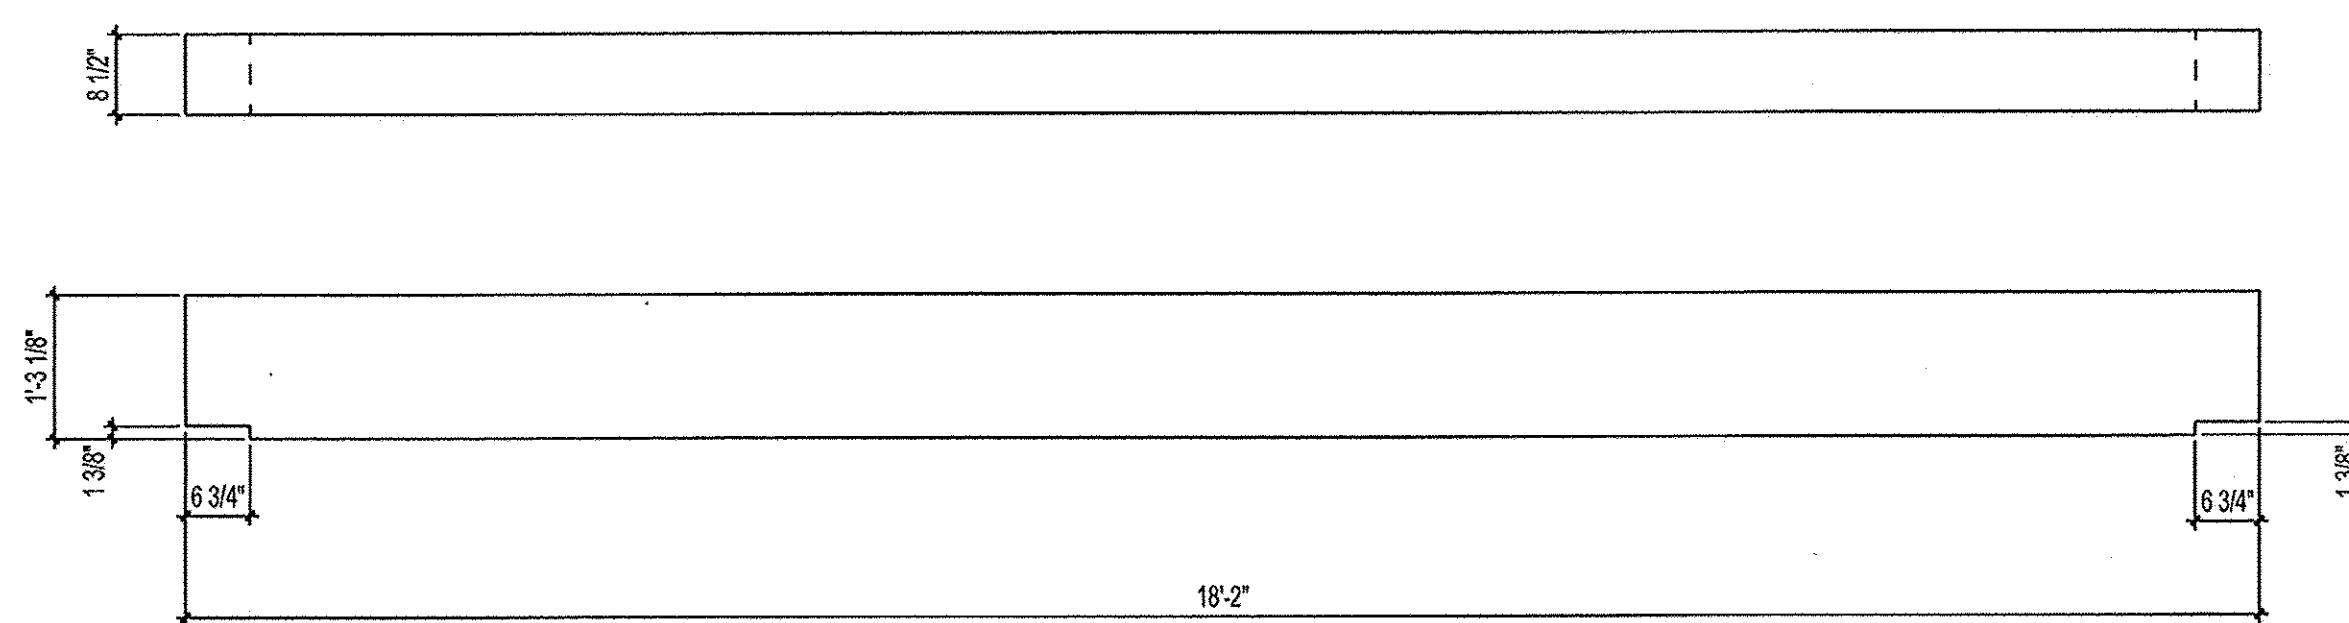

RECEIVED
 OK'D BY: J.H.L.
 AUG 17 2009
 APPROVED:
 BY: J.H.L. DATE: 08/10/09

ISSUED FOR RE-APPROVAL - AUG 14, 2009
 ISSUED FOR APPROVAL - JULY 24, 2009

Prod:# 7

End Floor Beam		Qté/Qty: 2	Echelle/Scale: 1:24	DATE: 24.07.2009	Goodfellow inc,
Nom du projet/Project name: NEWFANE BRIDGE	FABRICATION	Stress Grade: 26F-V2	X-section: 8 1/2" x 1'-3 1/8"	By: R.D.	225, Goodfellow Street
Numero du projet/Project number: 2009-176-U / G-44764	dd/mm/yyyy	App. Grade: Industrial	Longueur/Length: 18'-2"	Checké: J.M.	DELSON, QUEBEC, J5B 1V5
Nom du client/Customer name:			Materiel/Material: Glulam - Southern Pine		Tel.: 450-635-6511 Fax: 450-635-8304
					www.goodfellowinc.com

MPRIMER / PRINTED: 0 14.08.2009

TROU/HOLE	REV.#	DATE:	REVISION	PAR BY:
13/10/09				
21mmØ				
S.I.C./U.N.O.				