


FINISH / FINITION: PENTA TREATED after gluing and fabrication

Pentachlorophenol, Heavy Oil Hydrocarbon Solvent, Type A
AWPA: Use Category UC4B, Commodity Specification 6F

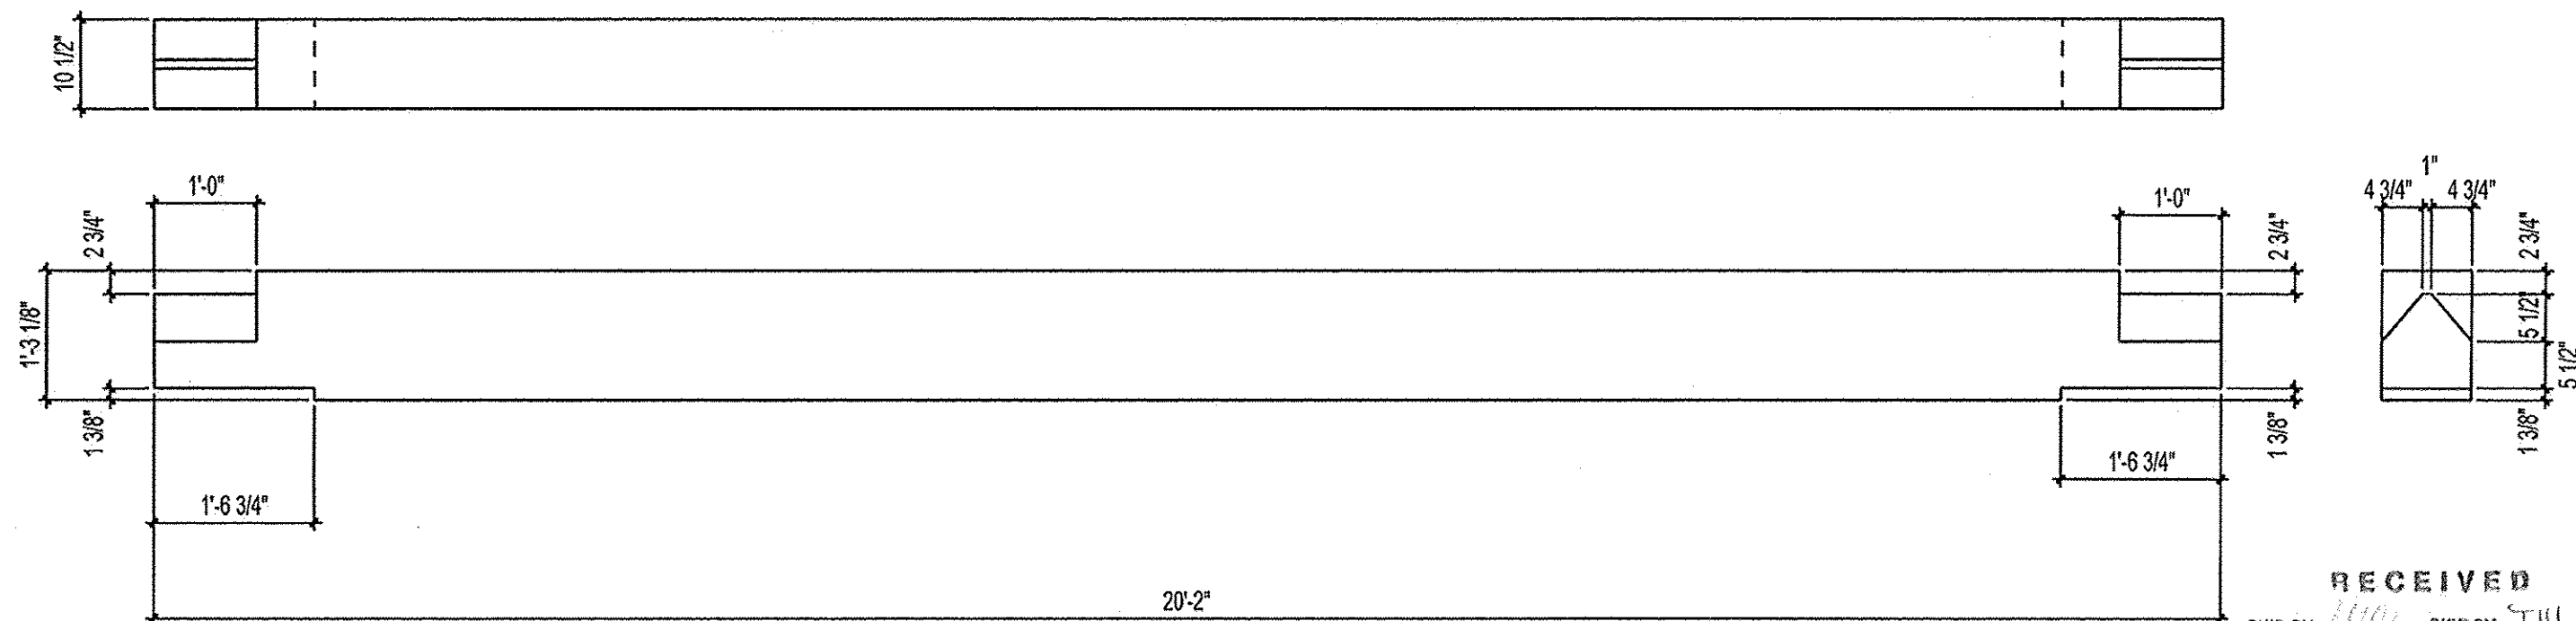

RECEIVED
OK'D BY: [Signature] OK'D BY: [Signature]
AUG 17 2009
REQUESTED BY: [Signature] APPROVED: [Signature]
DATE: 08/17/09

ISSUED FOR RE-APPROVAL - AUG 14, 2009
ISSUED FOR APPROVAL - JULY 24, 2009

Prod:# 8

Floor Beam		Qté/Qty: 30	Echelle/Scale: 1:24	DATE: 24.07.2009	Goodfellow inc,
Nom du projet/Project name: NEWFANE BRIDGE	FABRICATION	Stress Grade: 26F-V2	X-section: 10 1/2" H x 3 1/8"	By: R.D.	225, Goodfellow Street
Numero du projet/Project number: 2009-176-U / G-44764	dd/mm/yyyy	App. Grade: Industrial	Longueur/Length: 20'-2"	Checked: J.M.	DELSON, QUEBEC, J5B 1V5
Nom du client/Customer name:			Material/Material: Glulam - Southern Pine	Checked:	Tel: 450-635-8511 Fax: 450-635-8304
					www.goodfellowinc.com