


FINISH / FINITION: PENTA TREATED after gluing and fabrication

Pentachlorophenol, Heavy Oil Hydrocarbon Solvent, Type A
 AWPA: Use Category UC4B, Commodity Specification 6F

118'-4 1/2" = OVERALL DECK PANEL LENGTH

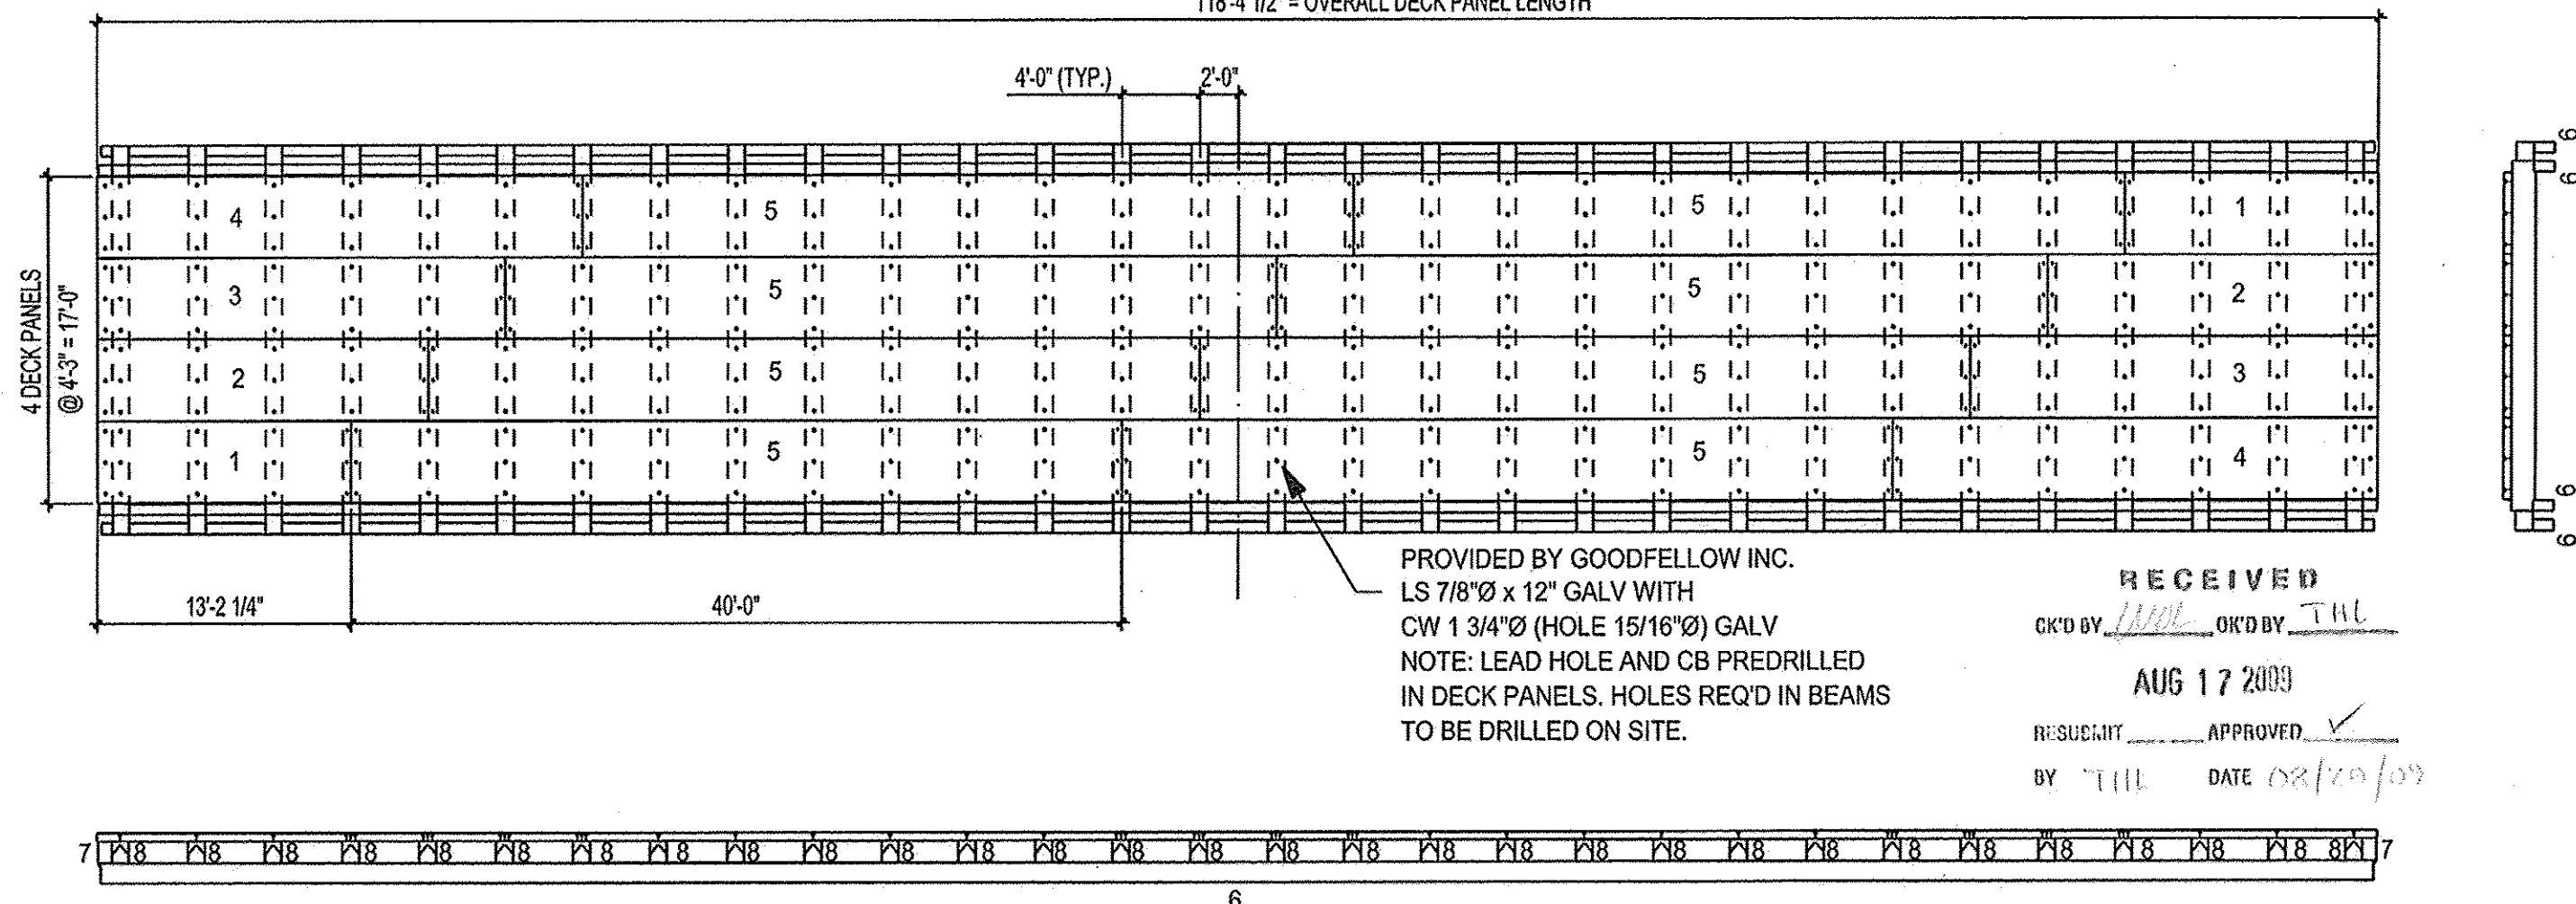

ISSUED FOR RE-APPROVAL - AUG 14, 2009
 ISSUED FOR APPROVAL - JULY 24, 2009

(IMPRIMER/PRINTED: 0 MO8.2009)

TROUGH/HOLE	13/16"Ø	21mmØ	S.I.C./U.N.O.
REV.#	DATE	REVISION	PAR BY

Framing Plan		Qté/Qty: 1 BRIDGE	Echelle/Scale: 1:128	Goodfellow inc,	
Nom du projet/Project name: NEWFANE BRIDGE	FABRICATION	Stress Grade: see shop dwgs	X-section: see shop dwgs	By: R.D.	225, Goodfellow Street
Numero du projet/Project number: 2009-176-U / G-44764	dd/mm/yyyy	App. Grado: Industrial	Longueur/Length: see shop dwgs	Dr: J.M.	DELSON, QUEBEC, J8B 1V5
Nom du client/Customer name:		Materiel/Material: Glulam - Southern Pine			Tel.: 450-635-6511 Fax: 450-635-8304
					www.goodfellowinc.com