


FINISH / FINITION: PENTA TREATED after gluing and fabrication

Pentachlorophenol, Heavy Oil Hydrocarbon Solvent, Type A
 AWWA: Use Category UC4B, Commodity Specification 6F

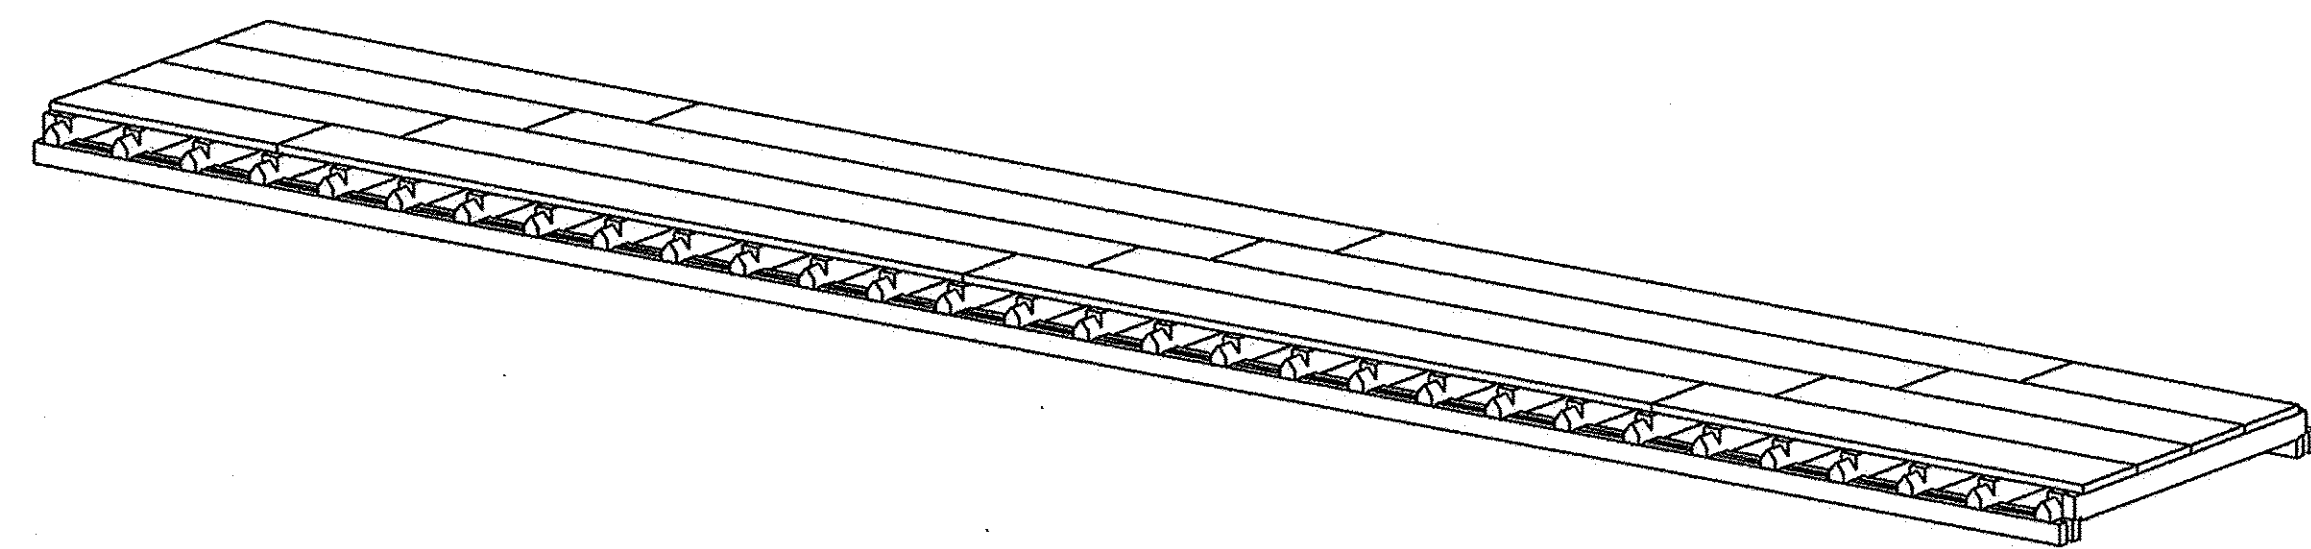

RECEIVED
 CR'D BY: THU ON'D BY: THU
 AUG 17 2009
 RESUBMIT: _____ APPROVED:
 BY: THU DATE: 08/20/09

ISSUED FOR RE-APPROVAL - AUG 14, 2009
 ISSUED FOR APPROVAL - JULY 24, 2009

(IMPROVED / PRINTED: 0 14.08.2009)

TROU/HOLE	DATE	REVISION	PAR BY
13/16" Ø	24.07.2009		
21mm Ø			
S.I.C./I.N.O.	REV.#	DATE	REVISION

Isometric

Qté/Qty: 1 BRIDGE Echelle/Scale: 1:128

Nom du projet/Project name: NEWFAME BRIDGE
 Numero du projet/Project number: 2009-176-U / G-44764
 Nom du client/Customer name:

FABRICATION
 dd/mm/yyyy

Stress Grade: see shop dwgs X-section: see shop dwgs
 App. Grade: Industrial Longueur/Lenght: see shop dwgs
 Materiel/Material: Glulam - Southern Pine

DATE: 24.07.2009
 By: R.D.
 Checked: J.M.
Goodfellow inc,
 225, Goodfellow Street
 DELSON, QUEBEC, J5B 1V5
 Tel.: 450-635-6511 Fax: 450-635-8304
 www.goodfellowinc.com