


STATE OF VERMONT AGENCY OF TRANSPORTATION

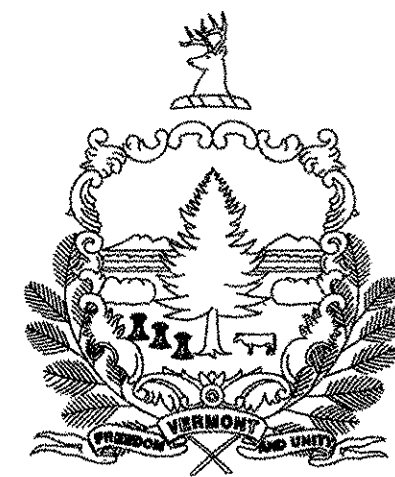



PROPOSED IMPROVEMENT BRIDGE PROJECT

TOWN OF PROCTOR - PITTSFORD
COUNTY OF RUTLAND
ROUTE NO : 6 BRIDGE NO : 4

PROJECT LOCATION : LOCATED IN THE COUNTY OF RUTLAND , TOWNS OF PROCTOR AND PITTSFORD, ON TOWN HIGHWAY 6 , BRIDGE 4
AT THE INTERSECTION OF TOWN HIGHWAY 6 (IN PROCTOR) AND TOWN HIGHWAY 14 (IN PITTSFORD).

PROJECT DESCRIPTION : THE PROJECT SHALL CONSIST OF THE REHABILITATION OF BRIDGE #4 (GORHAM COVERED BRIDGE), WITH NEW ABUTMENTS
AND RELATED APPROACH AND CHANNEL WORK



LENGTH OF STRUCTURE : 117.00 FEET.
LENGTH OF ROADWAY : 158.00 FEET.
LENGTH OF PROJECT : 275.00 FEET.

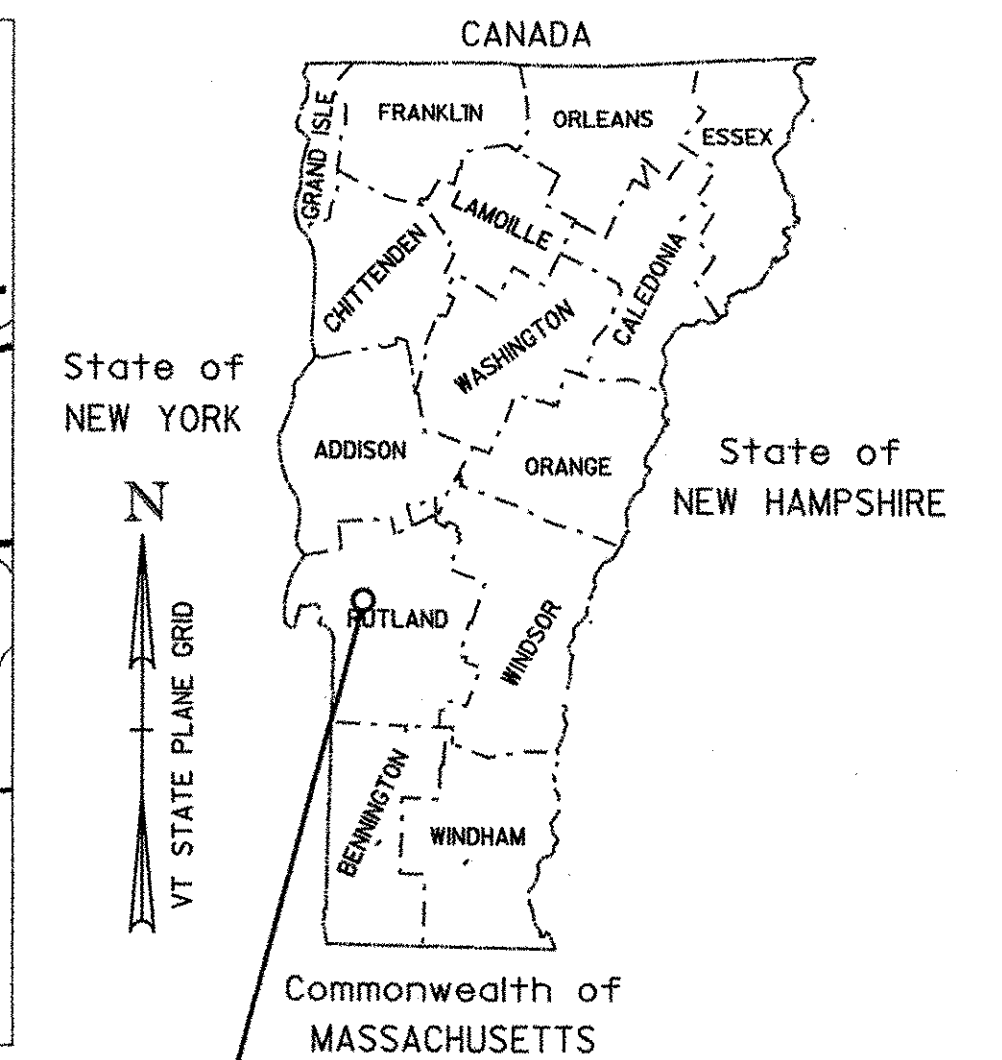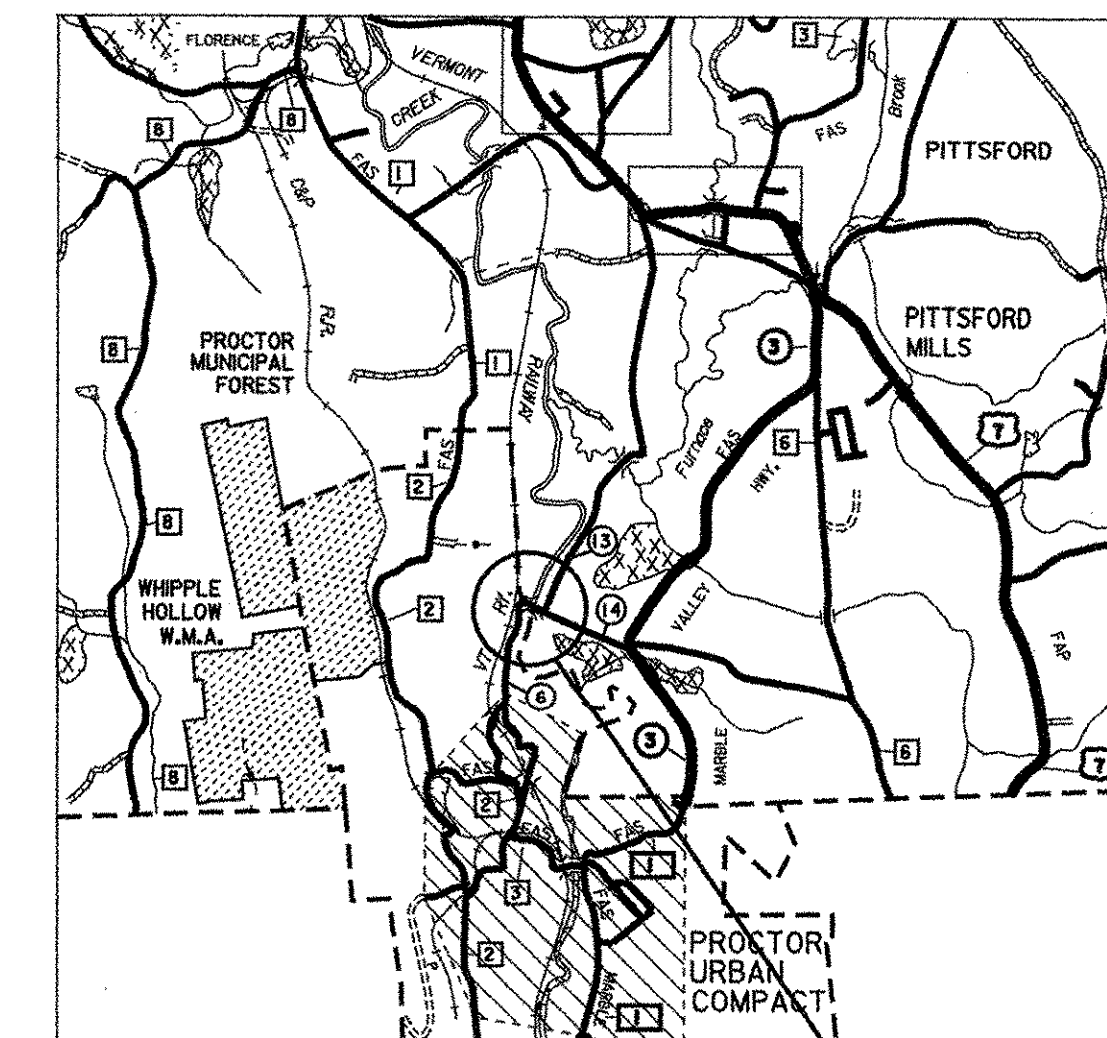

PROJECT LOCATION
PROCTOR - PITTSFORD
BHO 1443 (37)

INDEX OF SHEETS

1. TITLE SHEET
2. INDEX OF SHEETS & STANDARDS

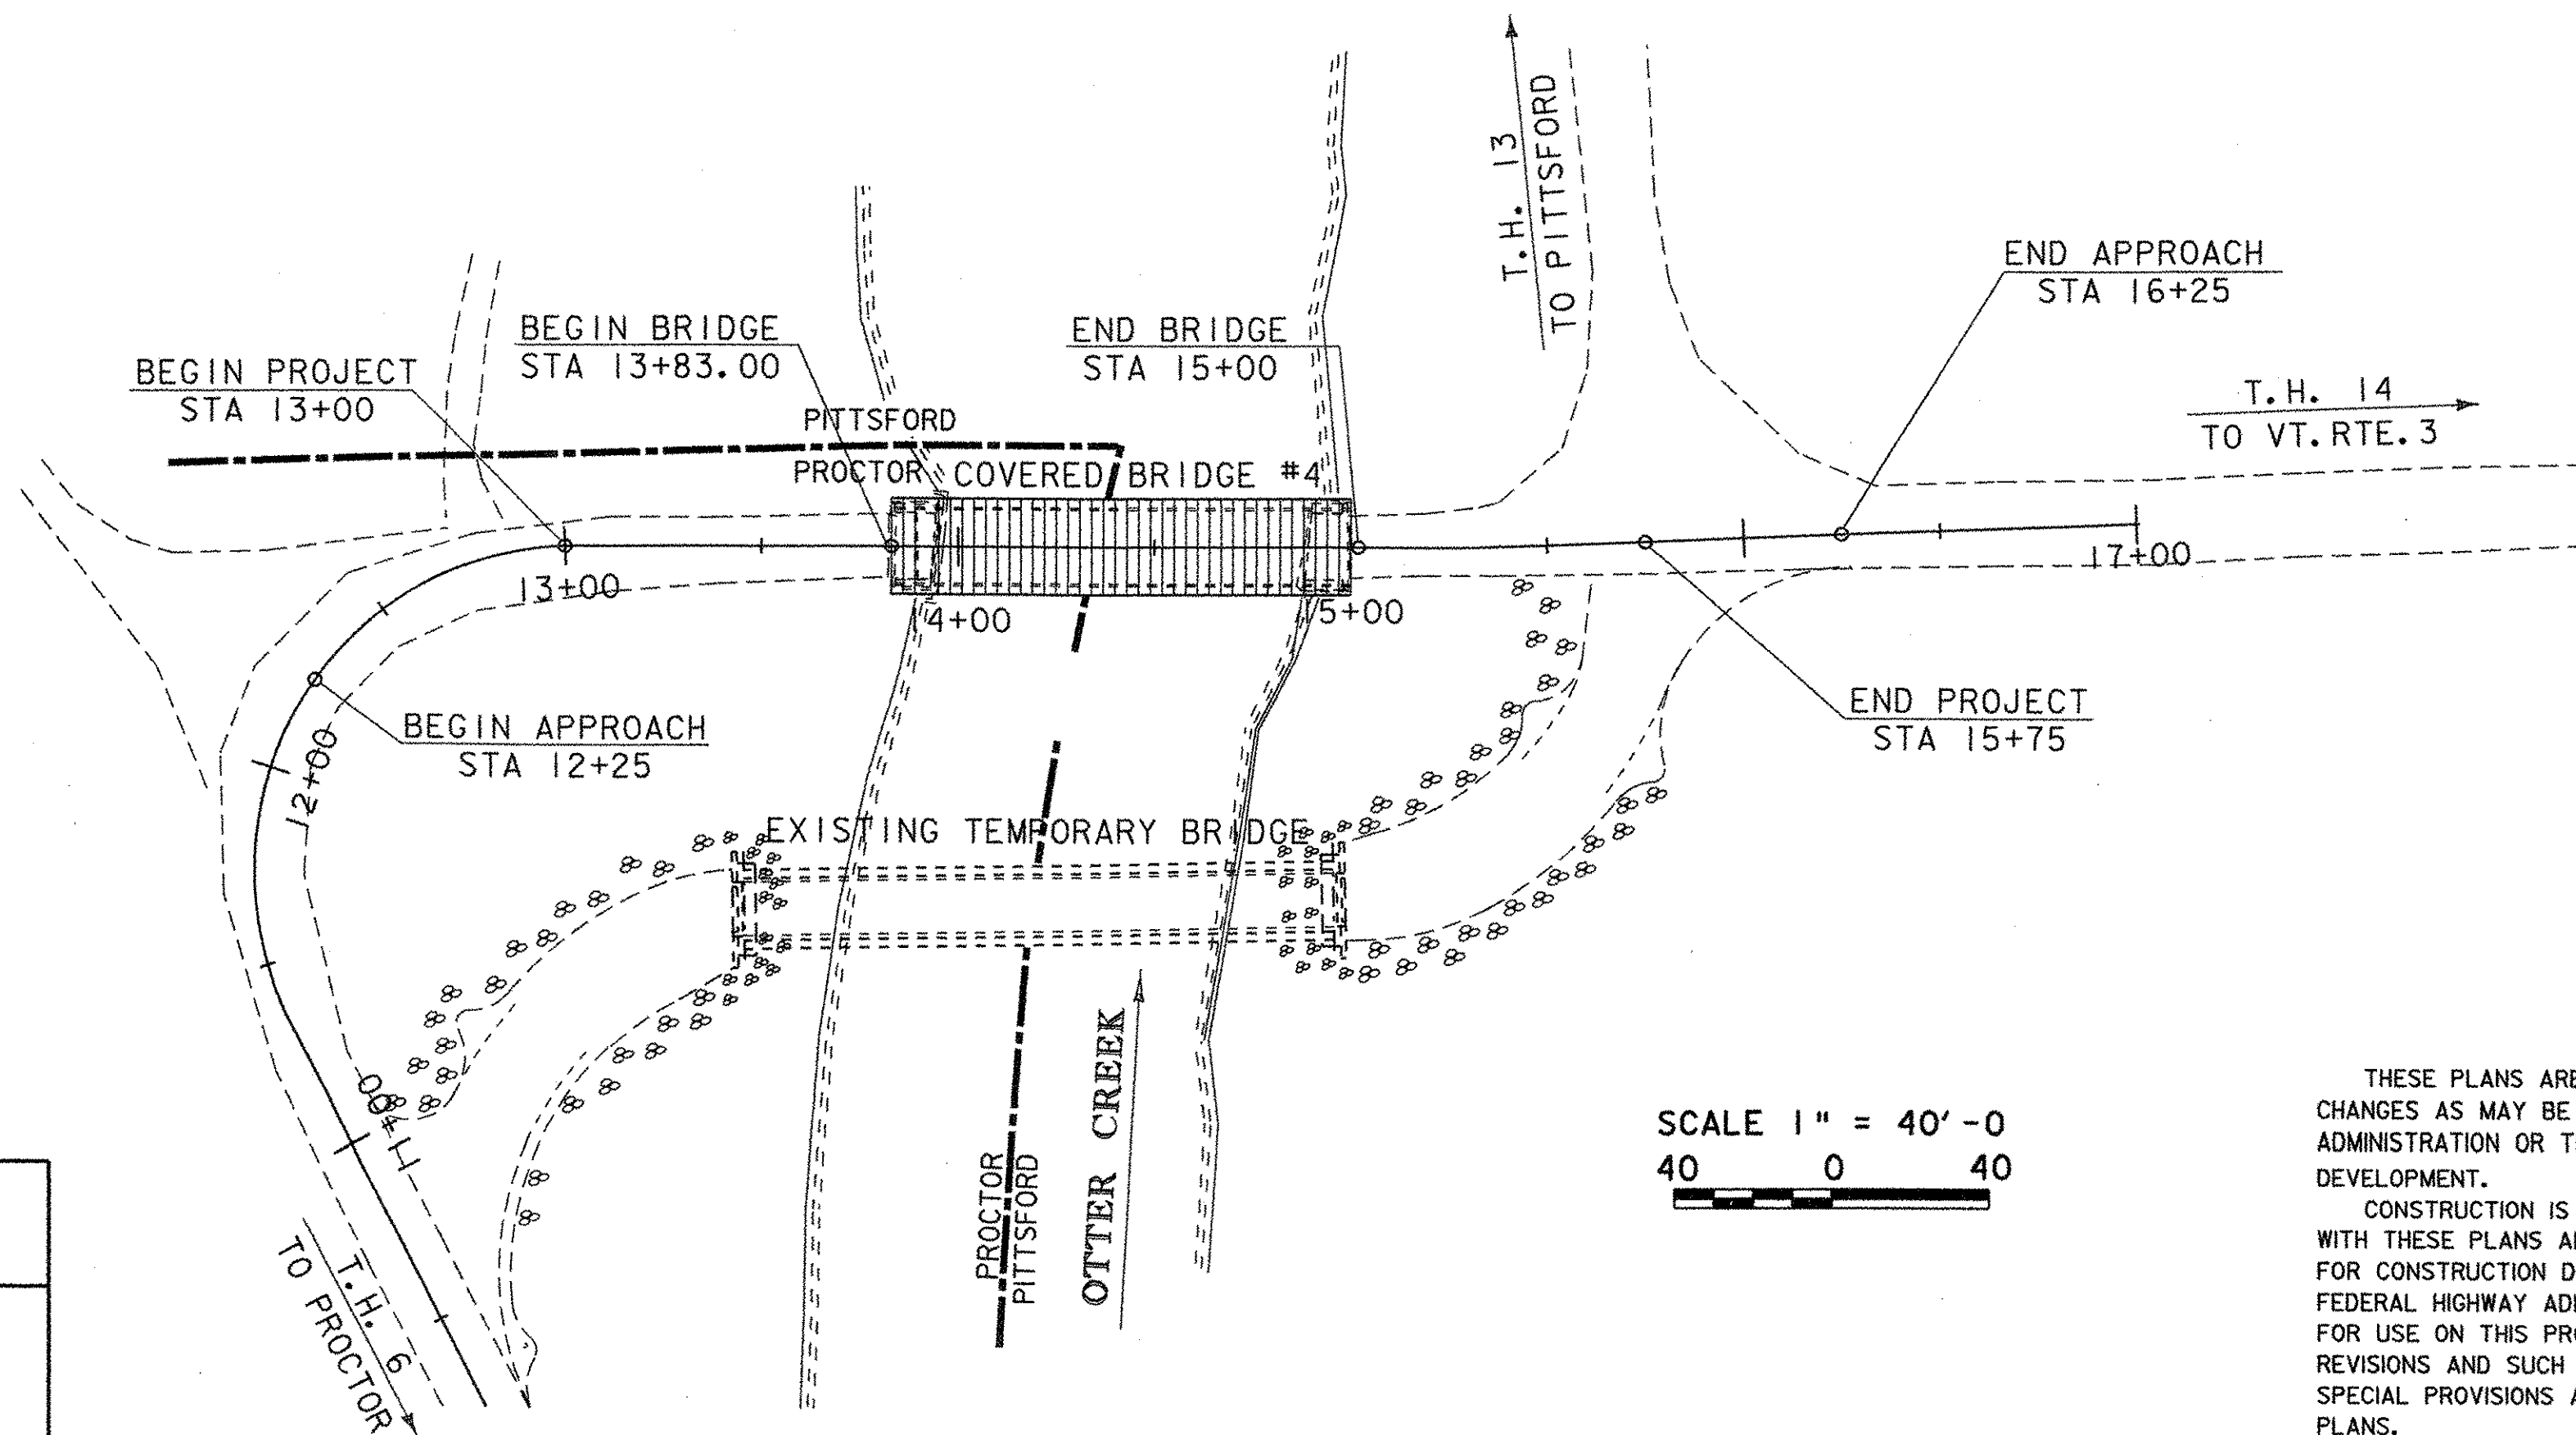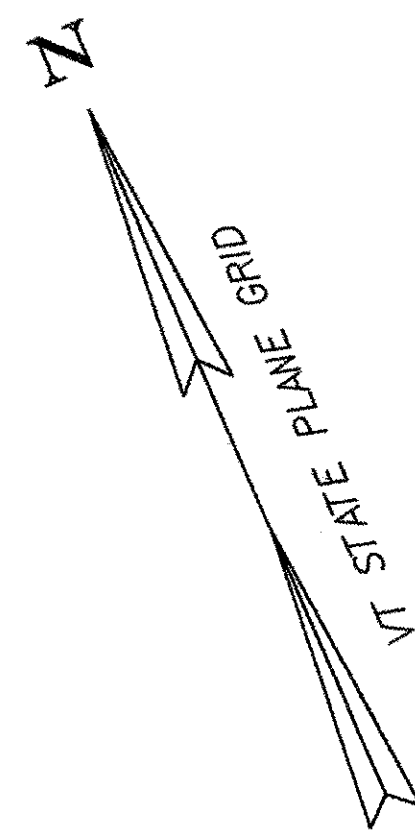

SCALE 1" = 40'-0"
40 0 40

RECORD PLANS	
CONTRACTOR:	CONTRACTOR CRANE SERVICE - MORRISVILLE, VT
RESIDENT ENGINEER:	TONY COURSE
CONSTRUCTION BEGAN:	APRIL 7, 2003
CONSTRUCTION COMPLETE:	OCTOBER 14, 2004
RECORD PLANS BY:	TONY COARSE, N. GARBACIK
I HEREBY CERTIFY THAT ALL THE CONSTRUCTION REQUIRED BY THIS SET OF DRAWINGS HAS BEEN ACCOMPLISHED AS INDICATED HEREIN.	
BY <i>Mark H. Mackintosh</i> For the RESIDENT ENGINEER	
DATE <u>Jan 29, 2008</u>	
NOTE: Any further information concerning final quantities, amounts or other details relative to this project may be found at Central Files in the electronic archives.	

CONVENTIONAL SYMBOLS	
COUNTY LINE	
TOWN LINE	
LIMITS OF ACCESS	
POINT OF ACCESS	
FENCE LINE	
STONE WALL	
TRAVELED WAY	
GUARD RAIL	
RAILROAD	
SURVEY LINE	
CULVERT	
POWER POLE	
TELEPHONE POLE	
TREES	
CONTROL OF ACCESS	
PROPERTY LINE	
R.O.W. TAKING LINE	
SLOPE RIGHTS	
TOP OF CUT	
TOE OF SLOPE	

SURVEYED BY : L. ORVIS
SURVEYED DATE : 02-02-98

DATUM
VERTICAL NAVD 88
HORIZONTAL NAD 83/92

THESE PLANS ARE SUBJECT TO SUCH ENGINEERING CHANGES AS MAY BE REQUIRED BY THE FEDERAL HIGHWAY ADMINISTRATION OR THE DIRECTOR OF PROJECT DEVELOPMENT.

CONSTRUCTION IS TO BE CARRIED ON IN ACCORDANCE WITH THESE PLANS AND THE STANDARD SPECIFICATIONS FOR CONSTRUCTION DATED 2001, AS APPROVED BY THE FEDERAL HIGHWAY ADMINISTRATION ON JANUARY 4, 2001 FOR USE ON THIS PROJECT, INCLUDING ALL SUBSEQUENT REVISIONS AND SUCH REVISED SPECIFICATIONS AND SPECIAL PROVISIONS AS ARE INCORPORATED IN THESE PLANS.

DEPARTMENT OF TRANSPORTATION FEDERAL HIGHWAY ADMINISTRATOR	
APPROVED <i>Mark J. Rafter</i>	DATE 1-10-2003
DIRECTOR OF PROJECT DEVELOPMENT	
APPROVED <i>[Signature]</i>	DATE 10/25/02
PROJECT MANAGER : C. P. WILLIAMS	
PROJECT NAME : PROCTOR - PITTSFORD	
PROJECT NUMBER : BHO 1443 (37)	
SHEET 1 OF 60 SHEETS	