



# Profile

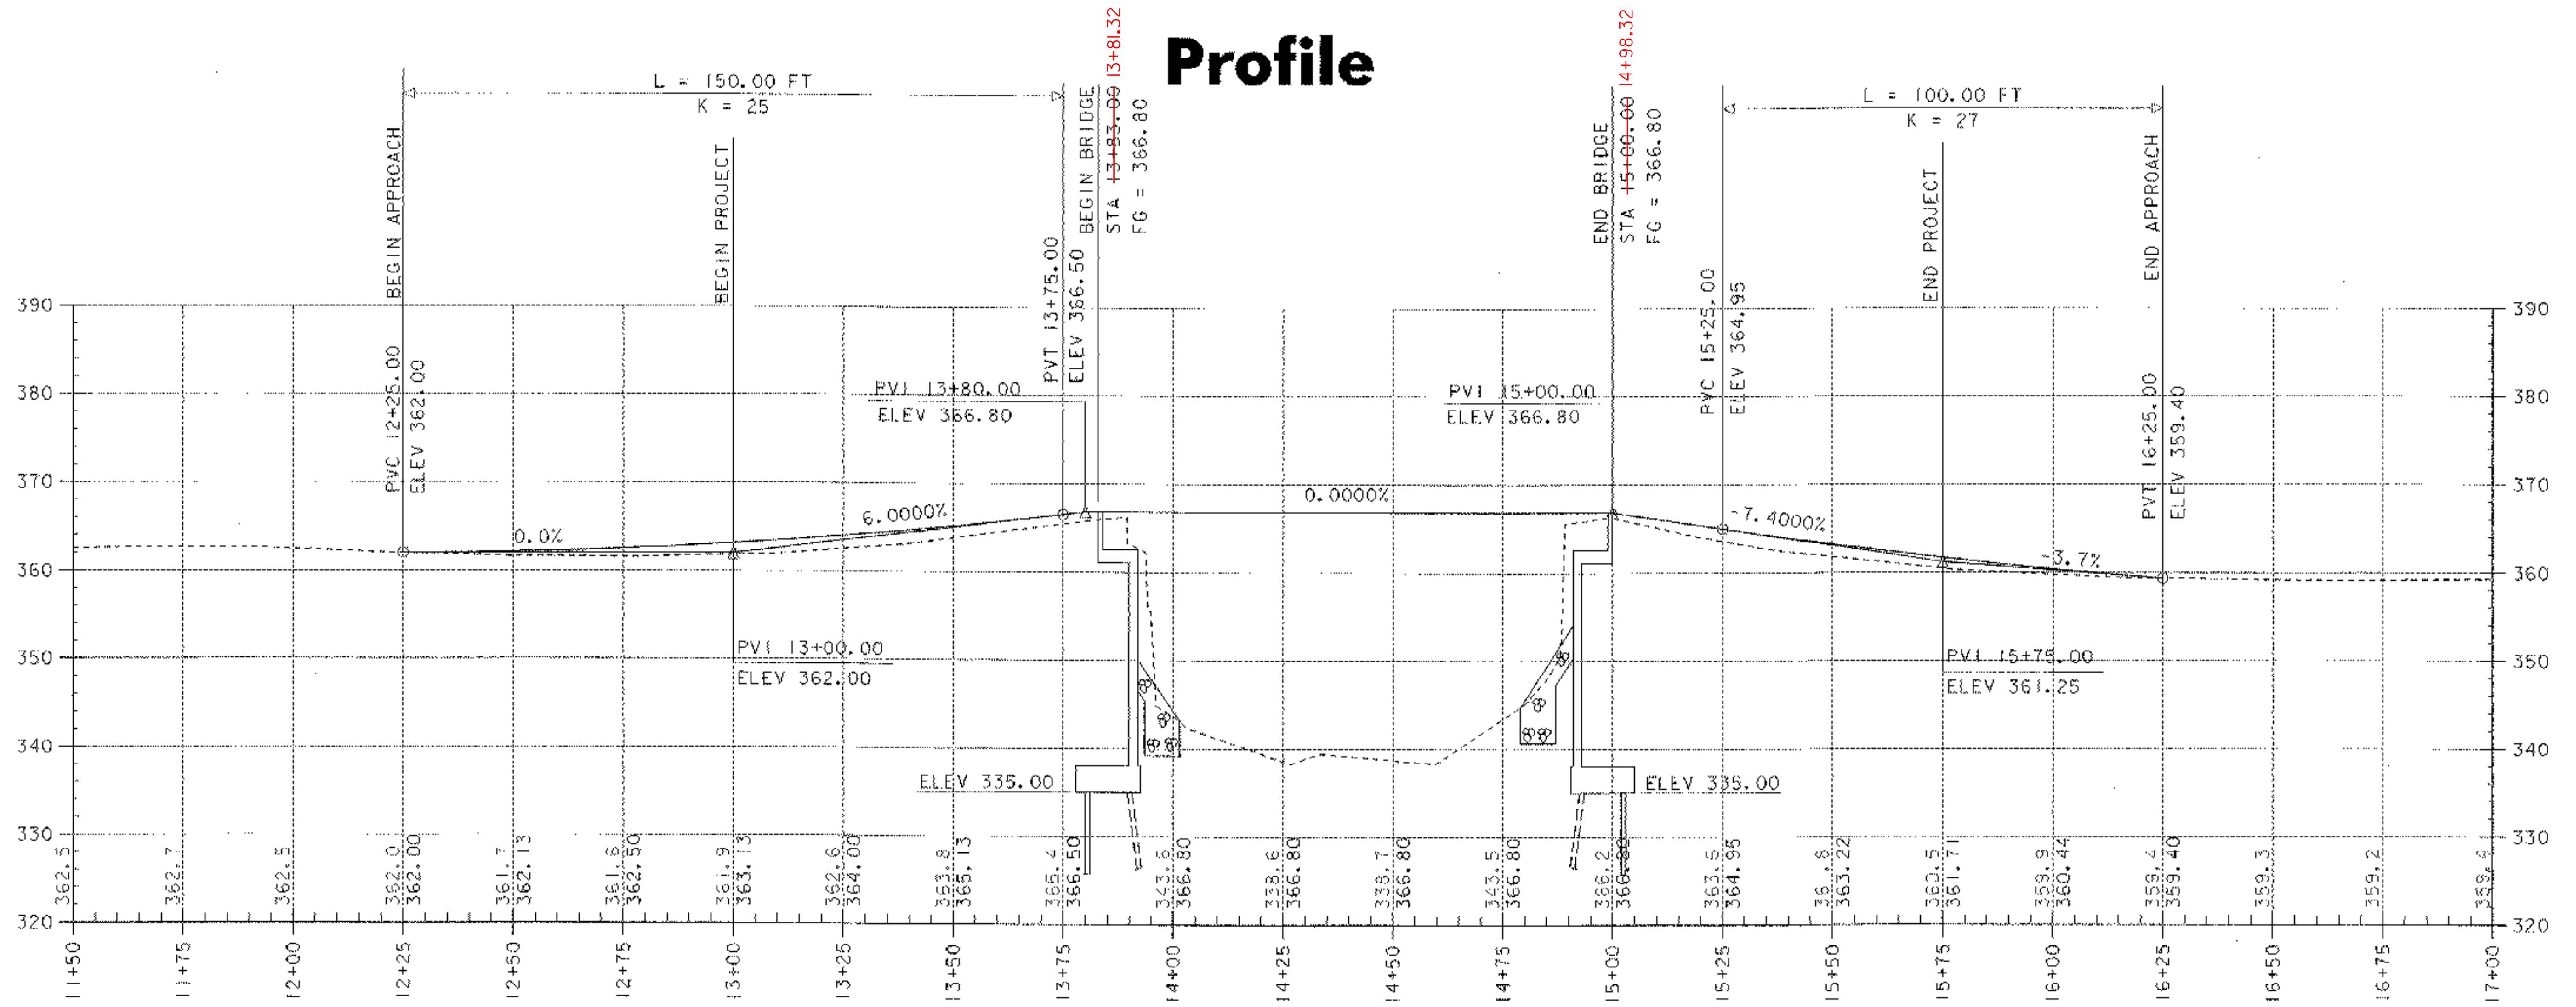

EXISTING ELEVATIONS -----  
 ELEVATIONS SHOWN TO THE NEAREST TENTH

PROPOSED ELEVATIONS \_\_\_\_\_  
 ELEVATIONS SHOWN TO THE NEAREST HUNDRETH

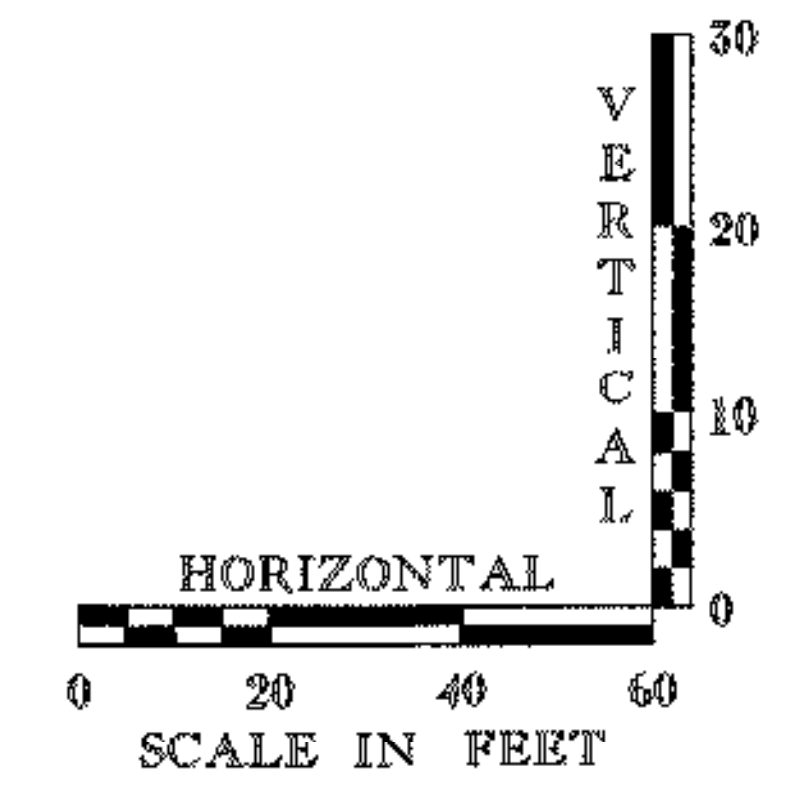

DATUM	
VERTICAL	NAVD 88
HORIZONTAL	NDA 83/92

PROJECT:	PROCTOR - PITTSFORD	PROJECT NO.:	BHO 1443 (37)
DESIGN FILE NAME:	96\242\structures\sj242epro.dgn	PLOT DATE:	10-JAN-2003
IPARM FILE NAME:	sj242epro.i	SURVEY DATE:	02-02-98
SURVEYED BY:	L. ORVIS	DRAWN BY:	W.B. SYMONDS
SQUAD LEADER:	C.P. WILLIAMS	SHEET:	8 OF 60
PROFILE SHEET			