


REHABILITATED TYPICAL BRIDGE SECTION

SCALE 3/4" = 1'-0"

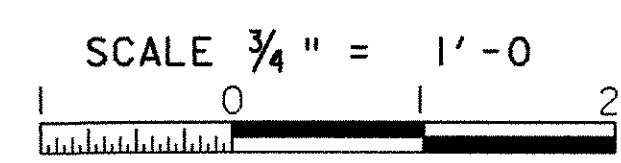

* THESE DIMENSIONS ASSUMED FOR DESIGN. THESE DIMENSIONS MAY VARY AND SHALL BE VERIFIED BY THE CONTRACTOR.

PROJECT: PROCTOR - PITTSFORD	PROJECT NO. : BHO 1443 (37)
DESIGN FILE NAME: 96j242\Structures\sj242ebr typ. dgn	PLOT DATE: 10-JAN-2003
IPARM FILE NAME: sj242ebr typ. i	DRAWN BY: T. ANDERSON
DESIGNED BY: W.B. SYMONDS	CHECKED BY: W.B. SYMONDS
SQUAD LEADER: C.P. WILLIAMS	SHEET: 17 OF 60
TYPICAL BRIDGE SECTION	